

8502777P

WW-7
8-30-06



West Virginia Department of Environmental Protection
Office of Oil and Gas
WELL LOCATION FORM: GPS

API: 47-085-02777 WELL NO.: Freshour 2

FARM NAME: Orpha Freshour

RESPONSIBLE PARTY NAME: Hayden Harper Energy KA, LLC

COUNTY: Ritchie DISTRICT: Union

QUADRANGLE: Burnt House WV 7 1/2' Series

SURFACE OWNER: John W Freshour

ROYALTY OWNER: John W Freshour

UTM GPS NORTHING: 4325396.67

UTM GPS EASTING: 508523.58 GPS ELEVATION: 361.04 1076 FT

The Responsible Party named above has chosen to submit GPS coordinates in lieu of preparing a new well location plat for a plugging permit or assigned API number on the above well. The Office of Oil and Gas will not accept GPS coordinates that do not meet the following requirements:

1. Datum: NAD 1983, Zone: 17 North, Coordinate Units: meters, Altitude: height above mean sea level (MSL) – meters.
2. Accuracy to Datum – 3.05 meters
3. Data Collection Method:
Survey grade GPS XX : Post Processed Differential XX

Real-Time Differential _____

Mapping Grade GPS _____ : Post Processed Differential _____

Real-Time Differential _____

4. **Letter size copy of the topography map showing the well location.**

I the undersigned, hereby certify this data is correct to the best of my knowledge and belief and shows all the information required by law and the regulations issued and prescribed by the Office of Oil and Gas.


[Signature]
Signature

PS 1065
Title

12/2/13
Date

RECEIVED
Office of Oil and Gas
12/2/13
West Virginia Department of Environmental Protection
Office of Oil and Gas

8502777A

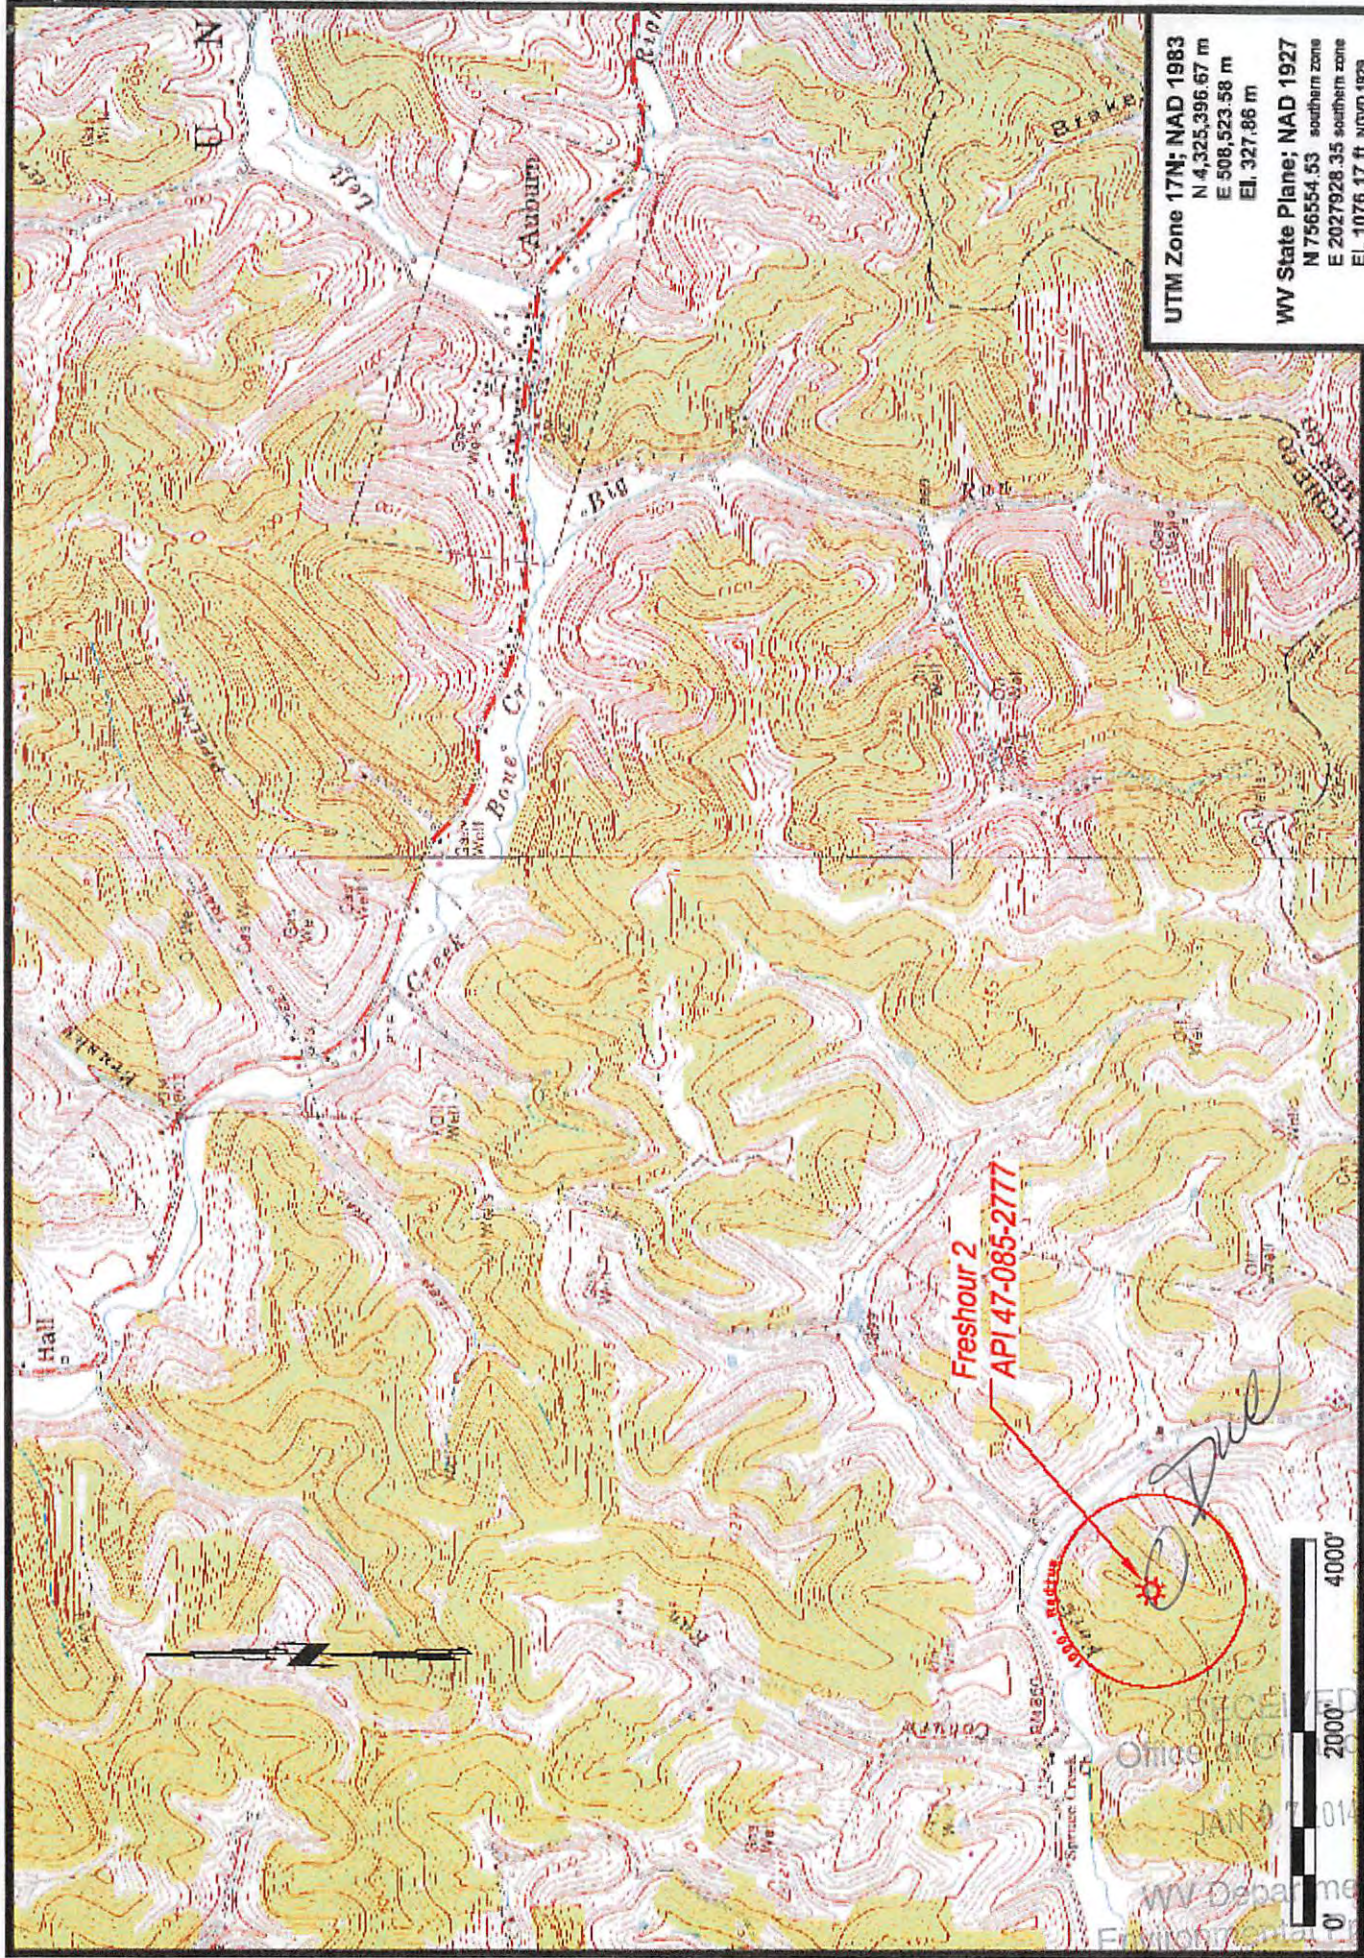

UTM Zone 17N; NAD 1983
 N 4,325,396.67 m
 E 506,523.58 m
 El. 327.86 m

WV State Plane; NAD 1927
 N 756554.53 southern zone
 E 2027928.35 southern zone
 El. 1076.47 ft. NAD 1927

Geodetic Lat./Long. WGS84
 Lat 39° 04' 39.5"
 Long -80° 54' 05.3"

November 25, 2013
 API 47-085-02777
 Located near Auburn in Union District of Ritchie County, West Virginia

Freshour 2



WV Department of Environmental Protection