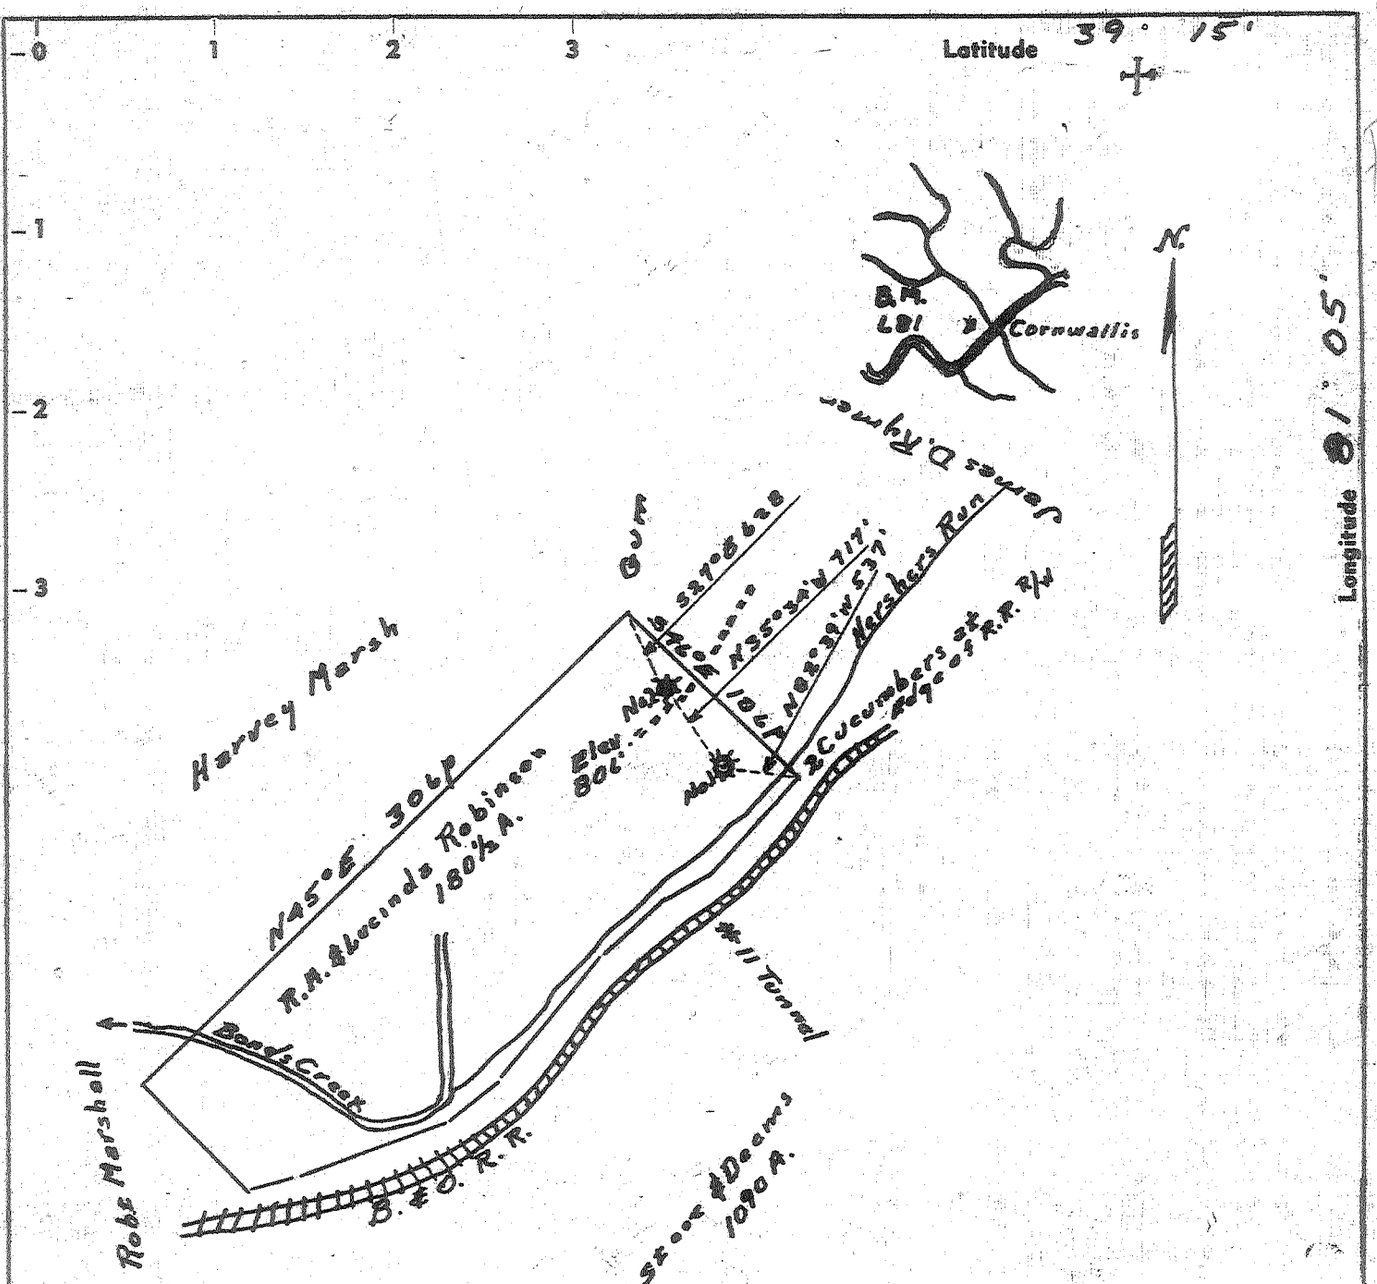

I, the undersigned, hereby certify that this map is correct to the best of my knowledge and belief and shows all the information required by paragraph 6 of the rules and regulations of the oil and gas section of the mining laws of West Virginia.

Hydrofeacture
New Location . ☐
Drill Deeper .... ☐
Redrill ..... ☐
Abandonment ..... ☐

MINIMUM ERROR OF CLOSURE 1' IN 200'

Company Central West Virginia Producers
Address Grantsville, W.Va. c/o W.H.Busch
Farm R.A. & Lucindia Robinson
Tract Acres 180½ Lease No.
Well (Farm) No. 2 Serial No.
Elevation (Spirit Level) 806'
Quadrangle Harrisville -NC
County Ritchie District Grant
Engineer Logan McDonald
Engineer's Registration No. 610
File No. Drawing No.
Date Oct. 19, 64 Scale 1" = 80 Rods

STATE OF WEST VIRGINIA
DEPARTMENT OF MINES
OIL AND GAS DIVISION
CHARLESTON

WELL LOCATION MAP

FILE NO. Rit-2964-Frac.

+ Denotes location of well on United States Topographic Maps, scale 1 to 62,500, latitude and longitude lines being represented by border lines as shown.

— Denotes one inch spaces on border line of original tracing.

ALLEN BLUEPRINT & SUPPLY CO.