



West Virginia Department of Environmental Protection
Office of Oil and Gas
WELL LOCATION FORM: GPS

API: 47-085-03949 P WELL NO.: WV 654381 (S. M. Grimm #1109)
FARM NAME: S. M. Grimm
RESPONSIBLE PARTY NAME: EQT Production Company
COUNTY: Ritchie DISTRICT: Union
QUADRANGLE: Pullman 7.5'
SURFACE OWNER: Samuel & Charlotte Grimm
ROYALTY OWNER: Jessie Jeanette Wilburn, et al.
UTM GPS NORTHING: 4335217
UTM GPS EASTING: 505467 GPS ELEVATION: 255 m (838 ft)

The Responsible Party named above has chosen to submit GPS coordinates in lieu of preparing a new well location plat for a plugging permit or assigned API number on the above well. The Office of Oil and Gas will not accept GPS coordinates that do not meet the following requirements:

- Datum: NAD 1983, Zone: 17 North, Coordinate Units: meters, Altitude: height above mean sea level (MSL) – meters.
- Accuracy to Datum – 3.05 meters
- Data Collection Method:
Survey grade GPS : Post Processed Differential
Real-Time Differential
Mapping Grade GPS X : Post Processed Differential X
Real-Time Differential
- Letter size copy of the topography map showing the well location.**

I the undersigned, hereby certify this data is correct to the best of my knowledge and belief and shows all the information required by law and the regulations issued at **Office of Oil & Gas** prescribed by the Office of Oil and Gas.

Received
APR 08 2015

Signature

PS# 2180
Title

3/27/15
Date


Topo Quad: Pullman 7.5' Scale: 1" = 2000'

County: Ritchie Date: March 24, 2015

District: Union Project No: 68-38-00-08

47-085-03949P WV 654381 (S. M. Grimm #1109)

Topo

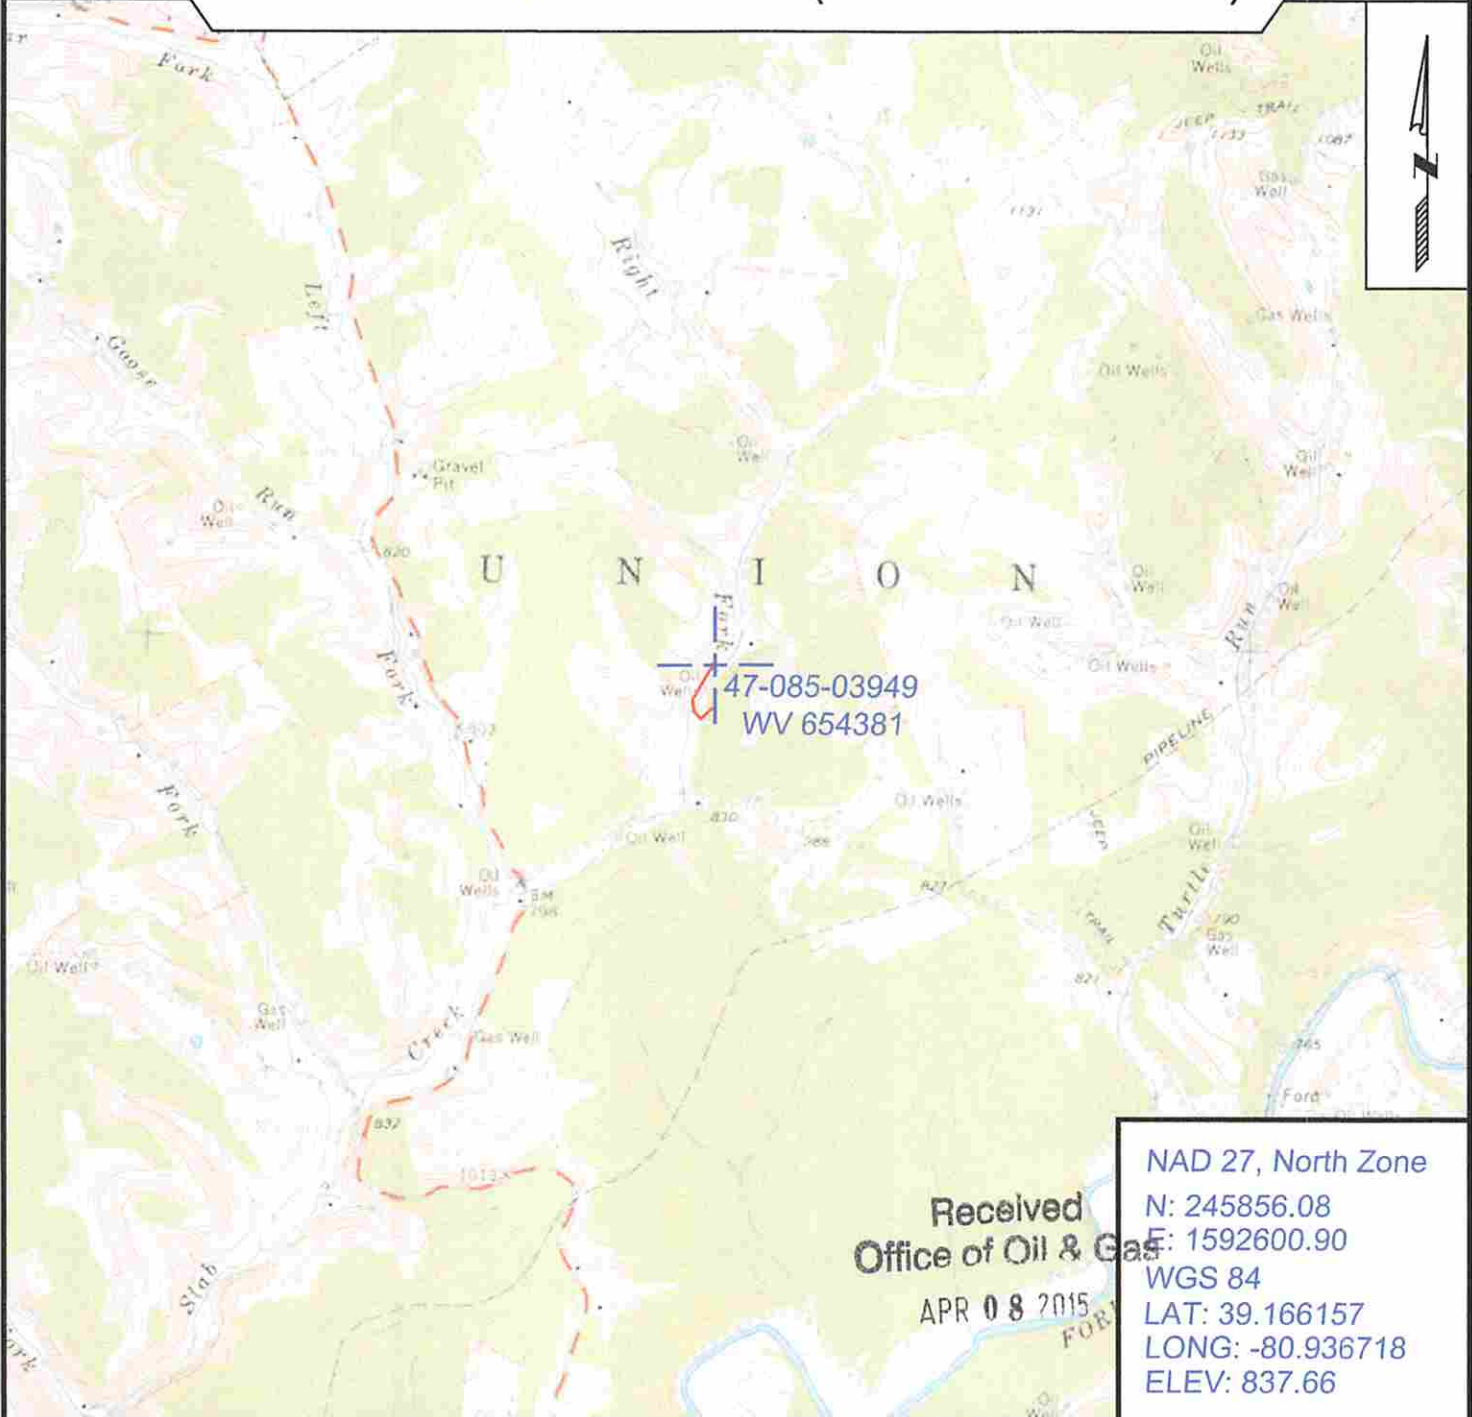

Received
Office of Oil & Gas

APR 08 2015

NAD 27, North Zone
 N: 245856.08
 E: 1592600.90
 WGS 84
 LAT: 39.166157
 LONG: -80.936718
 ELEV: 837.66



SURVEYING AND MAPPING SERVICES PERFORMED BY:

ALLEGHENY SURVEYS, INC.

1-800-482-8606
 237 Birch River Road
 Birch River, WV 26610
 PH: (304) 649-8606
 FAX: (304) 649-8608

PREPARED FOR:

EQT Production Company

P.O. Box 280
 Bridgeport, WV 26330

06/12/2015