

WW-7
8-30-06



85-03993 P
RECEIVED
Office of Oil and Gas
NOV 22 2017
WV Department of
Environmental Protection

West Virginia Department of Environmental Protection
Office of Oil and Gas
WELL LOCATION FORM: GPS

API: 47-085-03993 WELL NO.: WV 604838 (Smith #4838)

FARM NAME: J. P. Smith

RESPONSIBLE PARTY NAME: EQT Production Company

COUNTY: Ritchie DISTRICT: Union

QUADRANGLE: Auburn 7.5'

SURFACE OWNER: Jerry Allen Riddle, et al.

ROYALTY OWNER: Jerry Allen Riddle, et al.

UTM GPS NORTHING: 4330501

UTM GPS EASTING: 513309 GPS ELEVATION: 334 m (1097 ft)

The Responsible Party named above has chosen to submit GPS coordinates in lieu of preparing a new well location plat for a plugging permit or assigned API number on the above well. The Office of Oil and Gas will not accept GPS coordinates that do not meet the following requirements:

1. Datum: NAD 1983, Zone: 17 North, Coordinate Units: meters, Altitude: height above mean sea level (MSL) – meters.
2. Accuracy to Datum – 3.05 meters
3. Data Collection Method:

Survey grade GPS _____ : Post Processed Differential _____
Real-Time Differential _____
Mapping Grade GPS X : Post Processed Differential X
Real-Time Differential _____

4. **Letter size copy of the topography map showing the well location.**

I the undersigned, hereby certify this data is correct to the best of my knowledge and belief and shows all the information required by law and the regulations issued and prescribed by the Office of Oil and Gas.

Signature

PS # 2180
Title

10/26/17
Date

05/11/2018

Topo Quad: Auburn 7.5'

Scale: 1" = 2000'

RECEIVED
Office of Oil and Gas

County: Ritchie

Date: October 19, 2017

NOV 22 2017

District: Union


Project No: 68-38-00-08

WV Department of
Environmental Protection

Water

47-085-03993 WV 604838 (Smith #4838)

No Potential Water Sources within 1000'

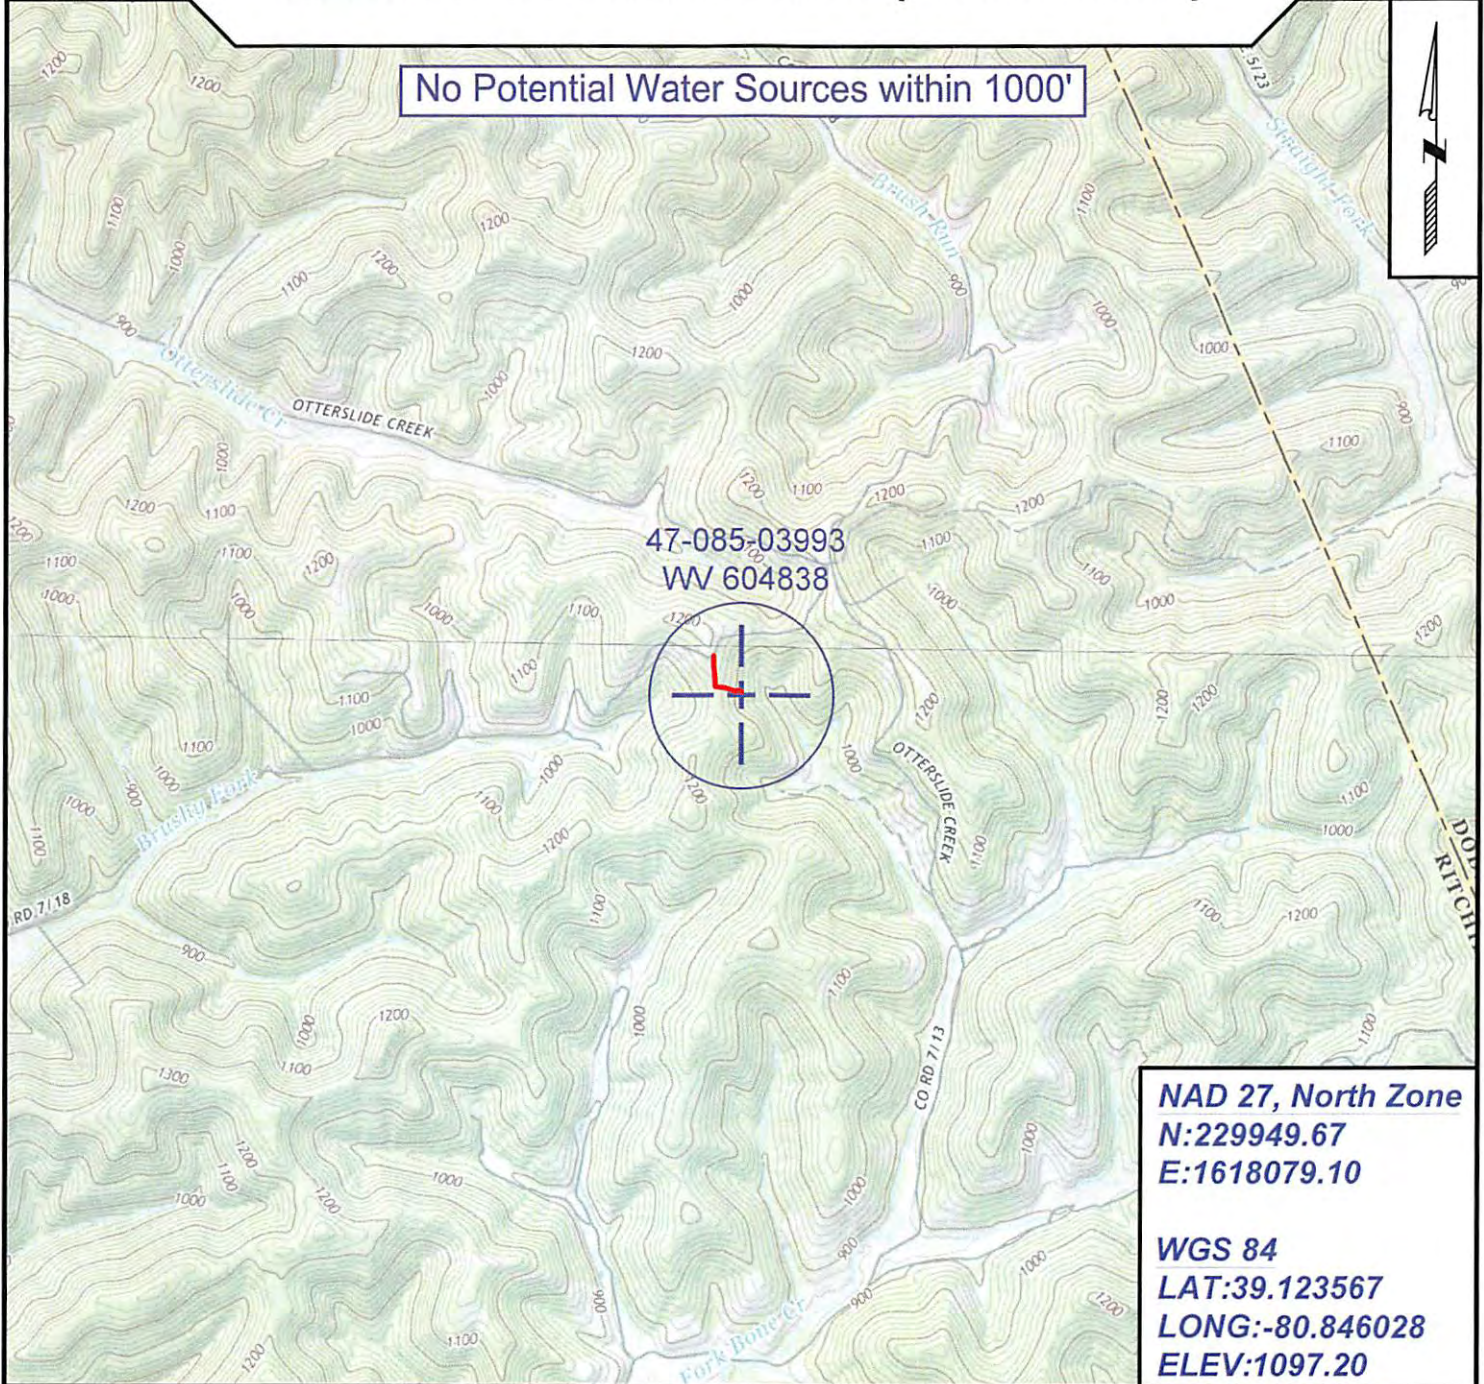

47-085-03993
WV 604838

NAD 27, North Zone
N:229949.67
E:1618079.10

WGS 84
LAT:39.123567
LONG:-80.846028
ELEV:1097.20



SURVEYING AND MAPPING SERVICES PERFORMED BY:

ALLEGHENY SURVEYS, INC.

1-800-482-8606
237 Birch River Road
Birch River, WV 26610
PH: (304) 649-8606
FAX: (304) 649-8608

PREPARED FOR:

EQT Production Company

P.O. Box 280
Bridgeport, WV 26330

05/11/2018