



West Virginia Department of Environmental Protection  
Office of Oil and Gas  
**WELL LOCATION FORM: GPS**

**API:** 47-085-04003 P **WELL NO.:** WV 604942 (E. Britton #4942)

**FARM NAME:** Britton

**RESPONSIBLE PARTY NAME:** EQT Production Company

**COUNTY:** Ritchie **DISTRICT:** Union

**QUADRANGLE:** Oxford 7.5'

**SURFACE OWNER:** John L. and Karen J. Sampson

**ROYALTY OWNER:** Connie G. Shaw, et al.

**UTM GPS NORTHING:** 4334041

**UTM GPS EASTING:** 512232 **GPS ELEVATION:** 299 m (981 ft)

The Responsible Party named above has chosen to submit GPS coordinates in lieu of preparing a new well location plat for a plugging permit or assigned API number on the above well. The Office of Oil and Gas will not accept GPS coordinates that do not meet the following requirements:

1. Datum: NAD 1983, Zone: 17 North, Coordinate Units: meters, Altitude: height above mean sea level (MSL) – meters.
2. Accuracy to Datum – 3.05 meters
3. Data Collection Method:  
 Survey grade GPS     : Post Processed Differential       
   Real-Time Differential       
 Mapping Grade GPS X: Post Processed Differential X  
   Real-Time Differential

4. **Letter size copy of the topography map showing the well location.**

I the undersigned, hereby certify this data is correct to the best of my knowledge and belief and shows all the information required by law and the regulations issued and prescribed by the Office of Oil and Gas.

Stacy O'Brien  
Signature

PS# 2180  
Title

3/27/15  
Date

Received  
Office of Oil & Gas

APR 08 2015

06/12/2015

47 08 50 40 03

Topo Quad: Oxford 7.5'

Scale: 1" = 2000'

County: Ritchie


Date: March 23, 2015

District: Union

Project No: 68-38-00-08

47-085-04003 **P**WV 604942 (E. Britton #4942)

Topo

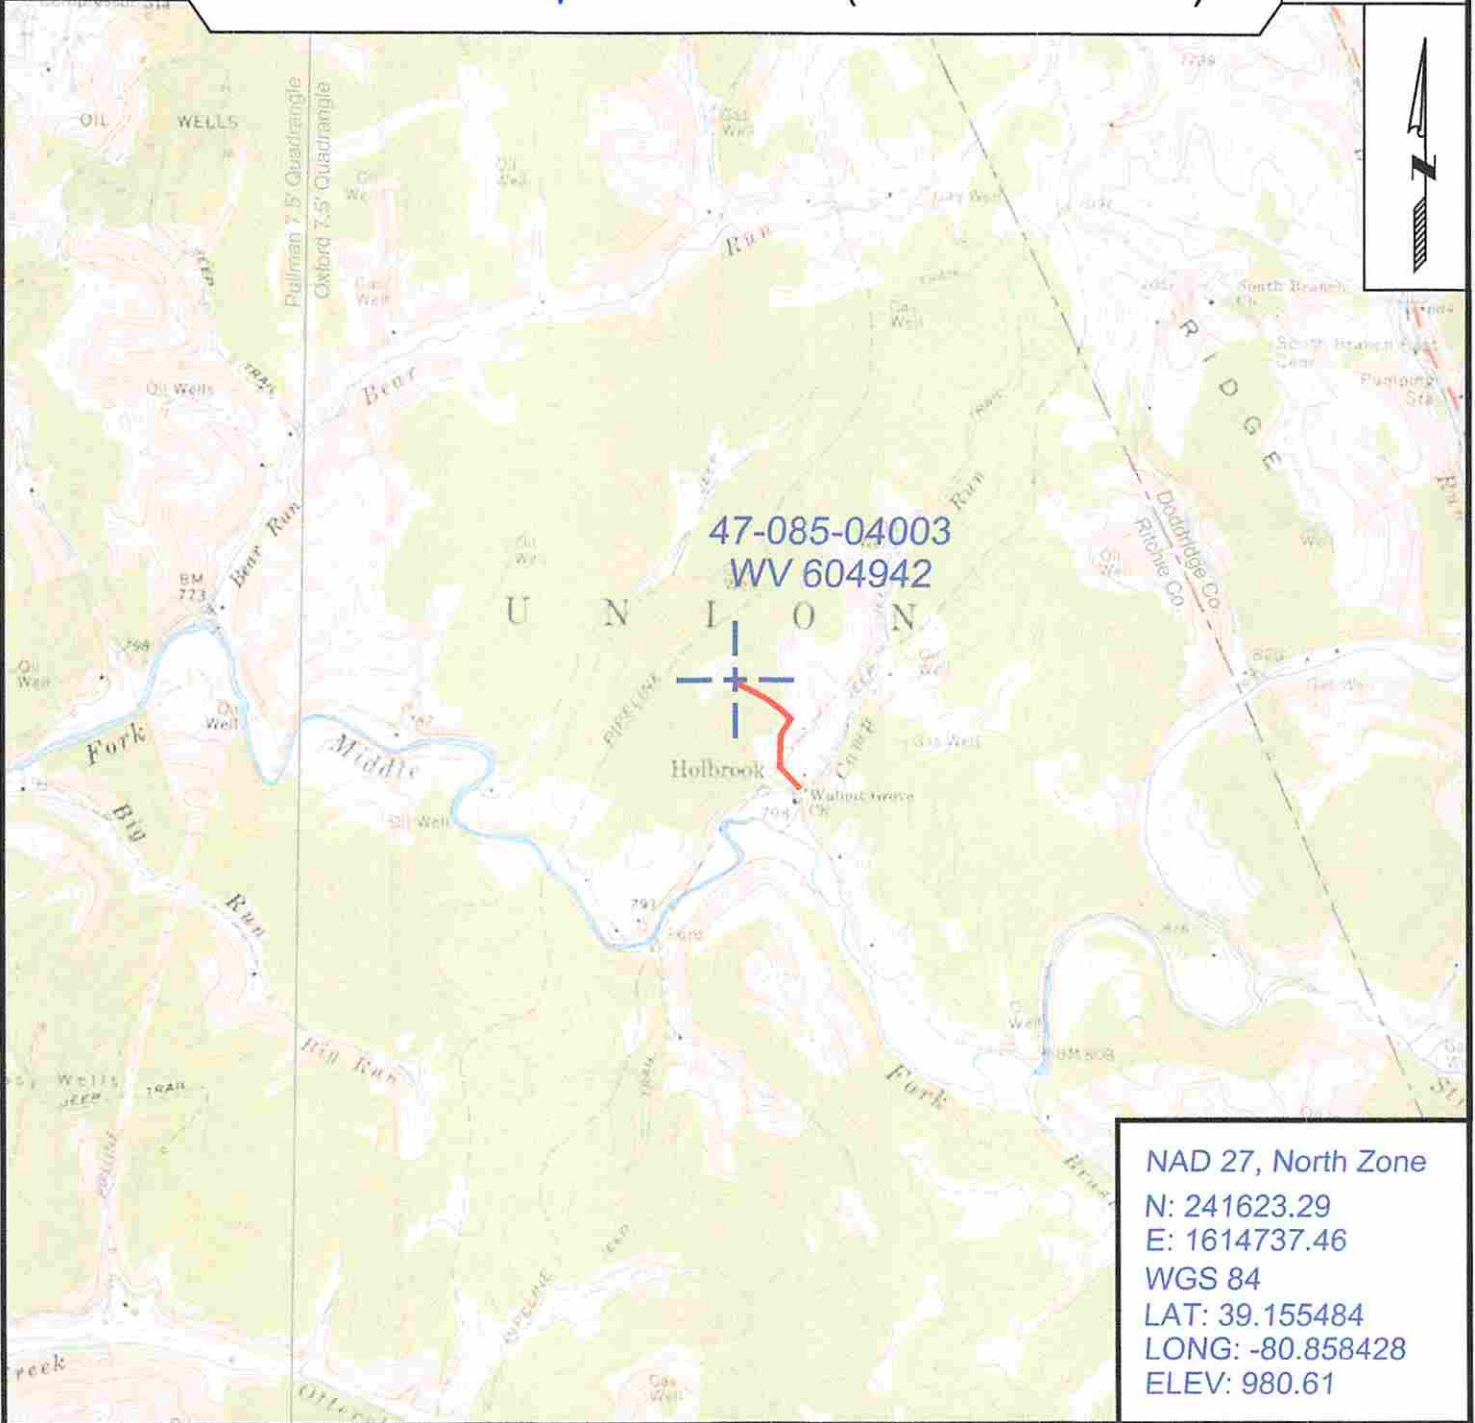

47-085-04003  
WV 604942

NAD 27, North Zone  
 N: 241623.29  
 E: 1614737.46  
 WGS 84  
 LAT: 39.155484  
 LONG: -80.858428  
 ELEV: 980.61



SURVEYING AND MAPPING SERVICES PERFORMED BY:

**ALLEGHENY SURVEYS, INC.**

1-800-482-8606  
 237 Birch River Road  
 Birch River, WV 26610  
 PH: (304) 649-8606  
 FAX: (304) 649-8608

PREPARED FOR:

Received  
**EQT Production Company** & Gas  
 Office of Oil & Gas  
 P.O. Box 280  
 Bridgeport, WV 26330  
 APR 08 2015

06/12/2015