

WW-7
8-30-06



West Virginia Department of Environmental Protection
Office of Oil and Gas
WELL LOCATION FORM: GPS

API: 47-085-05434 WELL NO.: 1188

FARM NAME: Willingham

RESPONSIBLE PARTY NAME: Prime Operating Company

COUNTY: Ritchie DISTRICT: Grant

QUADRANGLE: Petroleum

SURFACE OWNER: Peggy, Max and Steve Burnside

ROYALTY OWNER: Charles Willingham

UTM GPS NORTHING: 4335934.78

UTM GPS EASTING: 477914.21 GPS ELEVATION: 902' (274m)

The Responsible Party named above has chosen to submit GPS coordinates in lieu of preparing a new well location plat for a plugging permit or assigned API number on the above well. The Office of Oil and Gas will not accept GPS coordinates that do not meet the following requirements:

1. Datum: NAD 1983, Zone: 17 North, Coordinate Units: meters, Altitude: height above mean sea level (MSL) – meters.
2. Accuracy to Datum – 3.05 meters
3. Data Collection Method:

Survey grade GPS : Post Processed Differential

Real-Time Differential

Mapping Grade GPS : Post Processed Differential

Real-Time Differential

Received

NOV 26 2013

Office of Oil and Gas
WV Dept. of Environmental Protection

4. Letter size copy of the topography map showing the well location.

I the undersigned, hereby certify this data is correct to the best of my knowledge and belief and shows all the information required by law and the regulations issued and prescribed by the Office of Oil and Gas.

Halsey M.
Whitney

Digitally signed by Halsey M. Whitney
DN: cn=Halsey M. Whitney, o=PrimeEnergy
Corporation, ou=Northeast,
email=hwhitney@primeenergy.com, c=US
Date: 2013.11.26 15:03:12 -0500

District Manager

11/26/2013

Signature

Title

Date

8505434P

API# 47-085-05434
Willingham 1188

← → ↻ tagis.dep.wv.gov/convert/llutm_conus.php

Longitude:

Latitude:

DD:

Datum: NAD27 NAD83

UTM


Coordinates:

Datum: NAD27 NAD83 Zone:

State Plane (feet)

Coordinates:

Datum: NAD27 NAD83 Zone:

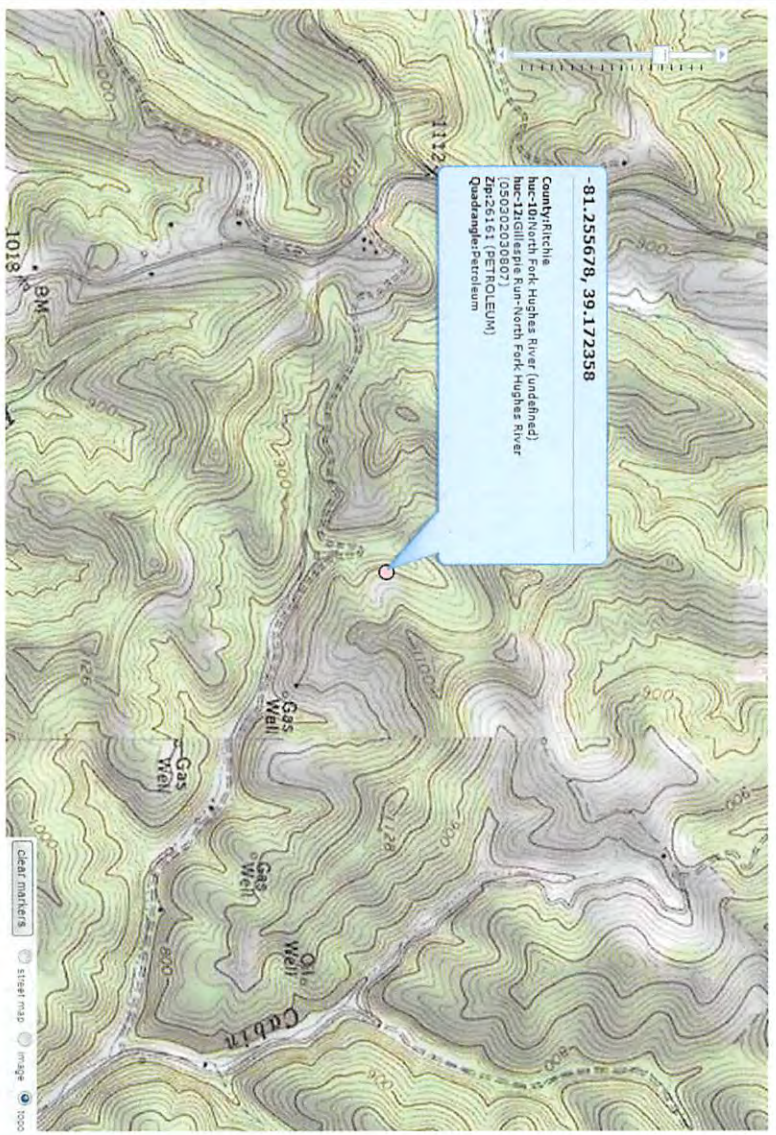

Received

NOV 26 2013

Office of Oil and Gas
WV Dept. of Environmental Protection