

WW-7
8-30-06

West Virginia Department of Environmental Protection
Office of Oil and Gas
WELL LOCATION FORM: GPS

API: 47-085-5755 WELL NO.: 1

FARM NAME: Hissem Ball

RESPONSIBLE PARTY NAME: Haught Energy Corporation

COUNTY: Ritchie DISTRICT: Grant

QUADRANGLE: Ellenboro 7.5

SURFACE OWNER: First Apostolic Church

ROYALTY OWNER: First Apostolic Church

UTM GPS NORTHING: 493044.53

UTM GPS EASTING: 4345426.9 GPS ELEVATION: 804.2'

The Responsible Party named above has chosen to submit GPS coordinates in lieu of preparing a new well location plat for a plugging permit or assigned API number on the above well. The Office of Oil and Gas will not accept GPS coordinates that do not meet the following requirements:

1. Datum: NAD 1983, Zone: 17 North, Coordinate Units: meters, Altitude: height above mean sea level (MSL) – meters.
2. Accuracy to Datum – 3.05 meters
3. Data Collection Method:

Survey grade GPS : Post Processed Differential

Real-Time Differential

Mapping Grade GPS : Post Processed Differential

Real-Time Differential

4. **Letter size copy of the topography map showing the well location.**

I the undersigned, hereby certify this data is correct to the best of my knowledge and belief and shows all the information required by law and the regulations issued and prescribed by the Office of Oil and Gas.

[Signature]
Signature


CEO
Title

10-18-18
Date

RECEIVED
Office of Oil and Gas

DEC 17 2018

WV Department of
Environmental Protection

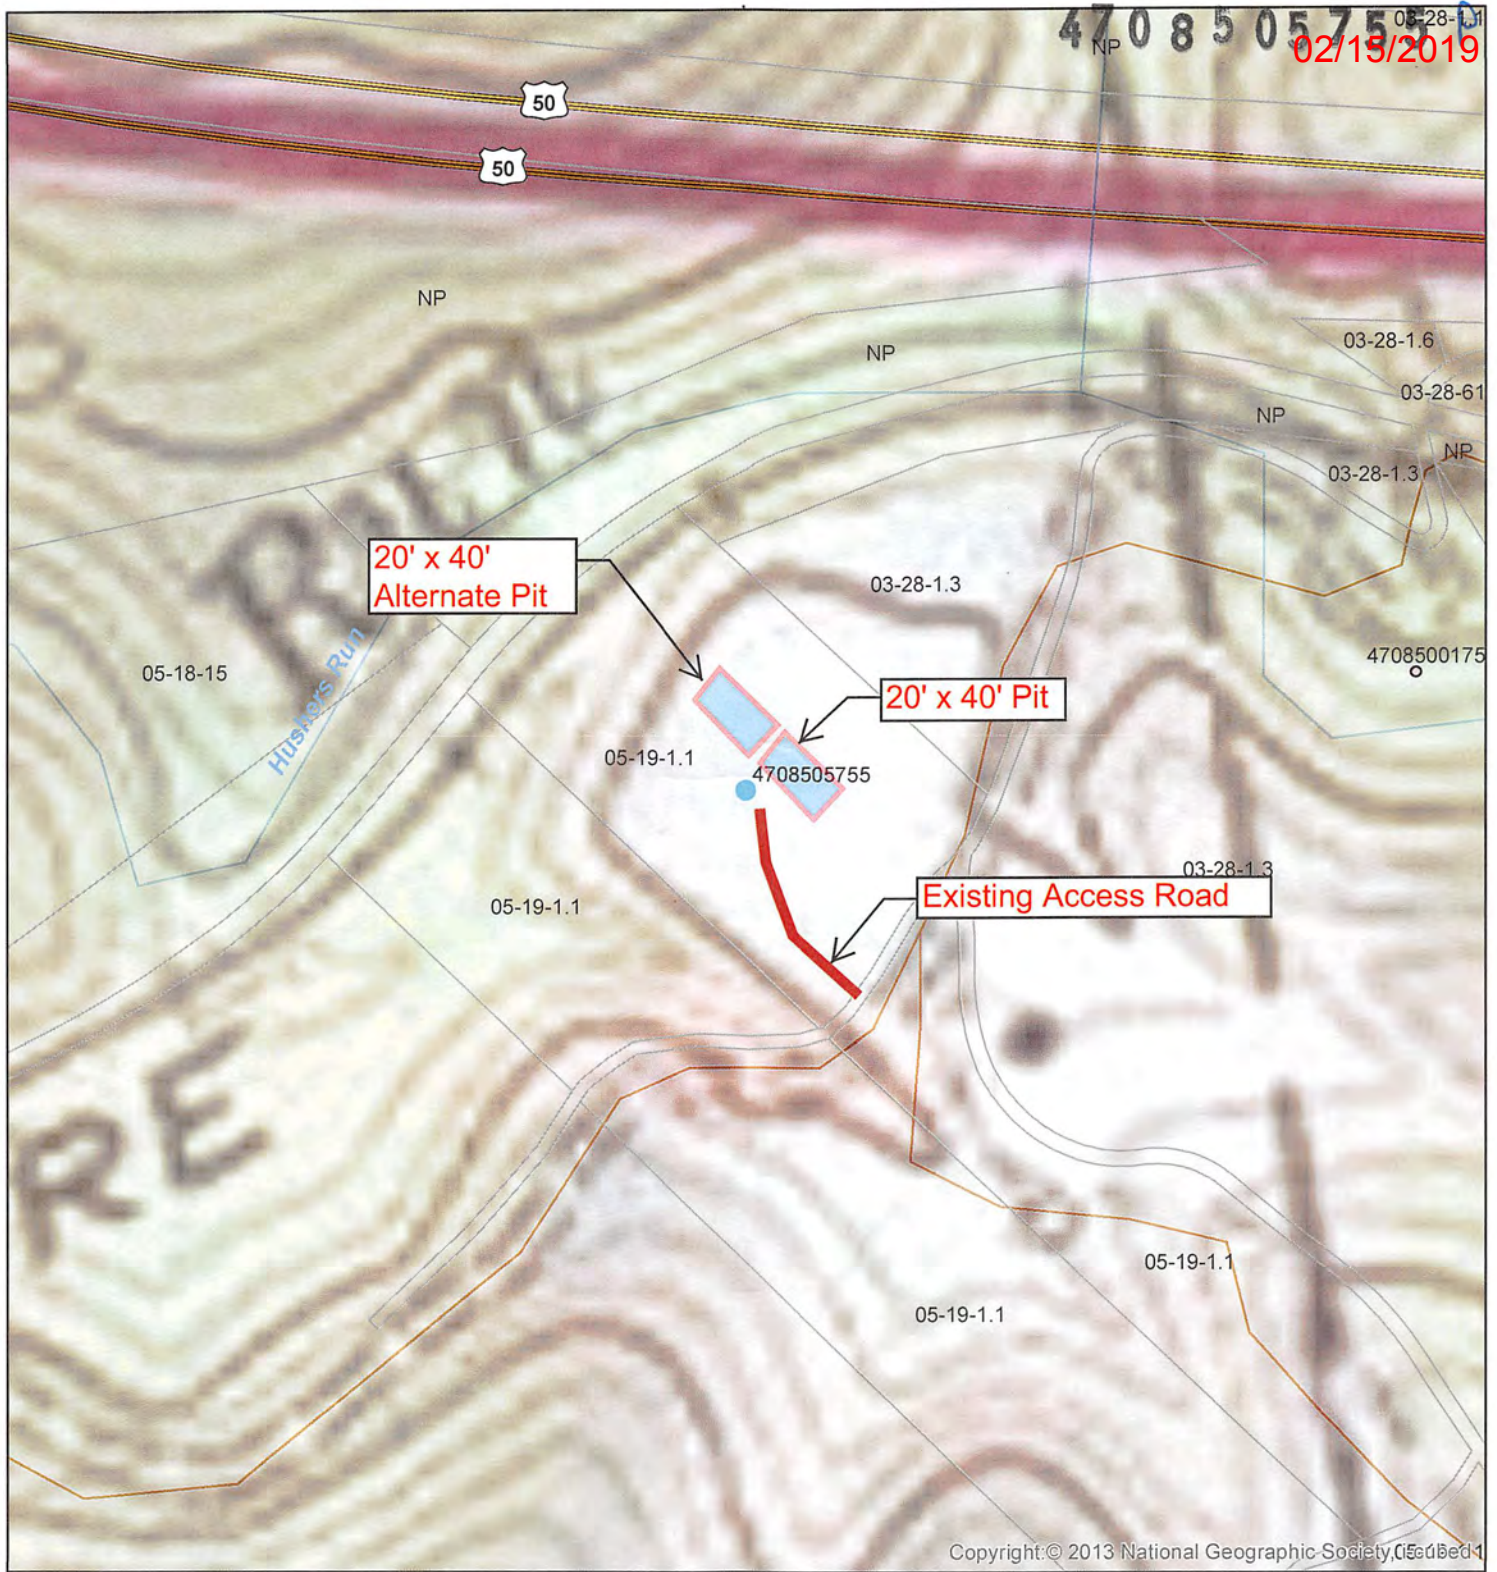


Ellenboro Quadrangle

Haught Energy Corporation

Hissem Ball - Plug
 API: 47-085-05755

Grant District Ritchie County West Virginia

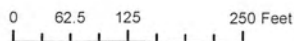

RECEIVED
 Office of Oil and Gas

DEC 17 2018

WV Department of
 Environmental Protection

