

WV-7  
E-30-06



West Virginia Department of Environmental Protection  
Office of Oil and Gas  
**WELL LOCATION FORM: GPS**

API: 47-085-06525 WELL NO.: WV 657391 (Lewis Garrison #1897)

FARM NAME: Lewis Garrison

RESPONSIBLE PARTY NAME: EQT Production Company

COUNTY: Ritchie DISTRICT: Union

QUADRANGLE: Auburn 7.5'

SURFACE OWNER: George William Adams III

ROYALTY OWNER: George William Adams III

UTM GPS NORTHING: 4328562

UTM GPS EASTING: 515834 GPS ELEVATION: 296 m (972 ft)

The Responsible Party named above has chosen to submit GPS coordinates in lieu of preparing a new well location plat for a plugging permit or assigned API number on the above well. The Office of Oil and Gas will not accept GPS coordinates that do not meet the following requirements:

1. Datum: NAD 1983, Zone: 17 North, Coordinate Units: meters, Altitude: height above mean sea level (MSL) – meters.
2. Accuracy to Datum – 3.05 meters
3. Data Collection Method:

Survey grade GPS \_\_\_\_\_ : Post Processed Differential \_\_\_\_\_  
 Real-Time Differential \_\_\_\_\_  
 Mapping Grade GPS X : Post Processed Differential X  
 Real-Time Differential \_\_\_\_\_

4. Letter size copy of the topography map showing the well location.

I the undersigned, hereby certify this data is correct to the best of my knowledge and belief and shows all the information required by law and the regulations issued and prescribed by the Office of Oil and Gas.


*Steph Olson*  
Signature

PS# 2100  
Title

1/15/18  
Date

RECEIVED  
Office of Oil and Gas

JAN 02 2019

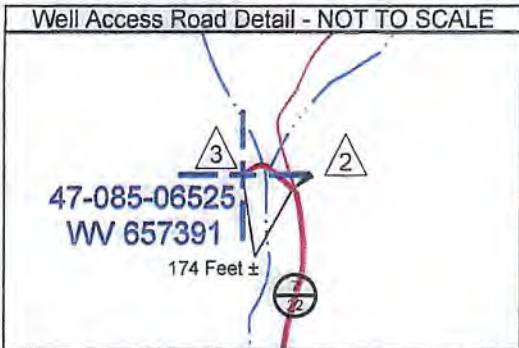

**MISS UTILITY OF WEST VIRGINIA (WV 811)  
(EXHIBIT B)  
DIRECTIONS TO EXISTING GAS WELL NO. WV 657391  
API NO. 47-085-06525**



SITE	LATITUDE	LONGITUDE
1	39.091054	-80.840731
2	39.105941	-80.816360
3	39.106054	-80.816868



- NOTES**
1. ALL ACCESS ROADS SHOWN HEREON ARE EXISTING AND WERE FLAGGED IN PINK AND WHITE MARKING RIBBON.
  2. THIS MAP IS PREPARED ONLY FOR THE PARTIES REFERENCED HEREON FOR THE PURPOSE OF NOTIFICATION TO MISS UTILITY OF WEST VIRGINIA (WV 811).
  3. DRAWING IS NOT TO SCALE.



SURVEYING AND MAPPING SERVICES PERFORMED BY:  
**ALLEGHENY SURVEYS, INC.**  
1-800-482-8606  
237 Birch River Road  
Birch River, WV 26610  
PH: (304) 649-8606  
FAX: (304) 649-8608

County: Ritchie  
District: Union  
Date: November 15, 2018  
Project No: 68-38-00-08  
File Name: WV 657391 GARRISON

PREPARED FOR:  
**EQT Production Company**  
2400 Ansys Drive, Suite 200  
Canonsburg, PA 15317

WV Department of  
Environmental Protection  
JAN 02 2019  
VED  
Oil and Gas

47-085-06525 P