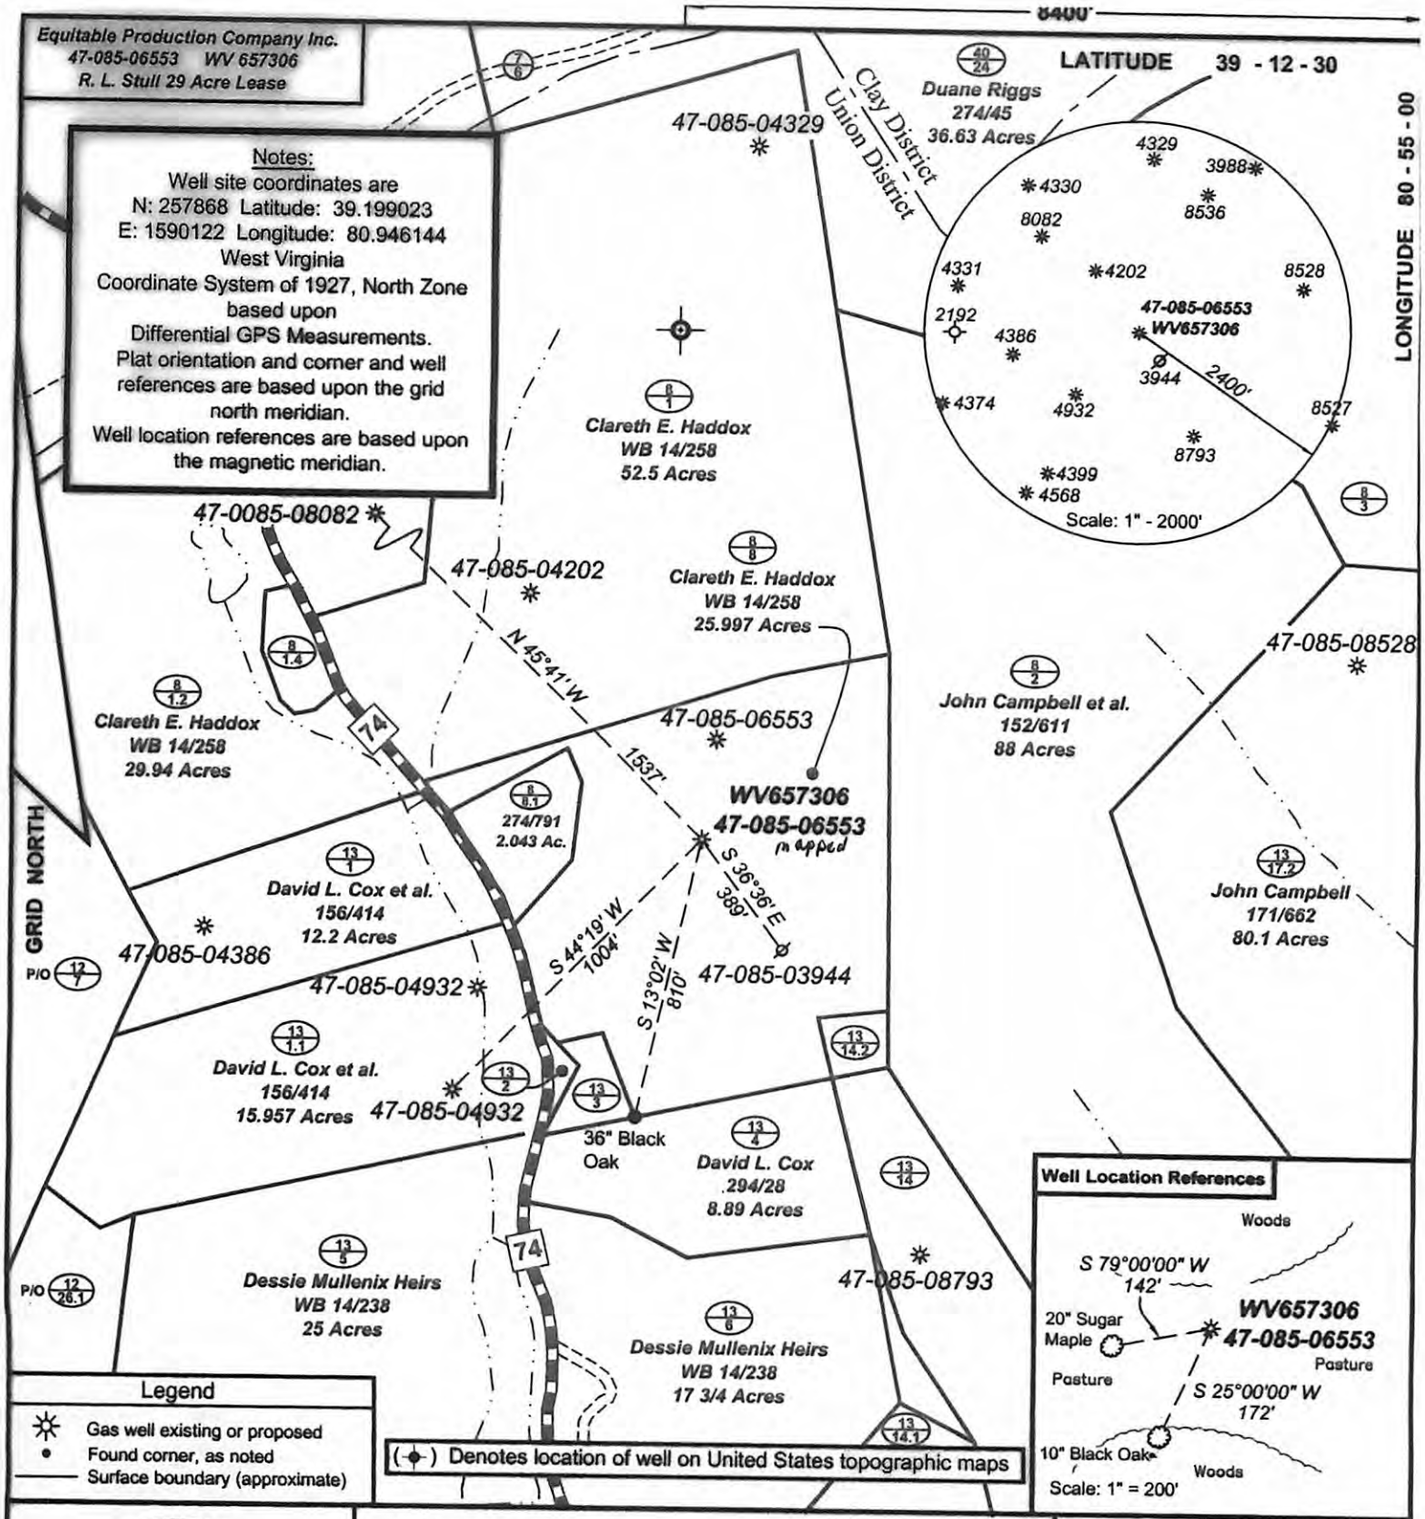

Allegheny Surveys, Inc. Birch River and Weston, W.V.

I, the undersigned, hereby certify that this plat is correct to the best of my knowledge and belief and shows all the information required by law and the regulations issued and prescribed by the Department of Environmental Protection.

Ben R. Singleton
P.S. 2092

Ben R. Singleton LICENSED NO. 2092 STATE OF WEST VIRGINIA PROFESSIONAL SURVEYOR

SEAL

FILE NO: 129-38-U-07 EQT 1-66
DRAWING NO: 12938U07_WV657306.dwg
SCALE: 1" = 500'
MINIMUM DEGREE OF ACCURACY: 1:2500
PROVEN SOURCE OF ELEVATION: NGS CORS GSSP

STATE OF WEST VIRGINIA
DEPARTMENT OF ENVIRONMENTAL PROTECTION
OFFICE OF OIL AND GAS

DATE: January 5 20 08
OPERATOR'S WELL NO. WV657306
API WELL NO: 47-085-06553
47 - 085 - 06553
STATE COUNTY PERMIT
Stull 1861

CANCELLED

WELL TYPE: ☐ OIL ☒ GAS ☐ LIQUID INJECTION ☐ WASTE DISPOSAL
(IF GAS) PRODUCTION : ☐ STORAGE ☐ DEEP ☒ SHALLOW
LOCATION: ELEVATION: 1092' WATERSHED Tributary of Left Fork of Slab Creek
QUADRANGLE: Pullman DISTRICT: Union COUNTY: Ritchie
SURFACE OWNER: Clareth E. Haddox ACREAGE: 25.997
OIL AND GAS ROYALTY OWNER: Clareth E. Haddox et al. LEASE NO: 706031 ACREAGE: 29
PROPOSED WORK: ☐ DRILL ☐ CONVERT ☐ DRILL DEEPER ☒ FRACTURE OR STIMULATE ☐ PLUG OFF OLD FORMATION
☒ PERFORATE NEW FORMATION ☐ OTHER PHYSICAL CHANGE IN WELL (SPECIFY)
☐ PLUG AND ABANDON ☐ CLEAN OUT AND REPLUG TARGET FORMATION: Alexander ESTIMATED DEPTH: 5350'
10/11/2013

WELL OPERATOR: Equitable Production Company, Inc.
ADDRESS: 1710 Pennsylvania Ave.
Charleston, WV 25302

DESIGNATED AGENT: L. Todd Tettrick
ADDRESS: 1710 Pennsylvania Ave.
Charleston, WV 25302