

WW-7  
8-30-06



West Virginia Department of Environmental Protection  
Office of Oil and Gas  
**WELL LOCATION FORM: GPS**

API: 47-085-08489 WELL NO.: WV 657436 (Wilson #1888)

FARM NAME: J. Wilson

RESPONSIBLE PARTY NAME: EQT Production Company

COUNTY: Ritchie DISTRICT: Clay

QUADRANGLE: Pennsboro 7.5'

SURFACE OWNER: Mark & Noreen Leskowicz

ROYALTY OWNER: Orma M. Wilson Johnson

UTM GPS NORTHING: 4348288

UTM GPS EASTING: 505286 GPS ELEVATION: 355 m (1165 ft)

The Responsible Party named above has chosen to submit GPS coordinates in lieu of preparing a new well location plat for a plugging permit or assigned API number on the above well. The Office of Oil and Gas will not accept GPS coordinates that do not meet the following requirements:

1. Datum: NAD 1983, Zone: 17 North, Coordinate Units: meters, Altitude: height above mean sea level (MSL) – meters.
2. Accuracy to Datum – 3.05 meters
3. Data Collection Method:

Survey grade GPS \_\_\_\_\_ : Post Processed Differential \_\_\_\_\_  
 Real-Time Differential \_\_\_\_\_  
 Mapping Grade GPS  X  : Post Processed Differential  X   
 Real-Time Differential \_\_\_\_\_

4. Letter size copy of the topography map showing the well location.

I the undersigned, hereby certify this data is correct to the best of my knowledge and belief and shows all the information required by law and the regulations issued and prescribed by the Office of Oil and Gas.

*[Signature]*  
Signature

PS# 2180  
Title

5/10/18  
Date

RECEIVED  
Office of Oil and Gas  
JUN 05 2018  
WV Department of  
Environmental Protection

Topo Quad: Pennsboro 7.5'

Scale: 1" = 2000'

County: Ritchie


Date: May 11, 2018

District: Clay

Project No: 68-38-00-08

# 47-085-08489 WV 657436 (J. Wilson #1888)

Topo

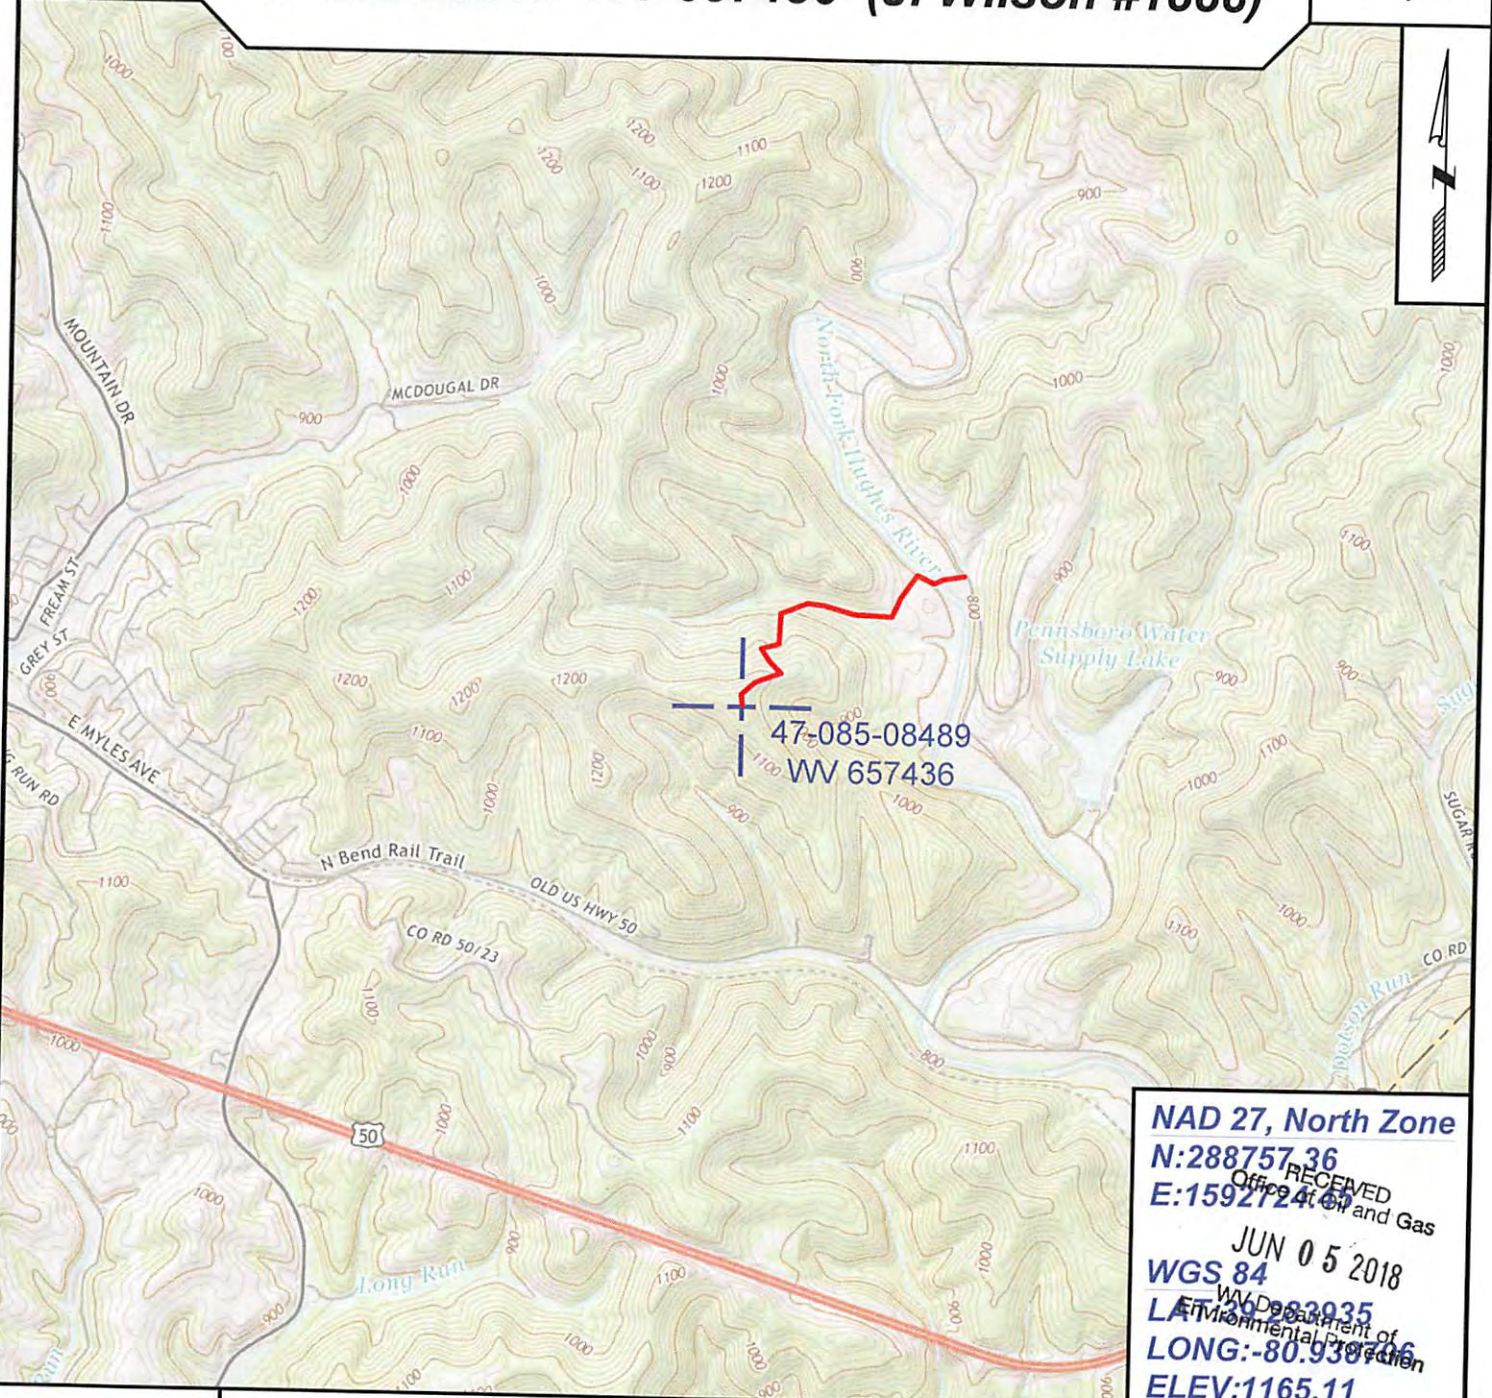

**NAD 27, North Zone**  
**N:288757.36**  
**E:1592724.65**  
 RECEIVED  
 Office of Oil and Gas  
**JUN 05 2018**  
**WGS 84**  
 WV Department of Environmental Protection  
**LONG:-80.93806**  
**ELEV:1165.11**



SURVEYING AND MAPPING SERVICES PERFORMED BY:  
**ALLEGHENY SURVEYS, INC.**  
 1-800-482-8606  
 237 Birch River Road  
 Birch River, WV 26610  
 PH: (304) 649-8606  
 FAX: (304) 649-8608

PREPARED FOR:  
**EQT Production Company**  
 2400 Ansys Drive  
 Canonsburg, PA 15317