



**ALMA VINSON  
HEIRS  
63 ACRE  
LEASE**

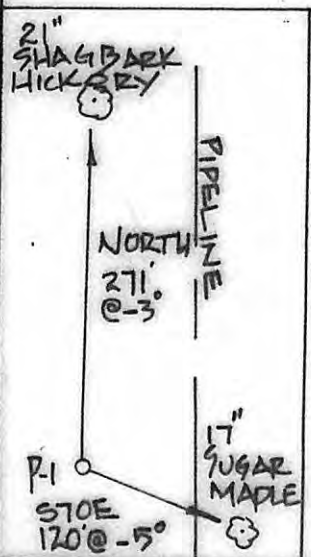

FILE NO. \_\_\_\_\_  
 DRAWING NO. \_\_\_\_\_  
 SCALE 1" = 500'  
 MINIMUM DEGREE OF ACCURACY 1:200  
 PROVEN SOURCE OF ELEVATION G.P.S.  
OBSERVATION

I THE UNDERSIGNED, HEREBY CERTIFY THAT THIS PLAT IS CORRECT TO THE BEST OF MY KNOWLEDGE AND BELIEF AND SHOWS ALL THE INFORMATION REQUIRED BY LAW AND THE REGULATIONS ISSUED AND PRESCRIBED BY THE DEPARTMENT OF ENERGY.  
 (SIGNED) [Signature]  
 R.P.E. \_\_\_\_\_ P.S. 551

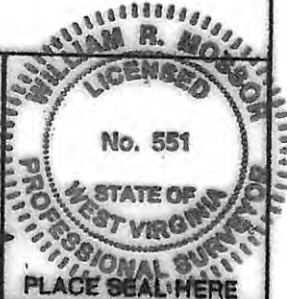

STATE OF WEST VIRGINIA  
 DEPARTMENT OF ENERGY  
 DIVISION OF OIL AND GAS

DATE JANUARY 23, 2008  
 OPERATOR'S WELL NO. VINSON P-1  
 API WELL NO. 47-085-9302

WELL TYPE: OIL  GAS  LIQUID INJECTION \_\_\_\_\_ WASTE DISPOSAL \_\_\_\_\_  
 (IF "GAS,") PRODUCTION  STORAGE \_\_\_\_\_ DEEP  SHALLOW \_\_\_\_\_

LOCATION: ELEVATION 1063' WATER SHED HITCHCOCK RUN  
 DISTRICT CLAY COUNTY RITCHIE  
 QUADRANGLE ELLENBORO

SURFACE OWNER ALMA VINSON HEIRS ACREAGE 56.57  
 OIL & GAS ROYALT ALMA VINSON HEIRS LEASE AC. 63

PROPOSED WORK: DRILL \_\_\_\_\_ CONVERT \_\_\_\_\_ DRILL DEEPER \_\_\_\_\_ REDRILL \_\_\_\_\_ FRACTURE OR STIMULATE  PLUG OFF OLD FORMATION \_\_\_\_\_ PERFORATE NEW FORMATION \_\_\_\_\_ OTHER PHYSICAL CHANGE IN WELL (SPECIFY) REFRAC.

PLUG AND ABANDON \_\_\_\_\_ CLEAN OUT AND REPLUG \_\_\_\_\_

TARGET FORMATION DEVONIAN SERIES ESTIMATED DEPTH 6398'  
 WELL OPERATOR PETROEDGE RES (WV) DESIGNATED AGENT DAN MULLINS  
 ADDRESS 2925 BRIAR PARK DR, SUITE 150 ADDRESS 101 WEST MAIN ST. HARRISVILLE, WV 26362  
HOUSTON, TEXAS 77042

FORM WV-9

COUNTY NAME  
 PERMIT