
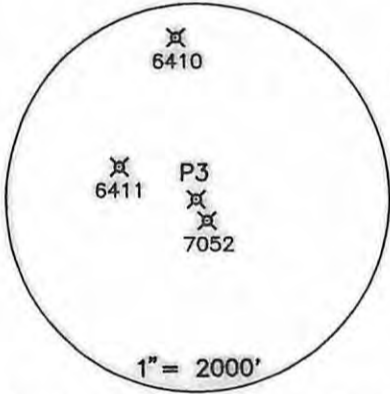


LATITUDE 39°05'00"
 LONGITUDE 81°07'30"
 NAD 27
 LONG: 81.1387527
 LAT: 39.054679

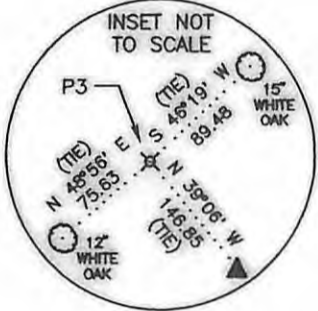

LEGEND
 ▲ IRON ROD FOUND
 ● CALCULATED POINT
 --- TRACT LINE
 -x-x- FENCE

(+) DENOTES LOCATION OF WELL ON UNITED STATES TOPOGRAPHIC MAPS

FILE NO. _____
 DRAWING NO. 06-176-3
 SCALE 1" = 1000'
 MINIMUM DEGREE OF ACCURACY 1 IN 200
 PROVEN SOURCE OF ELEVATION G.P.S.

I THE UNDERSIGNED, HEREBY CERTIFY THAT THIS PLAT IS CORRECT TO THE BEST OF MY KNOWLEDGE AND BELIEF AND SHOWS ALL THE INFORMATION REQUIRED BY LAW AND THE REGULATIONS ISSUED AND PRESCRIBED BY THE DEPARTMENT OF ENERGY.
 (SIGNED) _____
 R.P.E. _____ L.L.S. 851



STATE OF WEST VIRGINIA
 Division of Environmental Protection
 OFFICE OF OIL AND GAS

DATE 05-04, 20 06
 OPERATOR'S WELL NO. McGREGOR #P3
 API WELL NO. 47 - 085 - 09361
 STATE COUNTY PERMIT

WELL TYPE: OIL GAS LIQUID INJECTION _____ WASTE DISPOSAL _____
 (IF "GAS") PRODUCTION STORAGE _____ DEEP _____ SHALLOW

LOCATION: ELEVATION 1123 WATER SHED _____ LICK RUN
 DISTRICT MURPHY COUNTY RITCHIE
 QUADRANGLE MACFARLAN

SURFACE OWNER WILLIAM BAILEY ACREAGE 276
 OIL & GAS ROYALTY OWNER McGREGOR ETAL LEASE ACREAGE 340
 LEASE NO. _____

PROPOSED WORK: DRILL CONVERT _____ DRILL DEEPER _____ REDRILL _____ FRACTURE OR STIMULATE PLUG OFF OLD FORMATION _____ PERFORATE NEW FORMATION _____ OTHER PHYSICAL CHANGE IN WELL (SPECIFY): _____

PLUG AND ABANDON _____ CLEAN OUT AND REPLUG _____
 TARGET FORMATION HAMILTON ESTIMATED DEPTH 6,250'
 WELL OPERATOR PETROEDGE RESOURCES (WV), LLC. DESIGNATED AGENT WARREN HAUGHT
 ADDRESS 10375 RICHMOND AVE. SUITE 850 ADDRESS HC 68 BOX 14
 HOUSTON TX, 77042 SMITHVILLE, WV 26178

CANCELLED

08/09/2013