

8509672P

WW-7
8-30-06



West Virginia Department of Environmental Protection
Office of Oil and Gas
WELL LOCATION FORM: GPS

API: 47-085-09672 WELL NO.: A Hall 1

FARM NAME: Russell Fox

RESPONSIBLE PARTY NAME: Noble Energy, Inc.

COUNTY: Ritchie DISTRICT: Clay

QUADRANGLE: Ellenboro 357

SURFACE OWNER: Russell Fox

ROYALTY OWNER: _____

UTM GPS NORTHING: 4353545.242 Meters

UTM GPS EASTING: 498667.429 Meters GPS ELEVATION: 325.60 Meters (1068 FT)

The Responsible Party named above has chosen to submit GPS coordinates in lieu of preparing a new well location plat for a plugging permit or assigned API number on the above well. The Office of Oil and Gas will not accept GPS coordinates that do not meet the following requirements:

- Datum: NAD 1983, Zone: 17 North, Coordinate Units: meters, Altitude: height above mean sea level (MSL) - meters.
- Accuracy to Datum - 3.05 meters
- Data Collection Method:

Survey grade GPS : Post Processed Differential _____
Real-Time Differential

Mapping Grade GPS _____ : Post Processed Differential _____
Real-Time Differential _____

4. Letter size copy of the topography map showing the well location.

I the undersigned, hereby certify this data is correct to the best of my knowledge and belief and shows all the information required by law and the regulations issued and prescribed by the Office of Oil and Gas.



Received



JUN 18 2014

Office of Oil and Gas
WV Dept. of Environmental Protection

George D. Six
Signature

Professional Surveyor
Title

6-12-14
Date

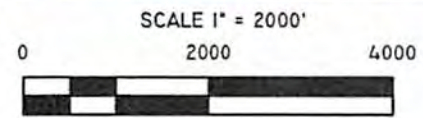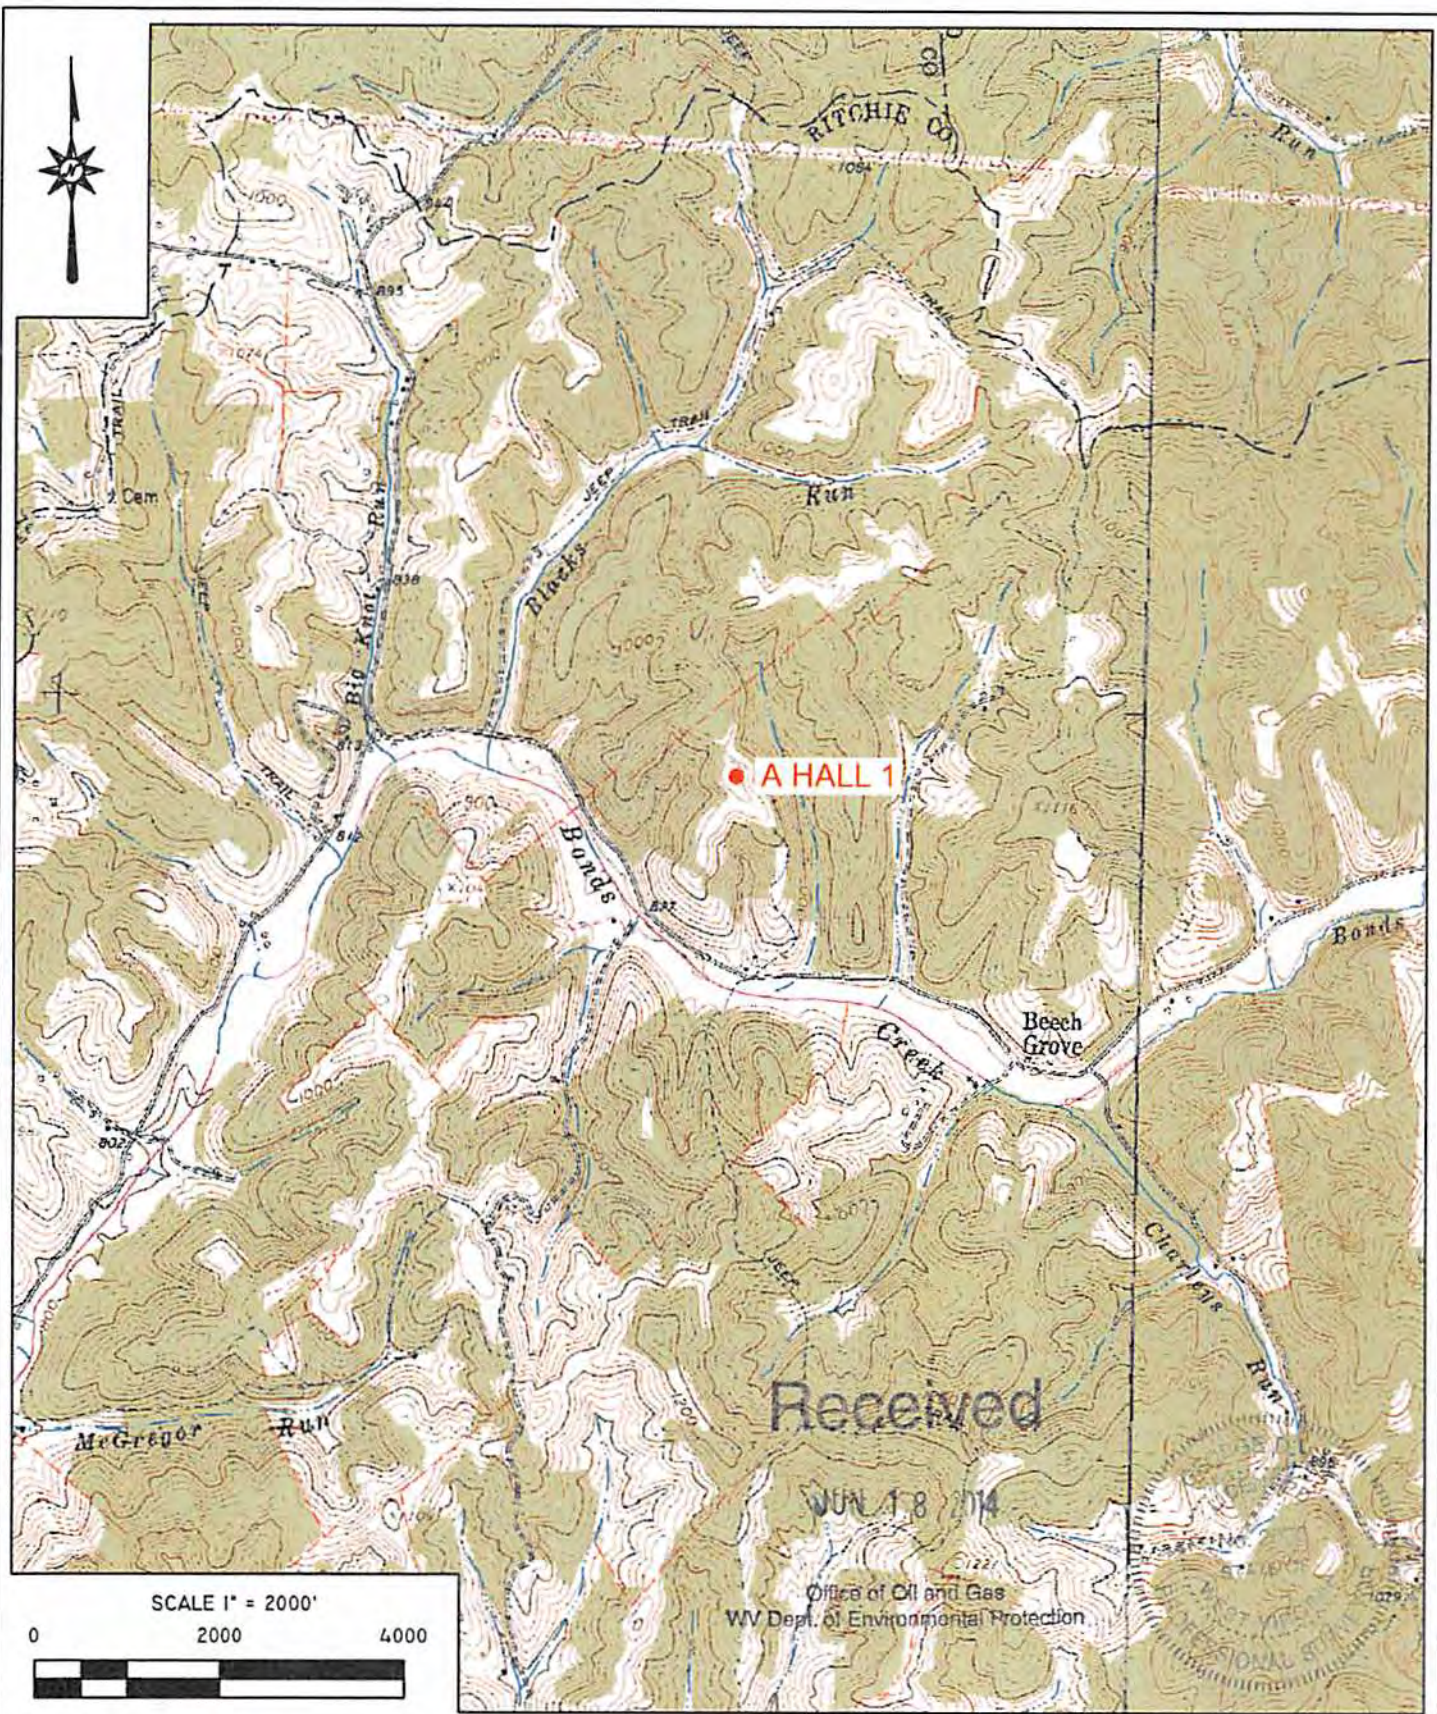

Received
 JUN 18 2014
 Office of Oil and Gas
 WV Dept. of Environmental Protection

Blue Mountain Inc.
 11023 MASON DIXON HIGHWAY
 BURTON, WV 26562
 PHONE: (304) 662-6486

PREPARED FOR:
 NOBLE ENERGY, INC.
 333 TECHNOLOGY DRIVE, SUITE 116
 CANONSBURG, PA 15317

A HALL 1
TOPO SECTION OF ELLENBORO 7.5'
USGS TOPO QUADRANGLE

JUNE 12, 2014