

WW-7
8-30-06



West Virginia Department of Environmental Protection
Office of Oil and Gas
WELL LOCATION FORM: GPS

API: 47-085-09971 WELL NO.: Prunty 2H

FARM NAME: Lockhart Heirs

RESPONSIBLE PARTY NAME: Antero Resources Corporation

COUNTY: Ritchie DISTRICT: Union

QUADRANGLE: Pullman

SURFACE OWNER: Karah Leigh Lofton

ROYALTY OWNER: _____

UTM GPS NORTHING: 4337985.54 m

UTM GPS EASTING: 509484.43 m GPS ELEVATION: 1143.8 ft

The Responsible Party named above has chosen to submit GPS coordinates in lieu of preparing a new well location plat for a plugging permit or assigned API number on the above well. The Office of Oil and Gas will not accept GPS coordinates that do not meet the following requirements:

1. Datum: NAD 1983, Zone: 17 North, Coordinate Units: meters, Altitude: height above mean sea level (MSL) – meters.
2. Accuracy to Datum – 3.05 meters
3. Data Collection Method:

Survey grade GPS : Post Processed Differential _____
Real-Time Differential


Mapping Grade GPS : Post Processed Differential _____
Real-Time Differential

4. Letter size copy of the topography map showing the well location.

I the undersigned, hereby certify this data is correct to the best of my knowledge and belief and shows all the information required by law and the regulations issued and prescribed by the Office of Oil and Gas.

MM TUM Signature permitted manager Title 3/2/23 Date

47.08509971

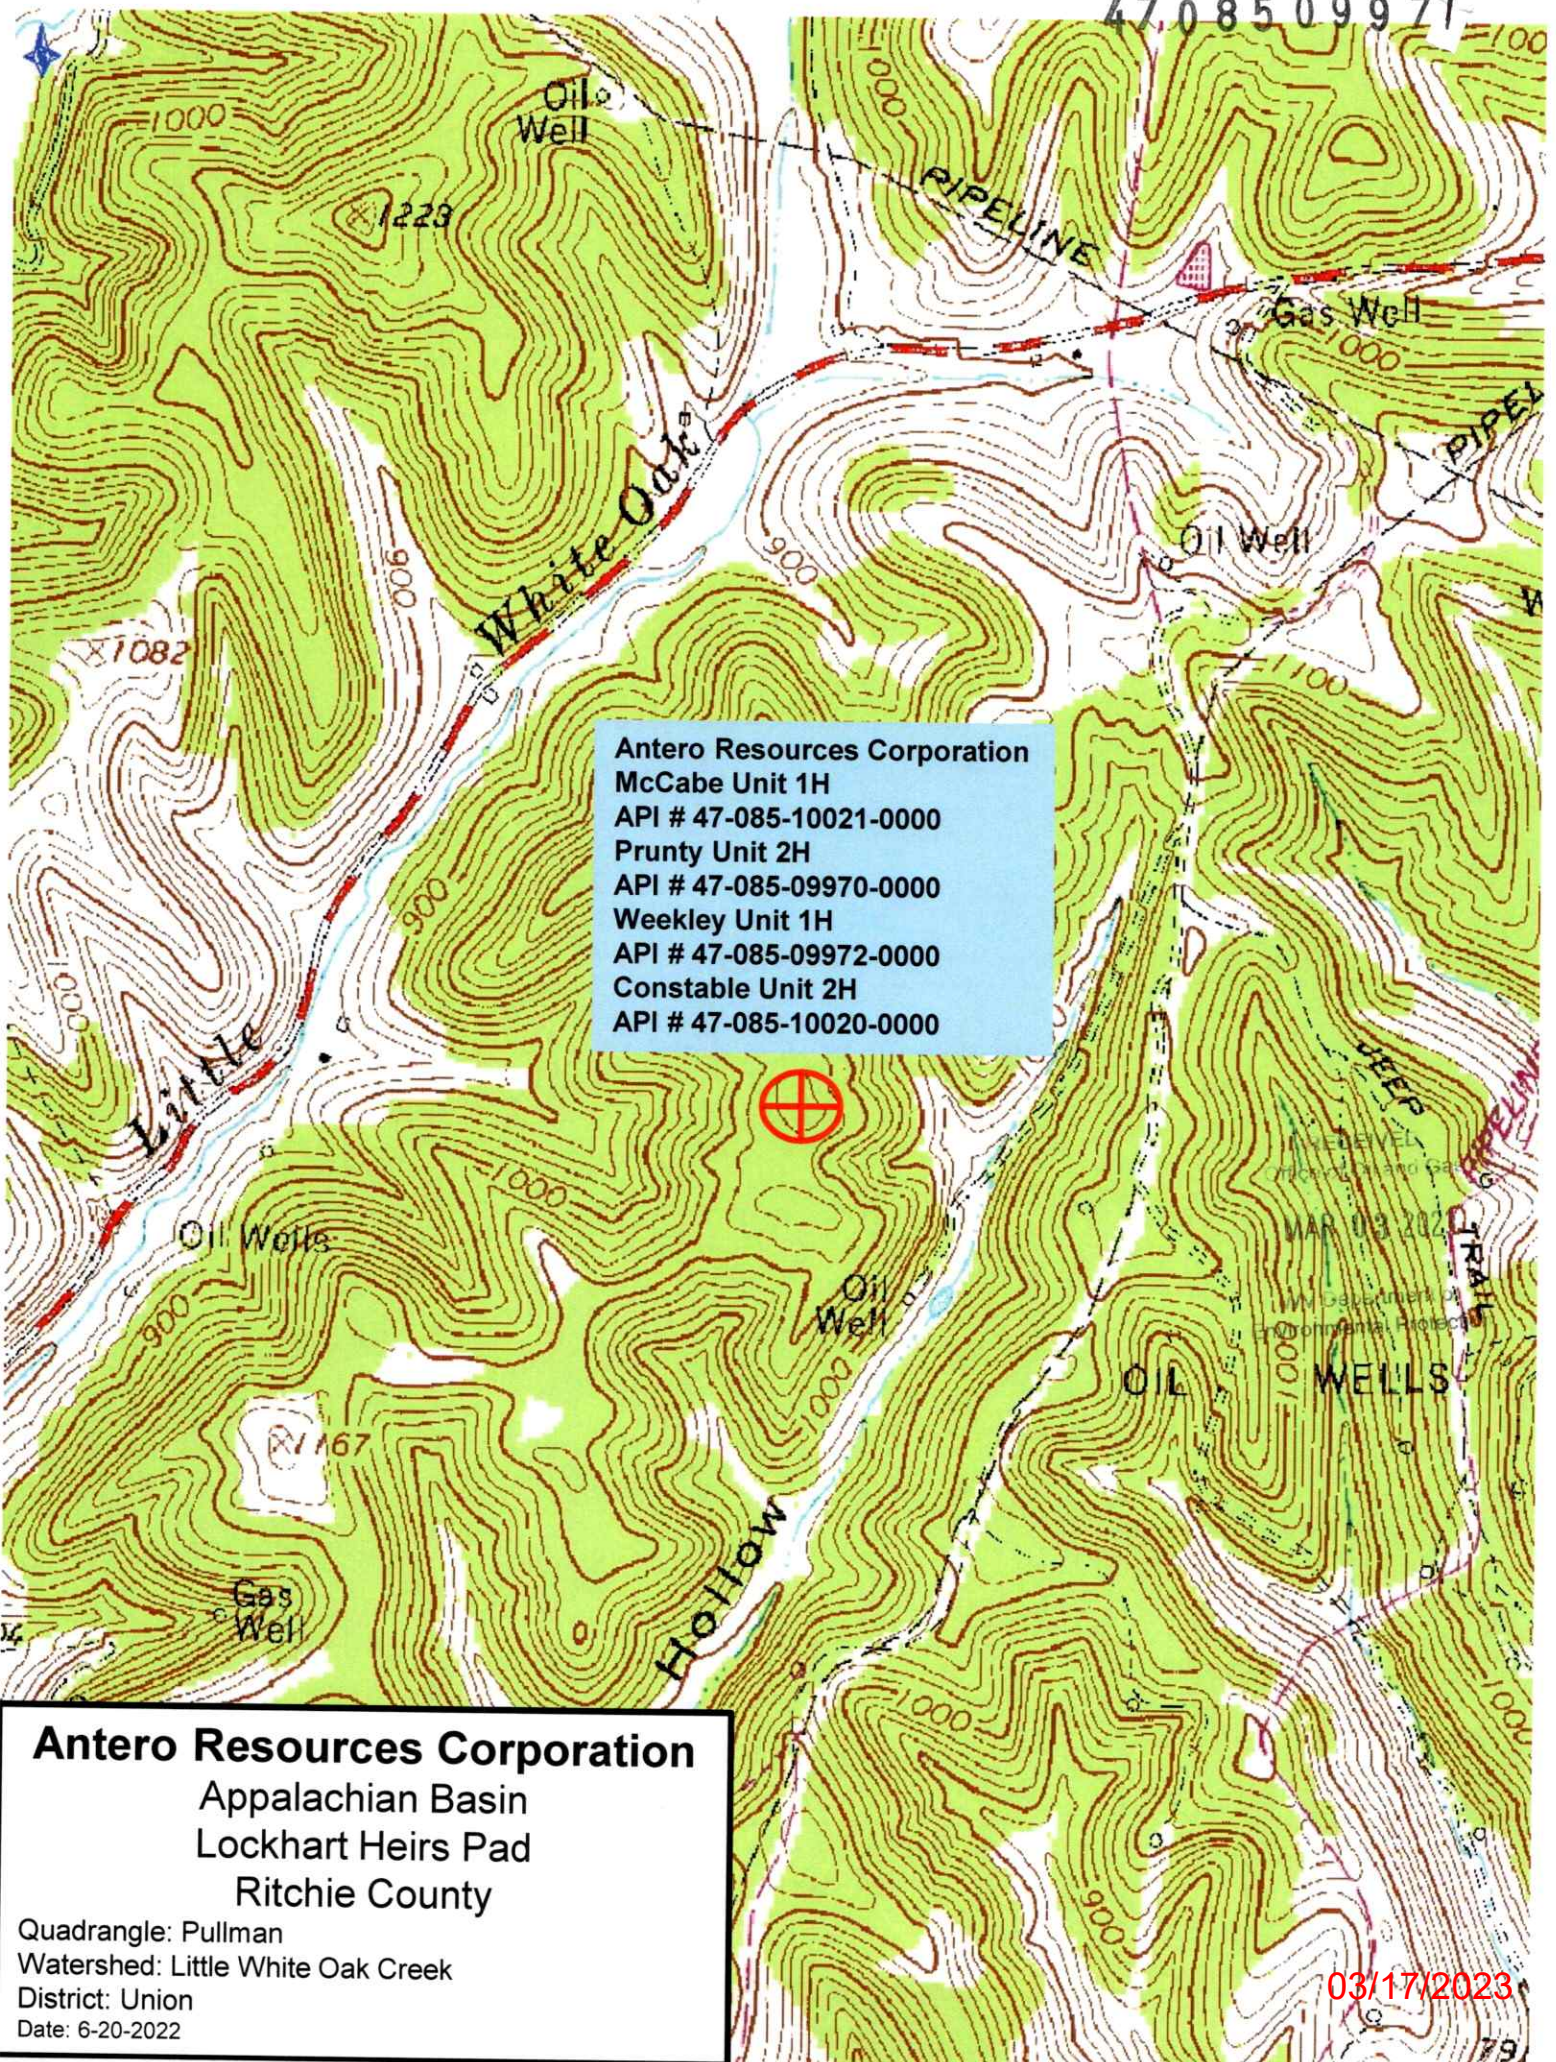

Antero Resources Corporation
 McCabe Unit 1H
 API # 47-085-10021-0000
 Prunty Unit 2H
 API # 47-085-09970-0000
 Weekley Unit 1H
 API # 47-085-09972-0000
 Constable Unit 2H
 API # 47-085-10020-0000



MAR 03 2022
 Environmental Protection

Antero Resources Corporation
 Appalachian Basin
 Lockhart Heirs Pad
 Ritchie County

Quadrangle: Pullman
 Watershed: Little White Oak Creek
 District: Union
 Date: 6-20-2022

03/17/2023