


Latitude: 39°22'30"

Longitude: 80°57'30"



LEGEND	
	- TOPO MAP POINT
	- PROPOSED GAS WELL
	- ALL ARE POINTS UNLESS OTHERWISE NOTED.
	- WATER SOURCE
	- LEASE NUMBER
	- SURFACE BOUNDARY
	- LEASE BOUNDARY
	- PARCEL LINES
	- WELL REFERENCE
	- PROPOSED HORIZONTAL WELL
	- ROAD
	- STREAM CENTER LINE
	- AS DRILLED
WELLS WITHIN 3000'	
	- EXISTING WELLS
	- PLUGGED WELLS

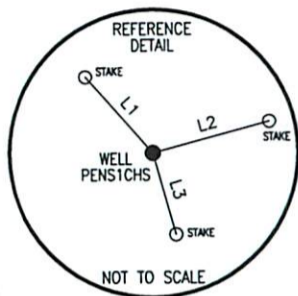

LINE	BEARING	DISTANCE
L1	N 41°14'17" W	211.73'
L2	N 74°58'38" E	249.05'
L3	S 15°41'05" E	175.64'

APPROX. LANDING POINT	
UTM 17 - NAD83	N:4353882.509 E:500746.032
NAD27 - WV NORTH	N:307364.826 E:1578197.687
LAT/LOG DATUM - WGS84	LAT:39°20'03.71" LON:80°59'28.00"

TRACT	LESSORS
1	JOSEPH F. & JOYCE A. SCHMIDLE
2	JOSEPH F. & JOYCE A. SCHMIDLE
3	JOSEPH F. & JOYCE A. SCHMIDLE
4	JOSEPH F. & JOYCE A. SCHMIDLE
5	DON A. & VIRGINIA C. COMER
6	DAVID L. MAPLE ET AL
7	DAVID L. MAPLE ET AL

Blue Mountain Inc.
11023 MASON DIXON HIGHWAY
BURTON, WV 26562
PHONE: (304) 662-6486


COORDINATES:
9,744' WEST
14,560' SOUTH

SURFACE HOLE LOCATION (SHL)
UTM 17
N:4353956.515
E:500624.164
NAD27 - WV NORTH
N:307615.464
E:1577735.194
LAT/LOG DATUM - WGS84
LAT:39°20'06.11"
LON:80°59'33.93"

SURFACE HOLE LOCATION (SHL)
UTM 17
N:4353956.69
E:500623.86
NAD27 - WV NORTH
N:307616.056
E:1577735.210
LAT/LOG DATUM - WGS84
LAT:39°20'06.12"
LON:80°59'33.94"

BOTTOM HOLE LOCATION (BHL)
UTM 17 - NAD83
N:4352362.712
E:502085.174
NAD27 - WV NORTH
N:302305.173
E:1582443.240
LAT/LOG DATUM - WGS84
LAT:39°19'14.40"
LON:80°58'32.92"

BOTTOM HOLE LOCATION (BHL)
UTM 17 - NAD83
N:4352356.87
E:502085.18
NAD27 - WV NORTH
N:302285.992
E:1582442.953
LAT/LOG DATUM - WGS84
LAT:39°19'14.22"
LON:80°58'32.92"

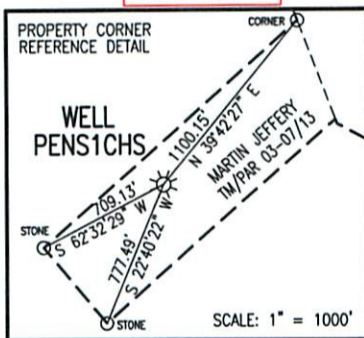

NOTES:

- There are no water wells or developed springs within 250' of proposed well.
- There are no existing buildings within 625' of proposed well.
- Proposed well is greater than 100' from perennial stream, wetland, pond, reservoir or lake.
- There are no native trout streams within 300' of proposed well.
- Proposed well is greater than 1000' from surface/groundwater intake or public water supply.
- It is not the purpose or intention of this plat to represent surveyed locations of the surface or mineral parcels depicted hereon. The location of the boundary lines, as shown, are based on record deed descriptions, field evidence found and/or tax map position, unless otherwise noted.


FILE #: PENS1CHS-AS DRILLED
DRAWING #: PENS1CHS-AS DRILLED
SCALE: 1" = 2000'
MINIMUM DEGREE OF ACCURACY: 1/2500
PROVEN SOURCE OF ELEVATION: U.S.G.S. MONUMENT THOMAS 1498.81'

I, THE UNDERSIGNED, HEREBY CERTIFY THAT THIS PLAT IS CORRECT TO THE BEST OF MY KNOWLEDGE AND BELIEF AND SHOWS ALL THE INFORMATION REQUIRED BY LAW AND THE REGULATIONS ISSUED AND PRESCRIBED BY THE DEPARTMENT OF ENVIRONMENTAL PROTECTION.

Signed: *George D. Six*

R.P.E.:

L.L.S.: P.S. No. 2000

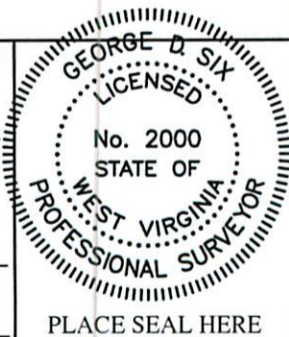

(+) DENOTES LOCATION OF WELL ON UNITED STATES TOPOGRAPHIC MAPS WVDEP
OFFICE OF OIL & GAS
601 57TH STREET
CHARLESTON, WV 25304



DATE: AUGUST 26, 2014
OPERATOR'S WELL #: PENS1CHS-AS DRILLED
API WELL #: 47 85 10011H6A
STATE COUNTY PERMIT

Well Type: Oil Waste Disposal Production Deep
 Gas Liquid Injection Storage Shallow

WATERSHED: UNNAMED TRIBUTARY TO BONDS CREEK ELEVATION: 1120.49'

COUNTY/DISTRICT: RITCHIE / CLAY QUADRANGLE: PENNSBORO, WV 7.5'

SURFACE OWNER: CNX GAS COMPANY LLC ACREAGE: 19.759±

OIL & GAS ROYALTY OWNER: SEE TABLE ABOVE ACREAGE: 329.103±

DRILL CONVERT DRILL DEEPER REDRILL FRACTURE OR STIMULATE
PLUG OFF OLD FORMATION PERFORATE NEW FORMATION PLUG & ABANDON
CLEAN OUT & REPLUG OTHER CHANGE (SPECIFY):

TARGET FORMATION: MARCELLUS ESTIMATED DEPTH: TVD: 6,400'± TMD: 14,500'±

WELL OPERATOR NOBLE ENERGY, INC. DESIGNATED AGENT STEVEN M. GREEN
Address 333 TECHNOLOGY DRIVE, SUITE 110 Address 500 VIRGINIA STREET EAST, UNITED CENTER SUITE 1001
City CANONSBURG State PA Zip Code 15317 City CHARLESTON State WV Zip Code 25301

12/05/2014