

4708510020

WW-7  
8-30-06



West Virginia Department of Environmental Protection  
Office of Oil and Gas  
**WELL LOCATION FORM: GPS**

API: 47-085-10020 WELL NO.: Constable 2H

FARM NAME: Lockhart Heirs

RESPONSIBLE PARTY NAME: Antero Resources Corporation

COUNTY: Ritchie DISTRICT: Union

QUADRANGLE: Pullman

SURFACE OWNER: Karah Leigh Lofton

ROYALTY OWNER: \_\_\_\_\_

UTM GPS NORTHING: 4338000.48 m

UTM GPS EASTING: 509482.36 m GPS ELEVATION: 1143.8 ft

The Responsible Party named above has chosen to submit GPS coordinates in lieu of preparing a new well location plat for a plugging permit or assigned API number on the above well. The Office of Oil and Gas will not accept GPS coordinates that do not meet the following requirements:

1. Datum: NAD 1983, Zone: 17 North, Coordinate Units: meters, Altitude: height above mean sea level (MSL) – meters.
2. Accuracy to Datum – 3.05 meters
3. Data Collection Method:

Survey grade GPS  : Post Processed Differential \_\_\_\_\_  
Real-Time Differential

Mapping Grade GPS  : Post Processed Differential \_\_\_\_\_  
Real-Time Differential

4. Letter size copy of the topography map showing the well location.

I the undersigned, hereby certify this data is correct to the best of my knowledge and belief and shows all the information required by law and the regulations issued and prescribed by the Office of Oil and Gas.

Mary Tim  
Signature


Permitted Manager  
Title

3/2/23  
Date

RECEIVED  
Office of Oil and Gas  
MAR 03 2023

WV Department of  
Environmental Protection

03/17/2023

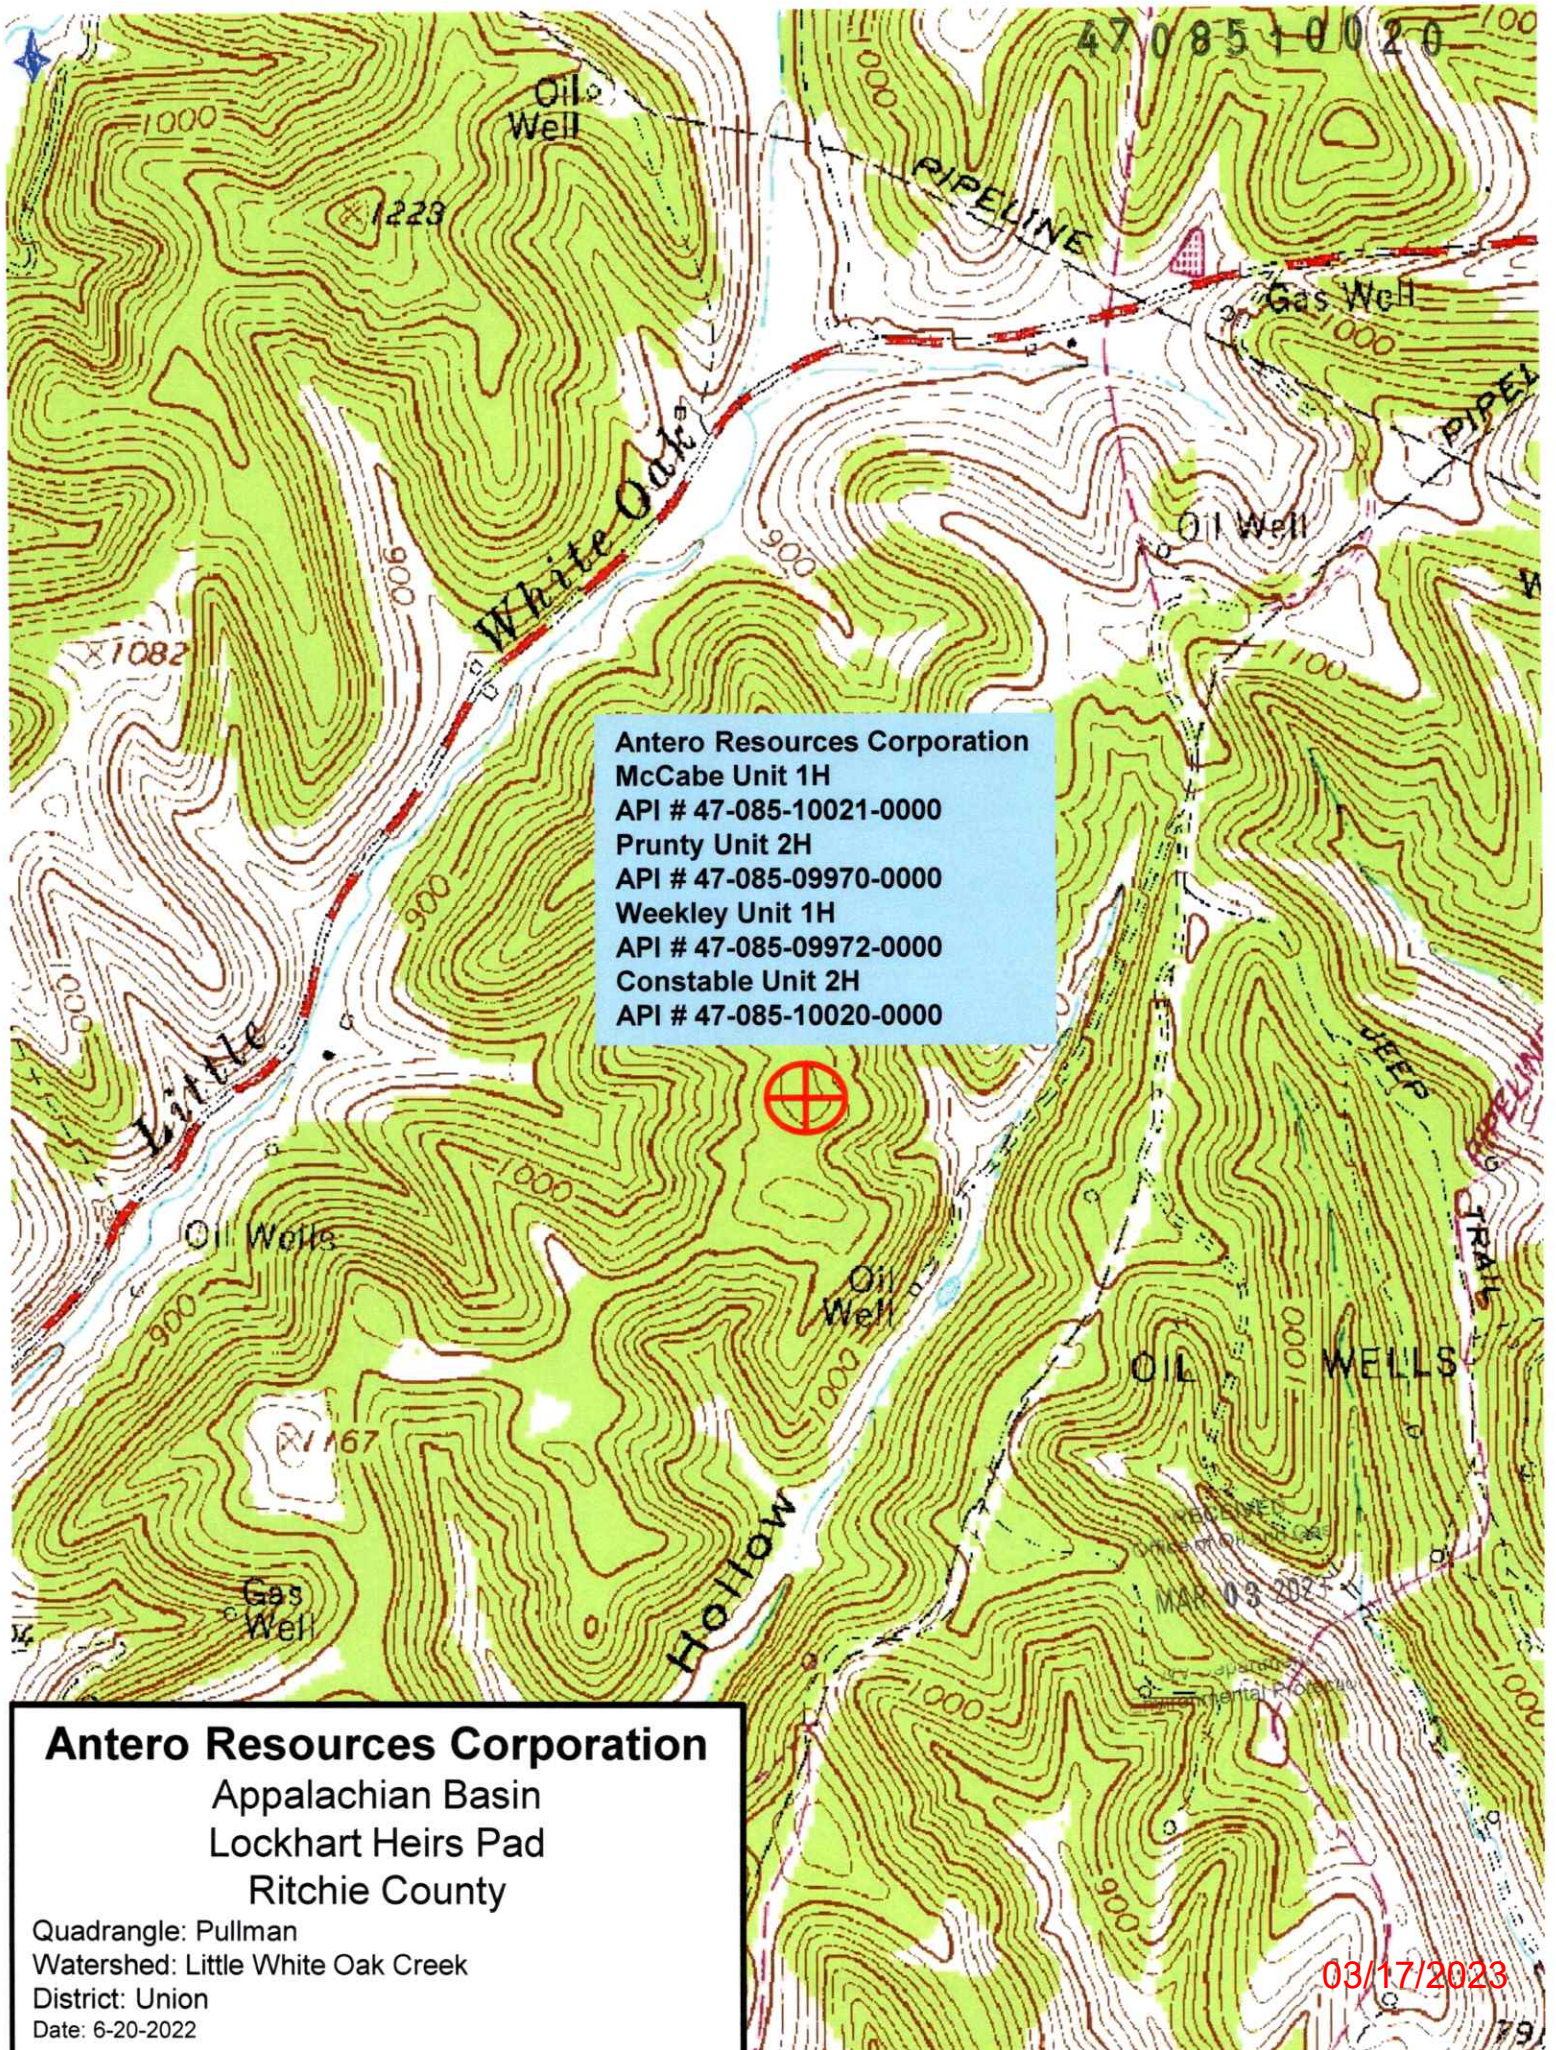

Antero Resources Corporation  
McCabe Unit 1H  
API # 47-085-10021-0000  
Prunty Unit 2H  
API # 47-085-09970-0000  
Weekley Unit 1H  
API # 47-085-09972-0000  
Constable Unit 2H  
API # 47-085-10020-0000

**Antero Resources Corporation**  
Appalachian Basin  
Lockhart Heirs Pad  
Ritchie County

Quadrangle: Pullman  
Watershed: Little White Oak Creek  
District: Union  
Date: 6-20-2022

03/17/2023