



West Virginia Department of Environmental Protection
Office of Oil and Gas
WELL LOCATION FORM: GPS

API: 47-085-10040 P WELL NO.: Steel Run #2 (80615)

FARM NAME: Mike Ross Inc.

RESPONSIBLE PARTY NAME: WVDEP

COUNTY: Ritchie DISTRICT: Grant

QUADRANGLE: Petroleum

SURFACE OWNER: Mike Ross Inc.

ROYALTY OWNER: W.B, Richardson agent for Carle & Cuthbert Heirs

UTM GPS NORTHING: 4340079.0

UTM GPS EASTING: 475936.0 Elevation 861'

The Responsible Party named above has chosen to submit GPS coordinates in lieu of preparing a new well location plat for a plugging permit or assigned API number on the above well. The Office of Oil and Gas will not accept GPS coordinates that do not meet the following requirements:

1. Datum: NAD 1983, Zone: 17 North, Coordinate Units: meters, Altitude: height above mean sea level (MSL) – meters.
2. Accuracy to Datum – 3.05 meters
3. Data Collection Method:

Survey grade GPS _____: Post Processed Differential _____
Real-Time Differential _____

Mapping Grade GPS _____: Post Processed Differential _____
Real-Time Differential _____

4. Letter size copy of the topography map showing the well location.


I the undersigned, hereby certify this data is correct to the best of my knowledge and belief and shows all the information required by law and the regulations issued and prescribed by the Office of Oil and Gas.

Dave Scranage
Signature

Inspector Specialist
Title

Date 4/8/2012

85-10040P

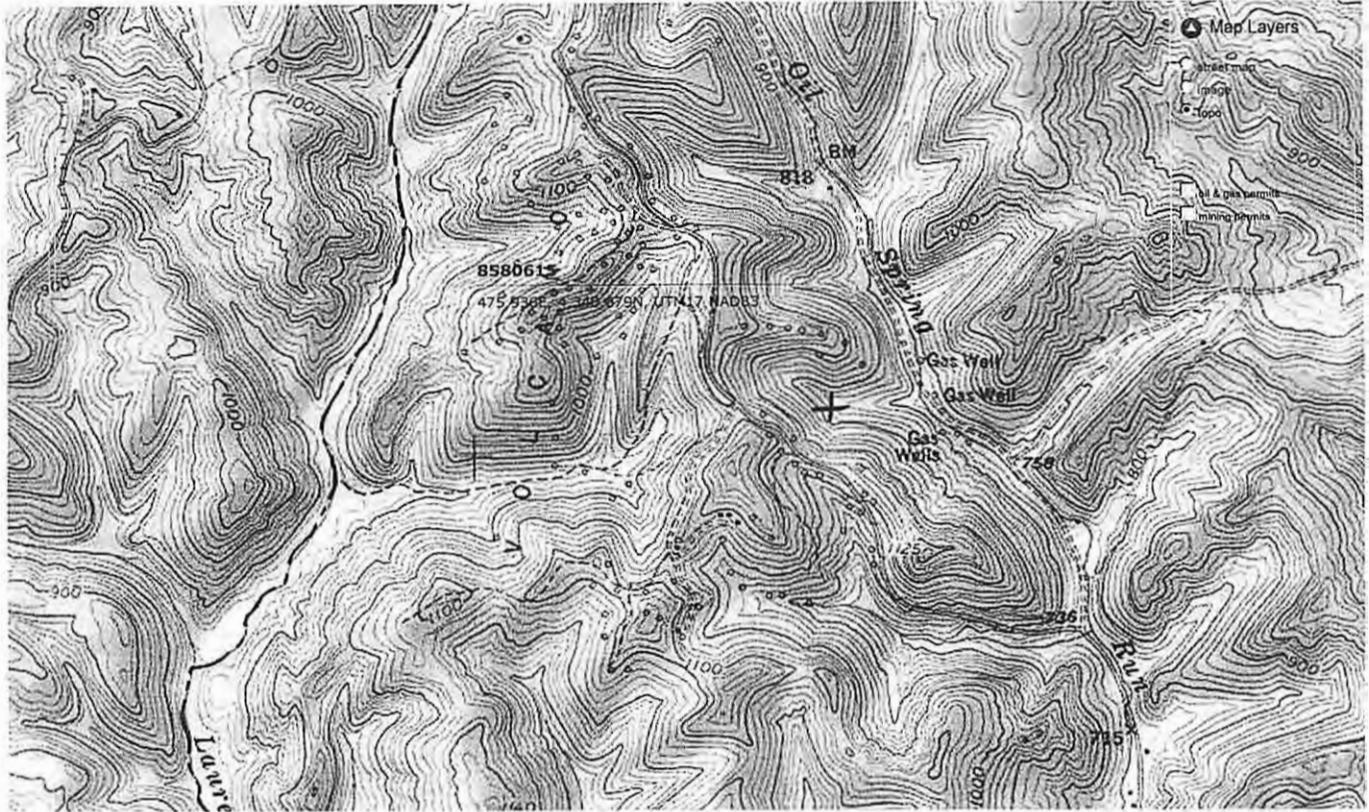

RECEIVED
Office of Oil & Gas

APR 09 2013

WV Department of
Environmental Protection

85-10040 P STELLE RUN 2-80615
UNKNOWN-DEP PAID

FARM NAME: MIKE ROSS INC

<http://tagis.dep.wv.gov/imap/imap.php?x=475936&y=4340079&datum=NAD83&ex=1500...> 4/8/2013

04/12/2013