FORM WW 6

EQT PRODUCTION COMPANY
TAYLOR LEASE
1,600 ACRES±
WELL NO. WV 515276

(S.P.C. NORTH ZONE) (UTM(M) ZONE 17 NORTH)

NAD'27 S.P.C.(FT)	N. 280,805.1	E. 1,589,040.8
NAD'27 GEO.	LAT-(N) 39.261861	LONG-(W) 80.951434
NAD'83 UTM (M)	N. 4,345,846.3	E. 504,204.4
LANDING POINT		
NAD'27 S.P.C.(FT)	N. 282,119.6	E. 1,591,695.1
NAD'27 GEO.	LAT-(N) 39.265587	LONG-(W) 80.942135
NAD'83 UTM (M)	N. 4,346,260.3	E. 505,006.4
BOTTOM HOLE		
NAD'27 S.P.C.(FT)	N. 286,660.2	E. 1,589,577.8
NAD'27 GEO.	LAT-(N) 39.277958	LONG-(W) 80.949871
NAD'83 UTM (M)	N. 4,347,632.8	E. 504,338.3

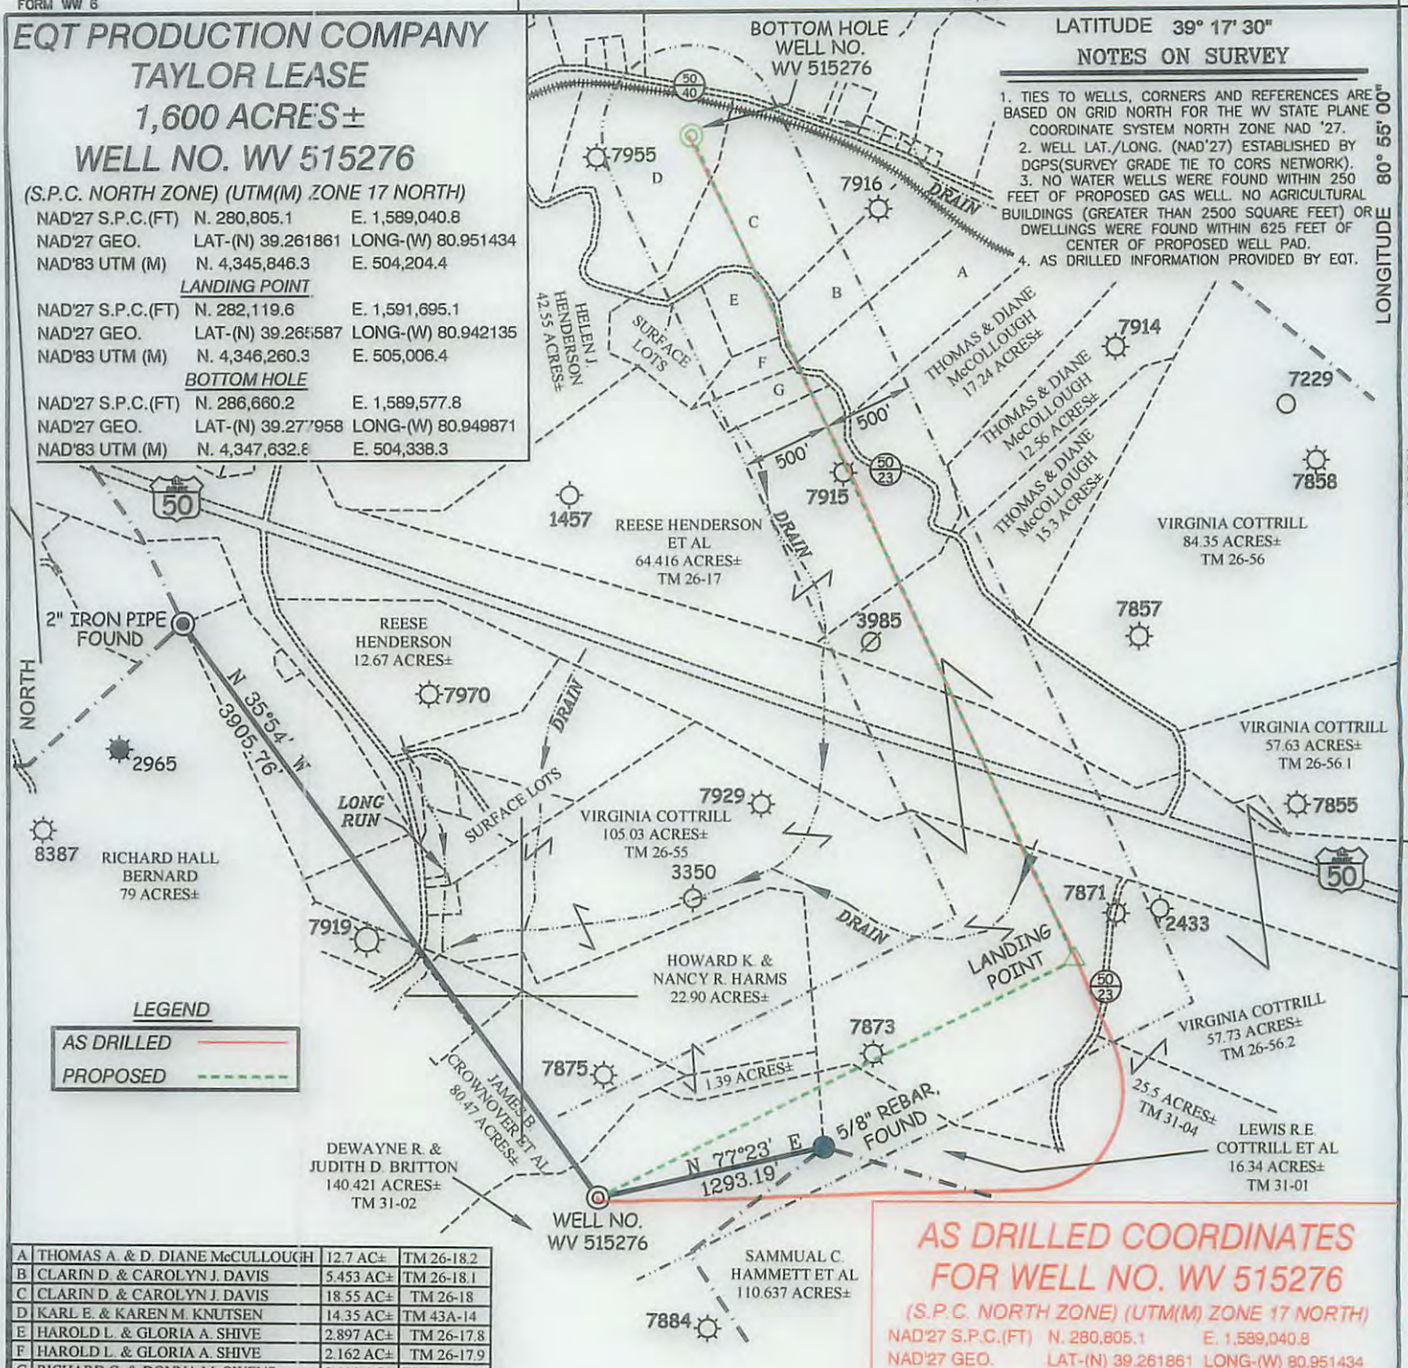

A	THOMAS A. & D. DIANE McCULLOUGH	12.7 AC±	TM 26-18.2
B	CLARIN D. & CAROLYN J. DAVIS	5.453 AC±	TM 26-18.1
C	CLARIN D. & CAROLYN J. DAVIS	18.55 AC±	TM 26-18
D	KARL E. & KAREN M. KNUTSEN	14.35 AC±	TM 43A-14
E	HAROLD L. & GLORIA A. SHIVE	2.897 AC±	TM 26-17.8
F	HAROLD L. & GLORIA A. SHIVE	2.162 AC±	TM 26-17.9
G	RICHARD C. & DONNA M. OWENS	2.110 AC±	TM 26-17.10

Professional Energy Consultants
A DIVISION OF SMITH LAND SURVEYING, INC.
SLS SURVEYORS ENGINEERS ENVIRONMENTAL PROJECT MGMT.
(304) 462-5634 WWW.SLSSURVEYS.COM

AS DRILLED COORDINATES FOR WELL NO. WV 515276

(S.P.C. NORTH ZONE) (UTM(M) ZONE 17 NORTH)

NAD'27 S.P.C.(FT)	N. 280,805.1	E. 1,589,040.8
NAD'27 GEO.	LAT-(N) 39.261861	LONG-(W) 80.951434
NAD'83 UTM (M)	N. 4,345,846.3	E. 504,204.4
BOTTOM HOLE		
NAD'27 S.P.C.(FT)	N. 286,658.4	E. 1,589,559.9
NAD'27 GEO.	LAT-(N) 39.277953	LONG-(W) 80.949935
NAD'83 UTM (M)	N. 4,347,632.2	E. 504,332.8

I THE UNDERSIGNED, HEREBY CERTIFY THAT THIS PLAT IS CORRECT TO THE BEST OF MY KNOWLEDGE AND BELIEF AND SHOWS ALL THE INFORMATION REQUIRED BY LAW AND THE REGULATIONS ISSUED AND PRESCRIBED BY THE DIVISION OF ENVIRONMENTAL PROTECTION.

P.S. 2288 Earl N. Thompson

EARL N. THOMPSON LICENSED No. 2288 STATE OF WEST VIRGINIA PROFESSIONAL SURVEYOR

(+) DENOTES LOCATION OF WELL ON UNITED STATES TOPOGRAPHIC MAPS.

DATE JANUARY 10 , 20 14

REVISED APRIL 08 , 20 15

OPERATORS WELL NO. WV 515276

API WELL NO. 47 — 085 — 10094-H
STATE COUNTY PERMIT

MINIMUM DEGREE OF ACCURACY 1 / 200

PROVEN SOURCE OF ELEVATION DGPS (SURVEY GRADE TIE TO CORS NETWORK)

FILE NO. 7496AD515276

SCALE 1" = 1000'

STATE OF WEST VIRGINIA
DIVISION OF ENVIRONMENTAL PROTECTION
OFFICE OF OIL AND GAS

WELL TYPE: OIL ___ GAS X LIQUID INJECTION ___ WASTE DISPOSAL ___ IF "GAS" PRODUCTION X STORAGE ___ DEEP ___ SHALLOW X

LOCATION:

ELEVATION 1,119' (PAD ELEVATION) WATERSHED LONG RUN OF NORTH FORK HUGHES RIVER

DISTRICT CLAY COUNTY RITCHIE QUADRANGLE PENNSBORO 7.5'

SURFACE OWNER DEWAYNE BRITTON ET UX ACREAGE 140.421

ROYALTY OWNER E. R. TAYLOR HEIRS ACREAGE 1,600± 10/09/2015

PROPOSED WORK: 105804

DRILL X CONVERT ___ DRILL DEEPER ___ REDRILL ___ FRACTURE OR STIMULATE X PLUG OFF OLD FORMATION ___ PERFORATE NEW FORMATION ___ PLUG AND ABANDON ___ CLEAN OUT AND REPLUG ___ OTHER ___

PHYSICAL CHANGE IN WELL (SPECIFY) ___ TARGET FORMATION MARCELLUS

ESTIMATED DEPTH ___

COUNTY NAME PERMIT

WELL OPERATOR EQT PRODUCTION COMPANY DESIGNATED AGENT REX C. RAY

ADDRESS 115 PROFESSIONAL PLACE P.O. BOX 280 BRIDGEPORT, WV 26330

ADDRESS 115 PROFESSIONAL PLACE BRIDGEPORT, WV 26330