

WW-7  
8-30-06



West Virginia Department of Environmental Protection  
Office of Oil and Gas  
**WELL LOCATION FORM: GPS**

API: 47-085- 10160 WELL NO.: Steel Run #5 (80619)

FARM NAME: Mike Ross Inc.

RESPONSIBLE PARTY NAME: WVDEP  
COUNTY: Ritchie 95 DISTRICT: Grant 02

QUADRANGLE: Petroleum 544

SURFACE OWNER: Mike Ross Inc.

ROYALTY OWNER: W.B, Richardson agent for Carle & Cuthbert Heirs

UTM GPS NORTHING: 4340150.0

UTM GPS EASTING: 476099.0 Elevation 864'

The Responsible Party named above has chosen to submit GPS coordinates in lieu of preparing a new well location plat for a plugging permit or assigned API number on the above well. The Office of Oil and Gas will not accept GPS coordinates that do not meet the following requirements:

1. Datum: NAD 1983, Zone: 17 North, Coordinate Units: meters, Altitude: height above mean sea level (MSL) – meters.
2. Accuracy to Datum – 3.05 meters
3. Data Collection Method:  
Survey grade GPS \_\_\_\_ : Post Processed Differential \_\_\_\_  
Real-Time Differential \_\_\_\_  
Mapping Grade GPS \_\_\_\_ : Post Processed Differential \_\_\_\_  
Real-Time Differential \_\_\_\_
4. **Letter size copy of the topography map showing the well location.**

I the undersigned, hereby certify this data is correct to the best of my knowledge and belief and shows all the information required by law and the regulations issued and prescribed by the Office of Oil and Gas.

Dave Gilbert  
Signature


Inspector Specialist  
Title

Date 9/8/2012

Received

9/8/2012

Office of Oil and Gas  
Department of Environmental Protection

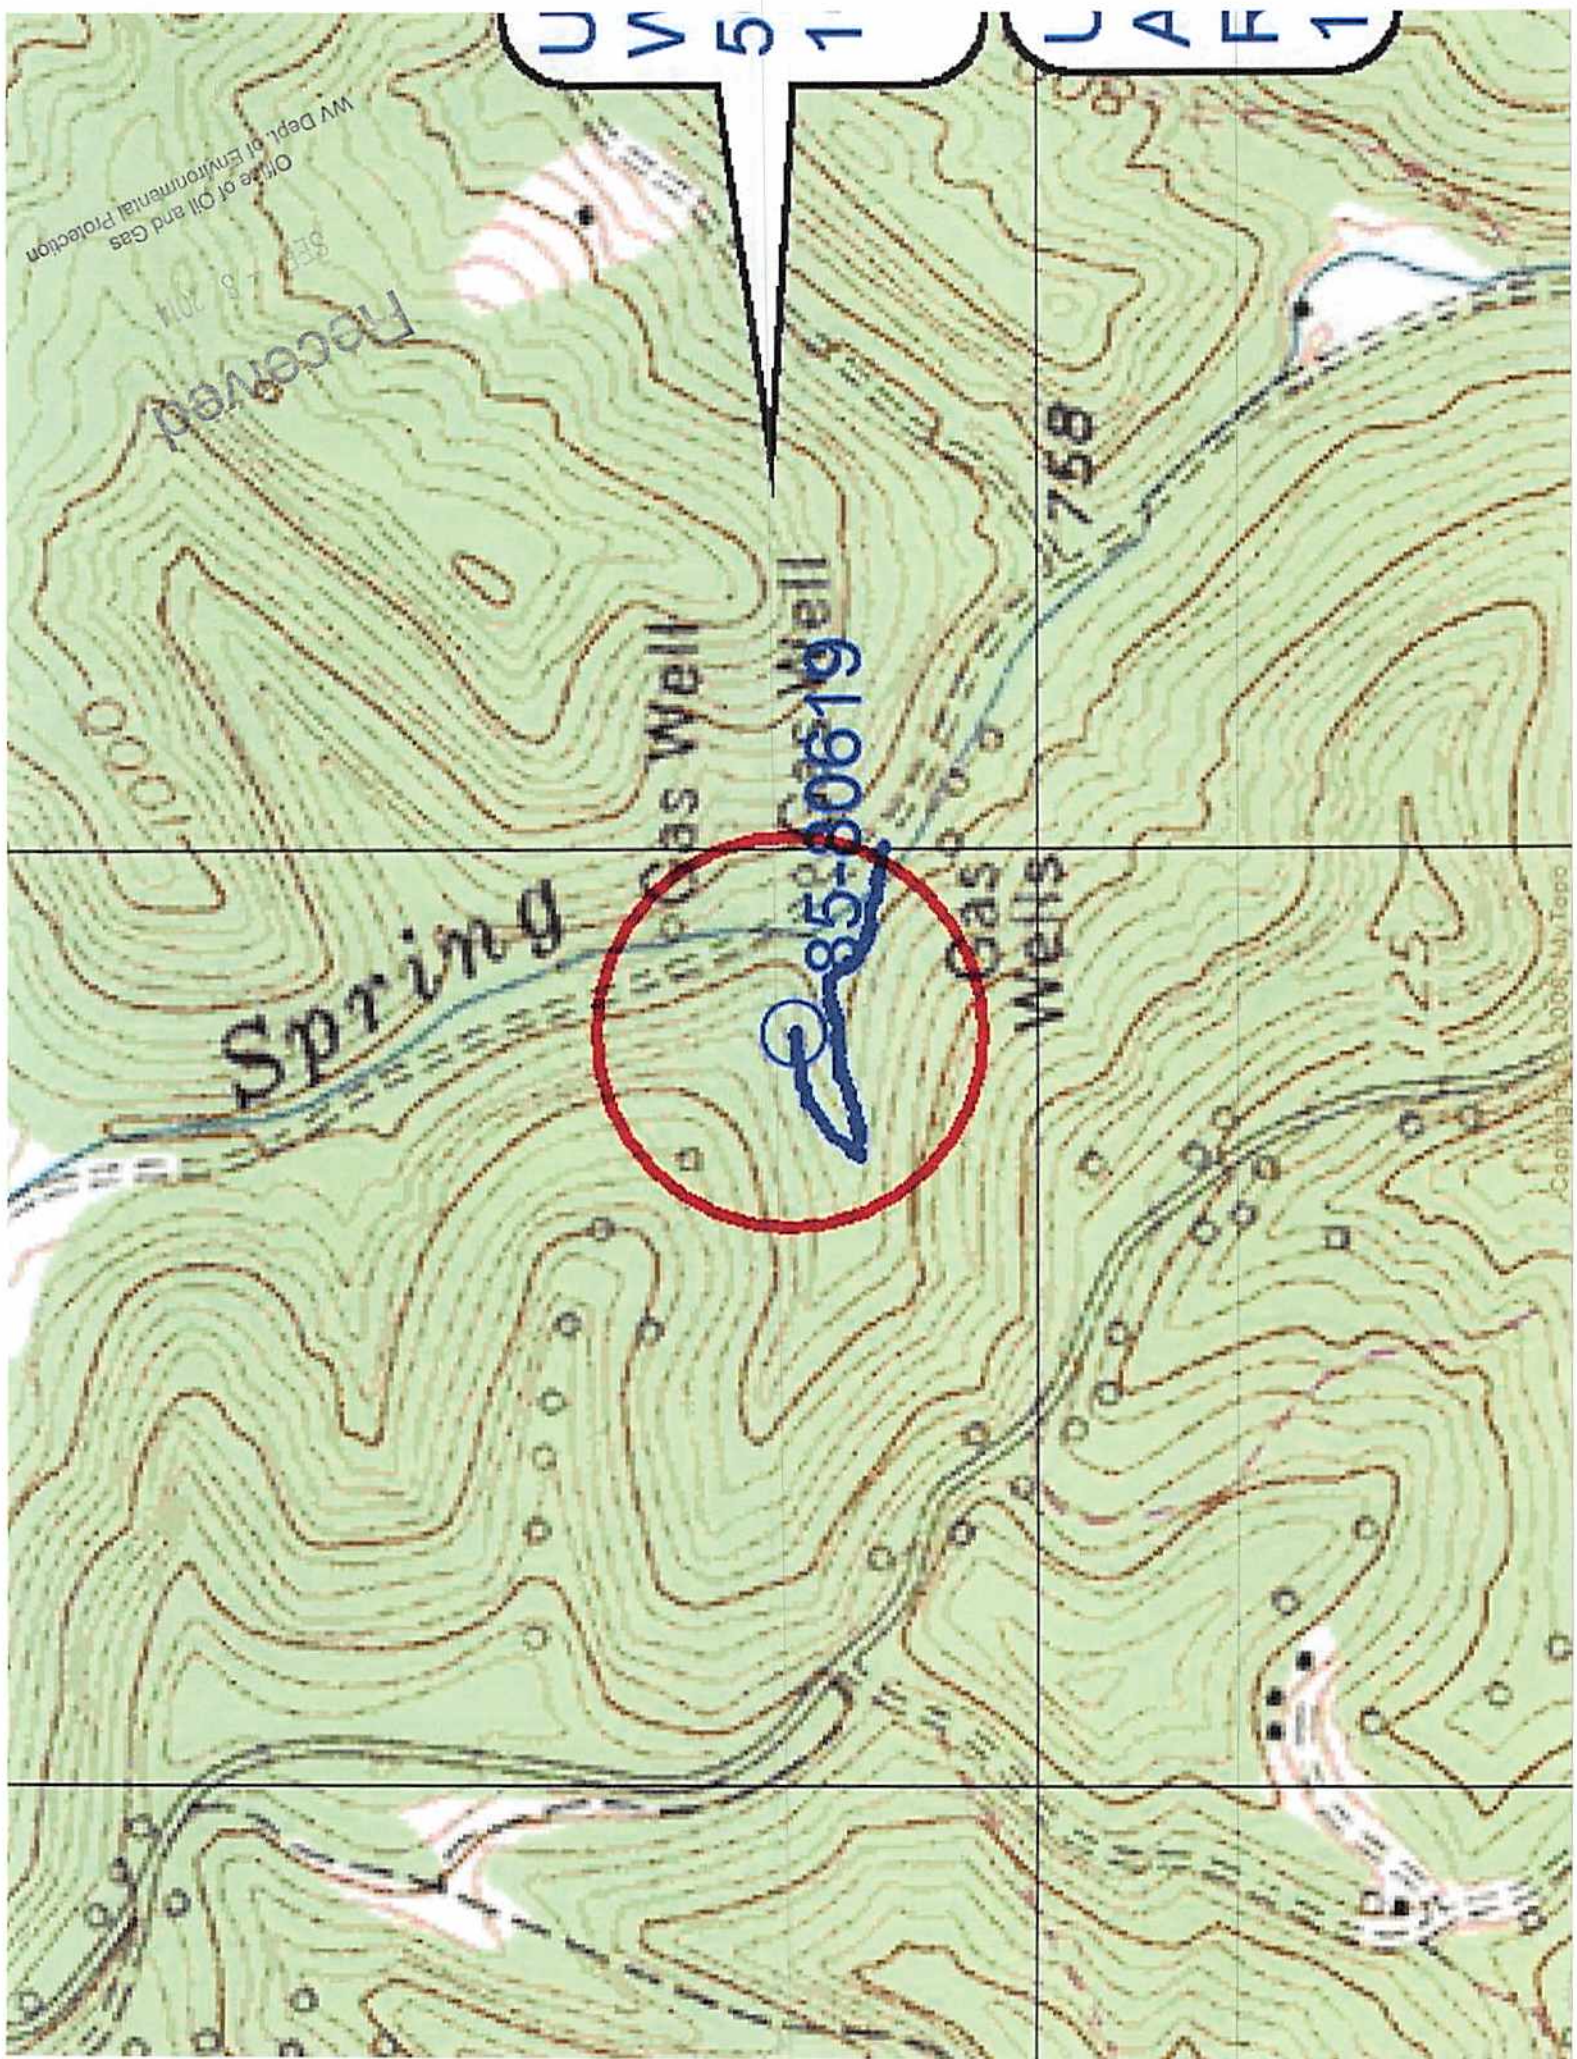

Office of Oil and Gas  
WV Dept. of Environmental Protection

Received  
SEP - 8 2014

U V 5 1

U A F 1

Spring

Gas Well  
85-00619

Gas Wells

758

