

LATITUDE 39°20'00" | 1,506'


LATITUDE 39°17'30"

LONGITUDE 80°55'00"

4,066' TO BOTTOM HOLE

12,313'

LONGITUDE 80°57'30"

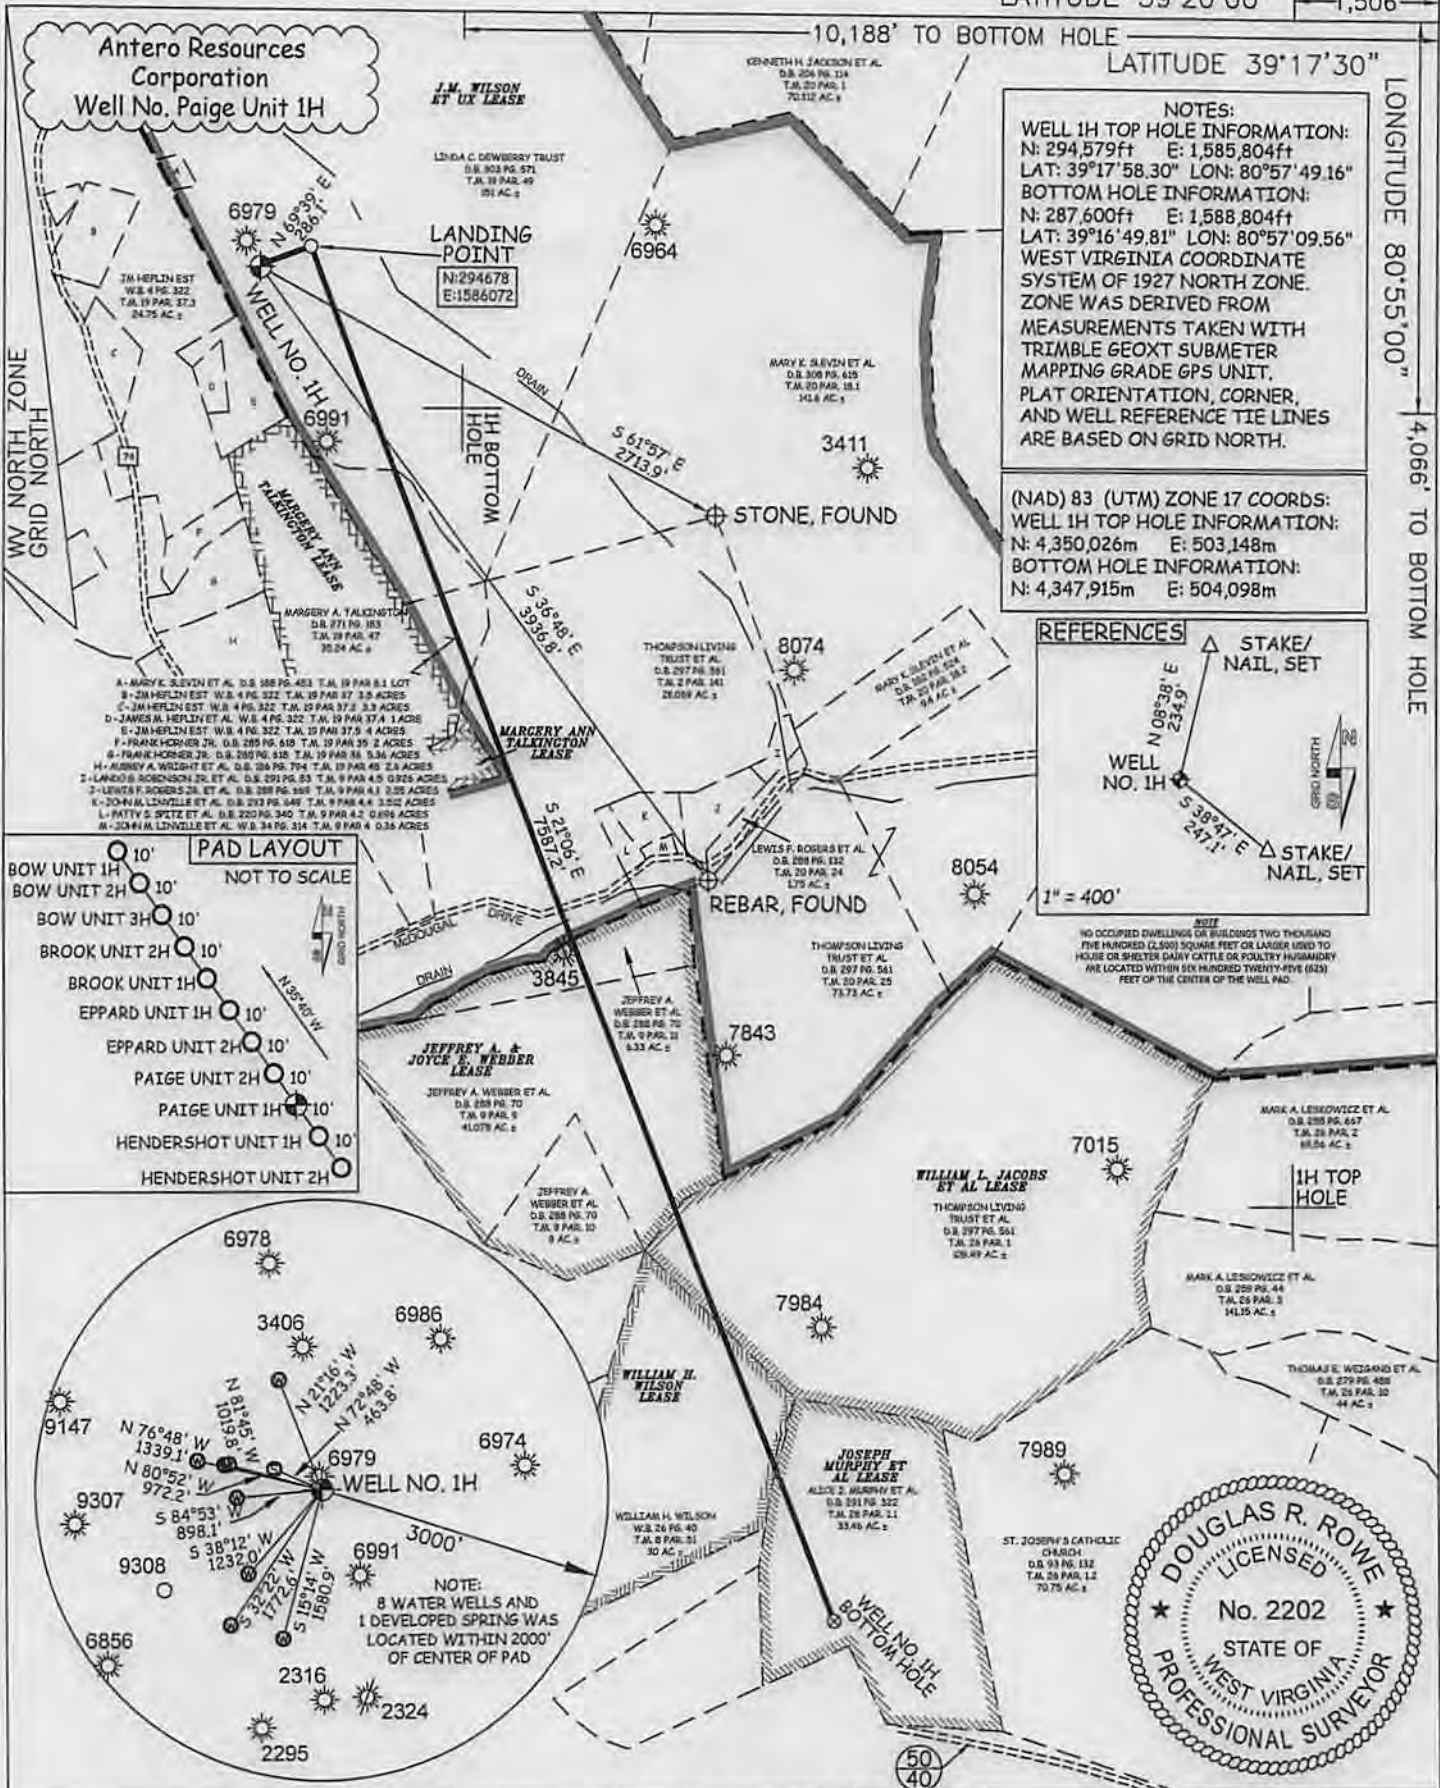

JOB # 14-001WA
DRAWING # PAIGE1HR1
SCALE 1" = 1000'
MINIMUM DEGREE OF ACCURACY SUBMETER
PROVEN SOURCE OF ELEV. SUBMETER MAPPING GRADE GPS

I THE UNDERSIGNED, HEREBY CERTIFY THAT THIS PLAT IS CORRECT TO THE BEST OF MY KNOWLEDGE AND BELIEF AND SHOWS ALL THE INFORMATION REQUIRED BY LAW AND THE RULES ISSUED AND PERSCRIBED BY THE DEPARTMENT OF ENVIRONMENTAL PROTECTION.



STATE OF WEST VIRGINIA, DIVISION OF ENVIRONMENTAL PROTECTION, OFFICE OF OIL AND GAS

WILLOW LAND SURVEYING PLLC
266 HUSHERS RUN RD PENNSBORO WEST VIRGINIA 26415

LEGEND
DOUGLAS R. ROWE P.S. 2202

DATE 08/29/14
OPERATOR'S WELL# PAIGE UNIT #1H
API WELL # 47 - 085 - 10165
STATE COUNTY PERMIT

STATE OF WEST VIRGINIA DEPARTMENT OF ENERGY DIVISION OF OIL AND GAS
WELL TYPE: OIL GAS X LIQUID INJECTION WASTE DISPOSAL
(IF "GAS") PRODUCTION X STORAGE DEEP SHALLOW X
LOCATION: ELEVATION 1,118' WATERSHED BUNNELL RUN
QUADRANGLE PENNSBORO 7.5' DISTRICT CLAY COUNTY RITCHIE

SURFACE OWNER LINDA C. DEWBERRY TRUST ACREAGE 151 ACRES +/-
OIL & GAS ROYALTY OWNER J.M. WILSON ET UX; JEFFREY A. & JOYCE E. WEBBER; LEASE ACREAGE 700 ACRES+; 56.325 ACRES+;
WILLIAM L. JACOBS ET AL; WILLIAM H. WILSON; JOSEPH MURPHY ET AL; 85 ACRES±; 30 ACRES±; 33 ACRES±;


PROPOSED WORK: DRILL X CONVERT DRILL DEEPER REDRILL FRACTURE OR STIMULATE X
PLUG OFF OLD FORMATION PERFORATE NEW FORMATION X OTHER PHYSICAL CHANGE IN WELL (SPECIFY) PLUG & ABANDON CLEAN OUT & REPLUG
TARGET FORMATION MARCELLUS ESTIMATED DEPTH 6,700' TVD 14,900' MD

WELL OPERATOR ANTERO RESOURCES CORP DESIGNATED AGENT DIANNA STAMPER
ADDRESS 1615 WYNKOOP STREET ADDRESS 5400 D BIG TYLER ROAD
FORM WW-6 DENVER, CO 80202 CHARLESTON, WV 25313

COUNTY NAME PERMIT

10/31/2014

85-10165

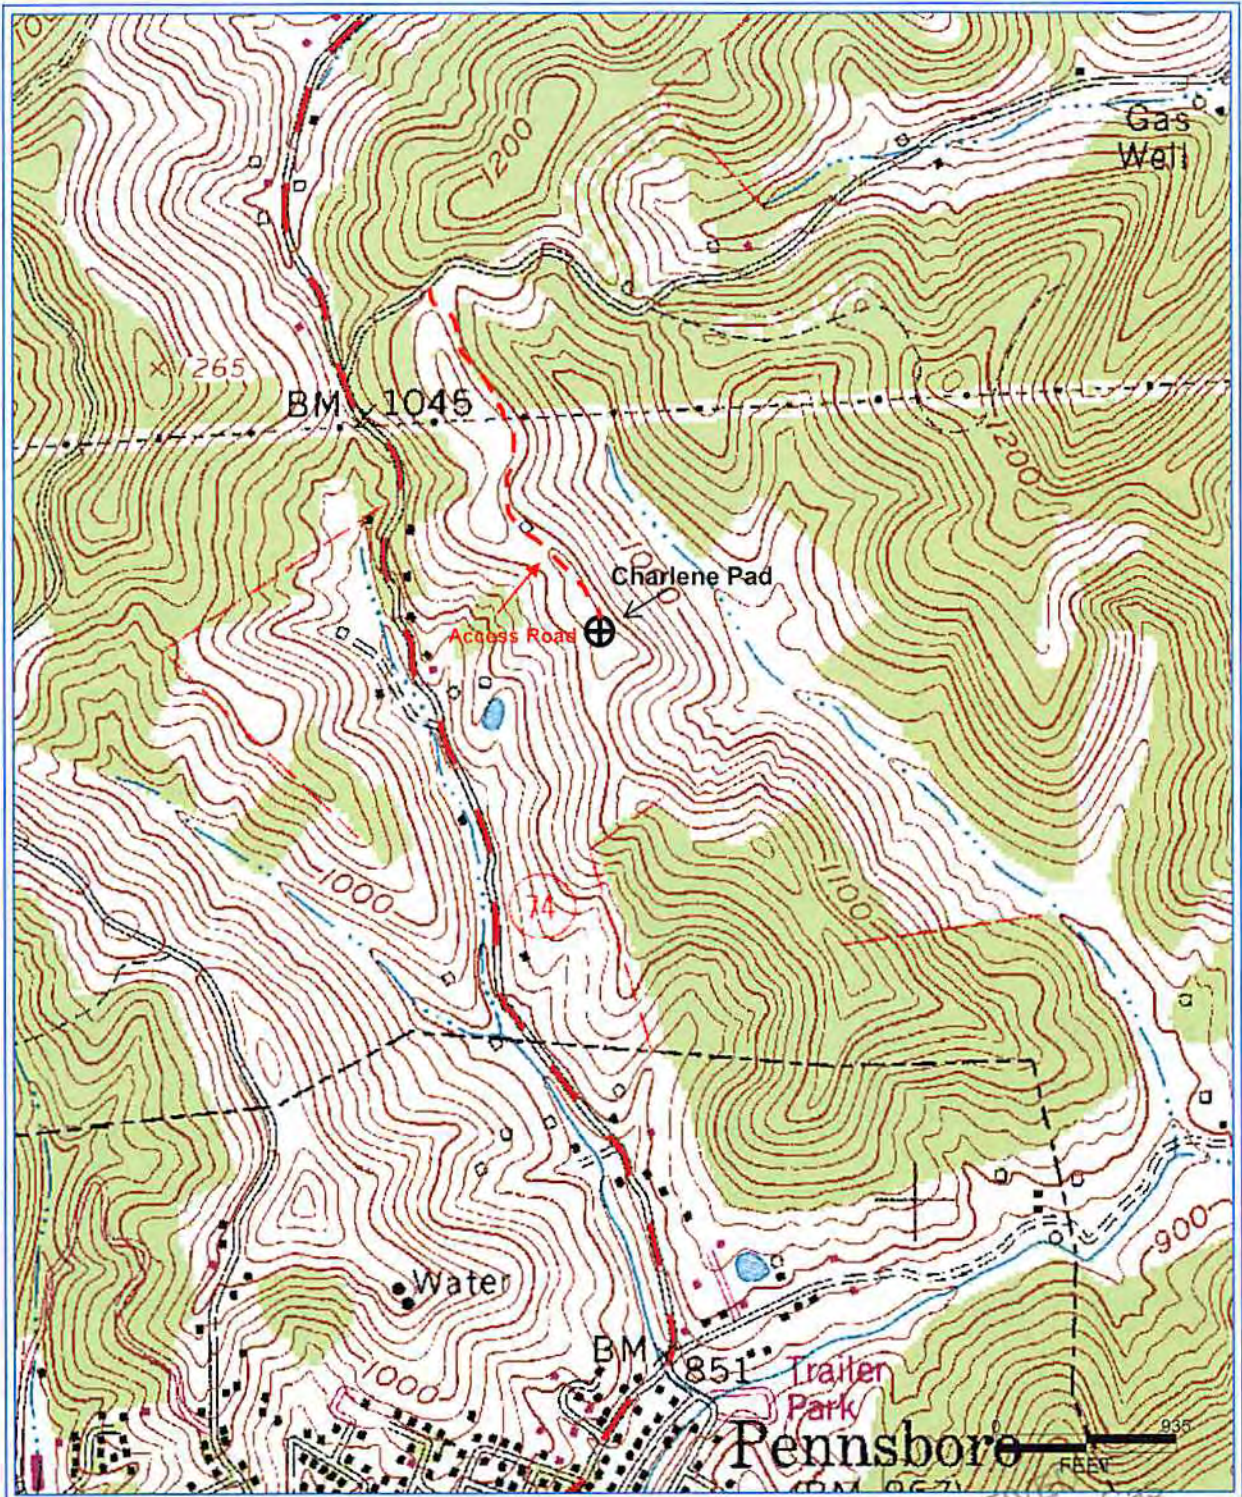

PETRA 8/8/2013 10:20:03 AM

Antero Resources Corporation

Appalachian Basin

Paige Unit 1H

Ritchie County

Quadrangle: Pennsboro

Watershed: North Fork Hughes River

District: Clay

Date: 8-8-2013

RECEIVED
Office of Oil and Gas
SEP 11 2014
WV Department of
Environmental Protection