

GRID NORTH

**WV 515977**  
**EQT Production Company**  
**James D. Wilson**  
**53 Acres**


Well References  
 Pullman 96 47-85-01540  
 H10 515977 N 87°10'18" E  
 149 38'

S 47°47'50" W  
 450 41'

\*47-85-08973

1" = 200'

**As-Drilled information**  
 WV 515977 coordinates are  
 NAD 27 N 262,445 77 E 1,578,914 31  
 NAD 83 UTM N 4,340,201 64 E 501,212 87  
 WV 515977 Landing Point coordinates are  
 NAD 27 N 262,249 27 E 1 381,595 01  
 NAD 83 UTM N 4,340,155 43 E 502,030 53  
 WV 515977 Bottom Hole coordinates are  
 NAD 27 N 259,490 87 E 1,582,355 81  
 NAD 83 UTM N 4,339,318 97 E 502 276.34  
 West Virginia Coordinate system of 1927 (North Zone)  
 Geographic coordinates are NAD27  
 UTM coordinates are NAD83, Zone 17, Meters  
 Plat orientation, corner and well ties are based upon the  
 grid north meridian  
 Well location references are based upon the grid north  
 meridian

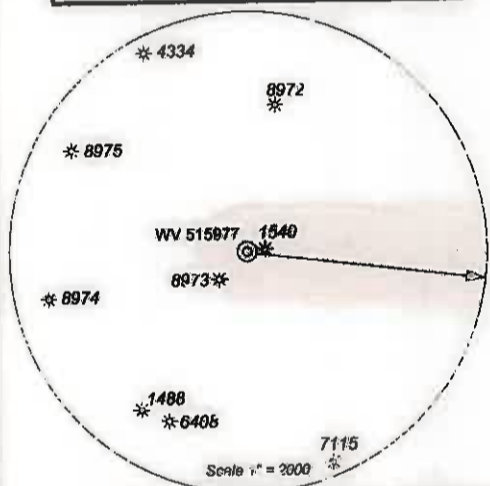

(⊙) Denotes Location of Well on United States Topographic Maps



*I, the undersigned, hereby certify that this plat is correct to the best of my knowledge and belief and shows all the information required by law and the regulations issued and prescribed by the Department of Environmental Protection.*

*Wayne A Hall*  
 P.S. 2089SU



FILE NO 243-14  
 DRAWING NO 243-14 Pullman 96 H10.dwg  
 SCALE 1" = 2000'  
 MINIMUM DEGREE OF ACCURACY 1 2500  
 PROVEN SOURCE OF ELEVATION NGS CORS Station

**STATE OF WEST VIRGINIA**  
 DEPARTMENT OF ENVIRONMENTAL PROTECTION  
**OIL AND GAS DIVISION**

DATE February 22 20 16  
 OPERATOR'S WELL NO 515977  
 API WELL NO 47 - 85 - 10210  
 STATE COUNTY PERMIT

WELL TYPE:  OIL  GAS  LIQUID INJECTION  WASTE DISPOSAL  
 (IF GAS) PRODUCTION:  STORAGE  DEEP  SHALLOW

LOCATION ELEVATION: Original 1194' Proposed 1182' WATERSHED Goose Run of Rockcamp Run QUADRANGLE: Pullman  
 DISTRICT Union COUNTY: Ritchie

SURFACE OWNER: James H. & Wilma J. Wilson ACREAGE: 40.089  
 ROYALTY OWNER: Laune Ann Haddox, et al LEASE NO 919995 ACREAGE: 360

PROPOSED WORK:  DRILL  CONVERT  DRILL DEEPER  FRACTURE OR STIMULATE  PLUG OFF OLD FORMATION  
 PERFORATE NEW FORMATION  OTHER PHYSICAL CHANGE IN WELL (SPECIFY) \_\_\_\_\_  
 PLUG AND ABANDON  CLEAN OUT AND REPLUG TARGET FORMATION: Marcellus ESTIMATED DEPTH: TVD 6,396

WELL OPERATOR: EQT Production Company DESIGNATED AGENT: Rex C. Ray  
 ADDRESS: PO Box 280 / 115 Professional Place ADDRESS: PO Box 280 / 115 Professional Place  
Bridgeport, WV 26330 Bridgeport, WV 26330