

4708510234^R

WW-7
8-30-06



West Virginia Department of Environmental Protection
Office of Oil and Gas
WELL LOCATION FORM: GPS

API: 47-085-10234 WELL NO.: Mogar 2H

FARM NAME: Bison

RESPONSIBLE PARTY NAME: Antero Resources Corporation

COUNTY: Ritchie DISTRICT: Clay

QUADRANGLE: Pennsboro

SURFACE OWNER: Donald L. & Patricia L. Costilow

ROYALTY OWNER: _____

UTM GPS NORTHING: 4349550.36 m

UTM GPS EASTING: 508520.56 m GPS ELEVATION: 1220.5 ft

The Responsible Party named above has chosen to submit GPS coordinates in lieu of preparing a new well location plat for a plugging permit or assigned API number on the above well. The Office of Oil and Gas will not accept GPS coordinates that do not meet the following requirements:

1. Datum: NAD 1983, Zone: 17 North, Coordinate Units: meters, Altitude: height above mean sea level (MSL) – meters.
2. Accuracy to Datum – 3.05 meters
3. Data Collection Method:

Survey grade GPS : Post Processed Differential _____
Real-Time Differential

Mapping Grade GPS : Post Processed Differential _____
Real-Time Differential


4. Letter size copy of the topography map showing the well location.

I the undersigned, hereby certify this data is correct to the best of my knowledge and belief and shows all the information required by law and the regulations issued and prescribed by the Office of Oil and Gas.

[Signature]
Signature

Permitting Manager
Title

5/10/22
Date

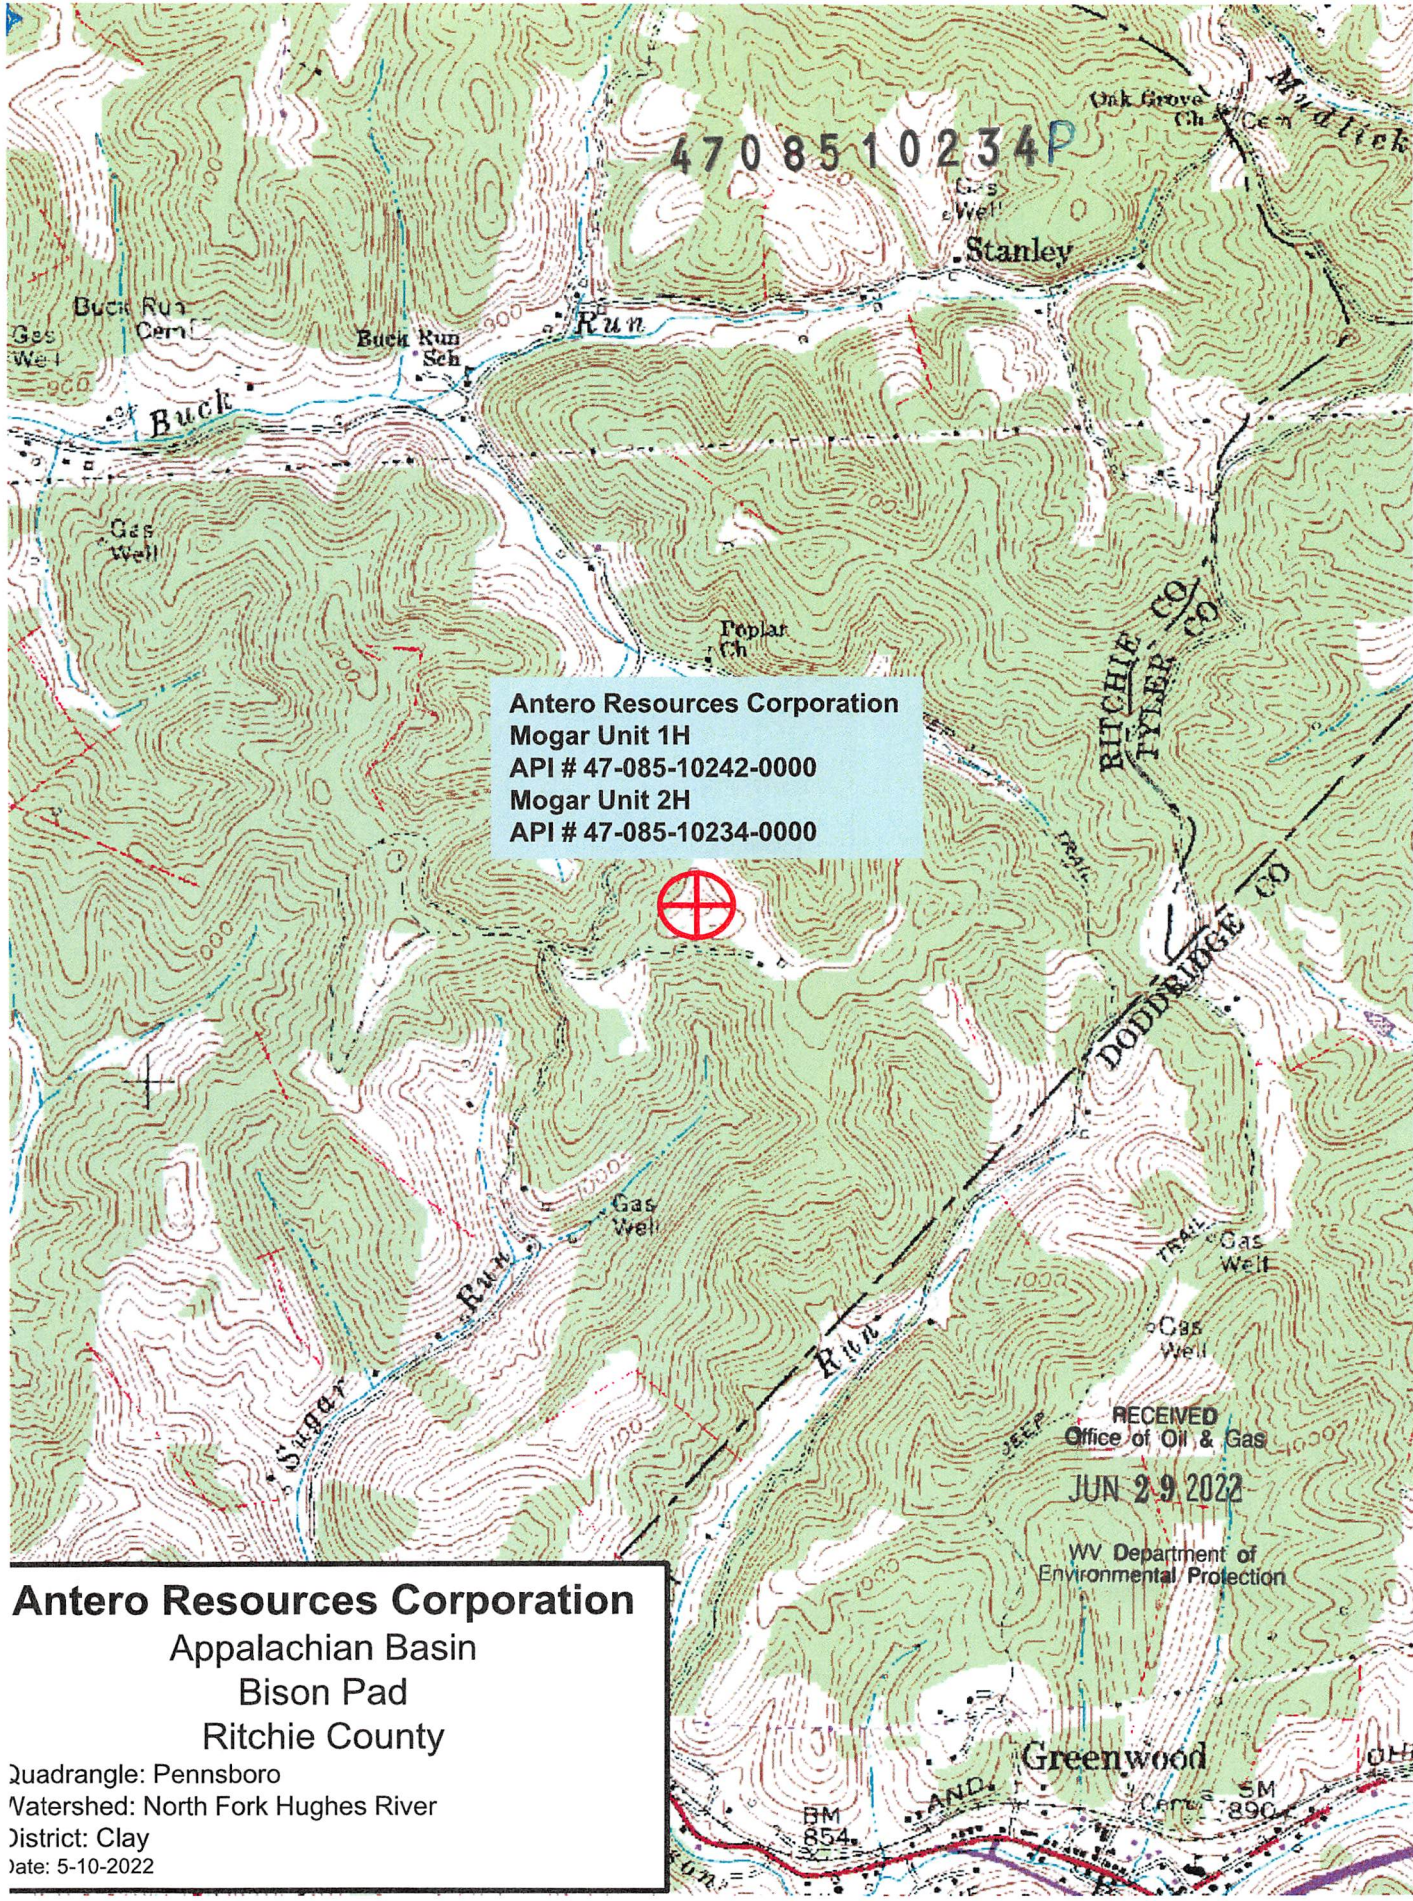

4708510234P

Antero Resources Corporation
Mogar Unit 1H
API # 47-085-10242-0000
Mogar Unit 2H
API # 47-085-10234-0000



RECEIVED
Office of Oil & Gas
JUN 29 2022

WV Department of
Environmental Protection

Antero Resources Corporation
Appalachian Basin
Bison Pad
Ritchie County

Quadrangle: Pennsboro
Watershed: North Fork Hughes River
District: Clay
Date: 5-10-2022