

WW-7
8-30-06



West Virginia Department of Environmental Protection
Office of Oil and Gas
WELL LOCATION FORM: GPS

API: 47-085-10283 WELL NO.: Anderson 3H

FARM NAME: Bachelor

RESPONSIBLE PARTY NAME: Antero Resources Corporation

COUNTY: Ritchie DISTRICT: Clay

QUADRANGLE: Ellenboro & Pennsboro

SURFACE OWNER: Marion E. Bachelor, et al

Frankie Bachelor et al; Donzil Leroy Baker; Donzil Leroy Baker et al; Donzil Leroy Baker et ux; Diano S. Cline et al; Ann Anderson et al; Key Oil Company; Michael L. Davis, James E. Raines et al; Charles E. Giebel et al; Phyllis J. Maxwell; Gale F. Tingler

ROYALTY OWNER: _____

UTM GPS NORTHING: 4351343.28 m

UTM GPS EASTING: 498703.46 m GPS ELEVATION: 1192.9 ft

The Responsible Party named above has chosen to submit GPS coordinates in lieu of preparing a new well location plat for a plugging permit or assigned API number on the above well. The Office of Oil and Gas will not accept GPS coordinates that do not meet the following requirements:

- Datum: NAD 1983, Zone: 17 North, Coordinate Units: meters, Altitude: height above mean sea level (MSL) – meters.
- Accuracy to Datum – 3.05 meters
- Data Collection Method:

Survey grade GPS X: Post Processed Differential _____
Real-Time Differential X

Mapping Grade GPS X: Post Processed Differential _____
Real-Time Differential X

- Letter size copy of the topography map showing the well location.

I the undersigned, hereby certify this data is correct to the best of my knowledge and belief and shows all the information required by law and the regulations issued and prescribed by the Office of Oil and Gas.

May 5/22
Signature


Permitting Manager
Title

4/19/22
Date

RECEIVED
Office of Oil and Gas

APR 26 2022

WV Department of
Environmental Protection

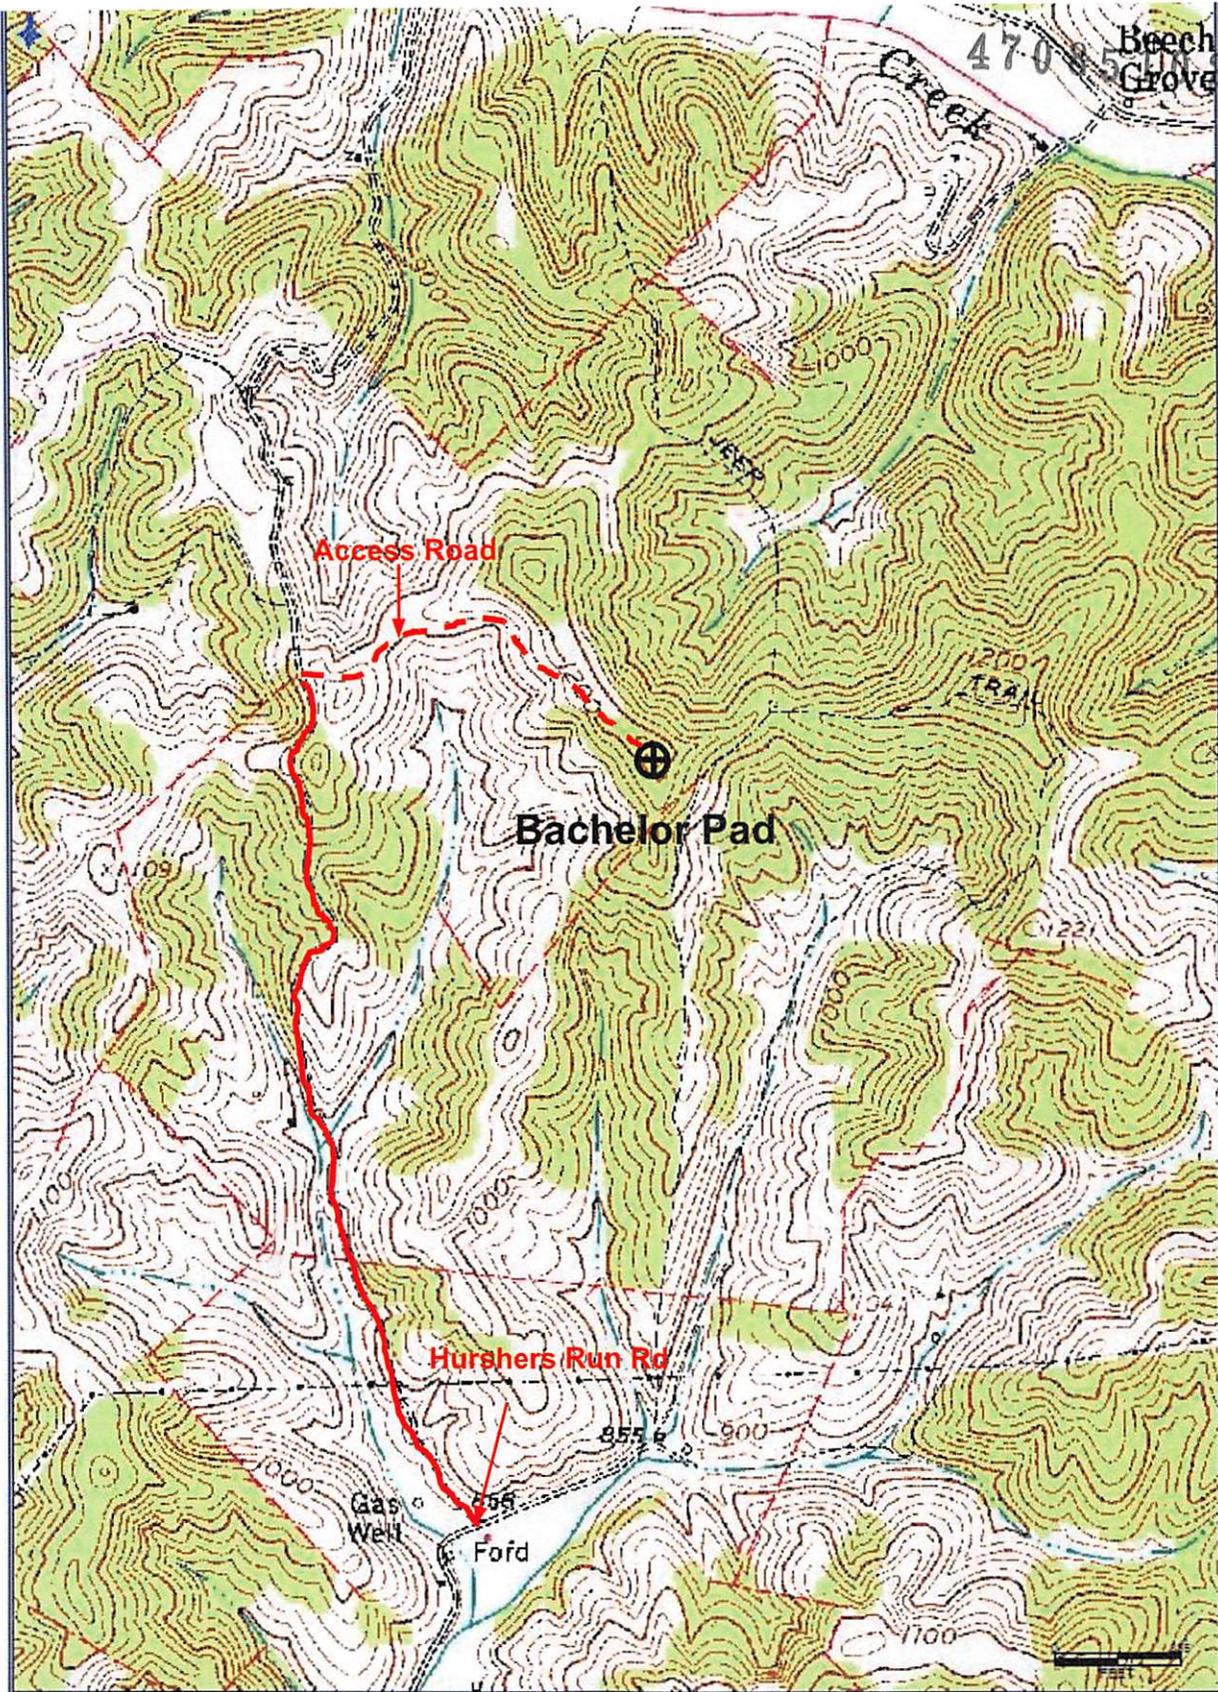

Antero Resources Corporation

Appalachian Basin

Bachelor Pad

Ritchie County

Quadrangle: Ellenboro

Watershed: North Fork Hughes River

District: Clay

06/10/2022