

LATITUDE 39°20'00"


5,589'

1,006' TO BOTTOM HOLE
LATITUDE 39°17'30"

4,527' TO BOTTOM HOLE
LONGITUDE 80°57'30"

12,588'




LONGITUDE 80°57'30"

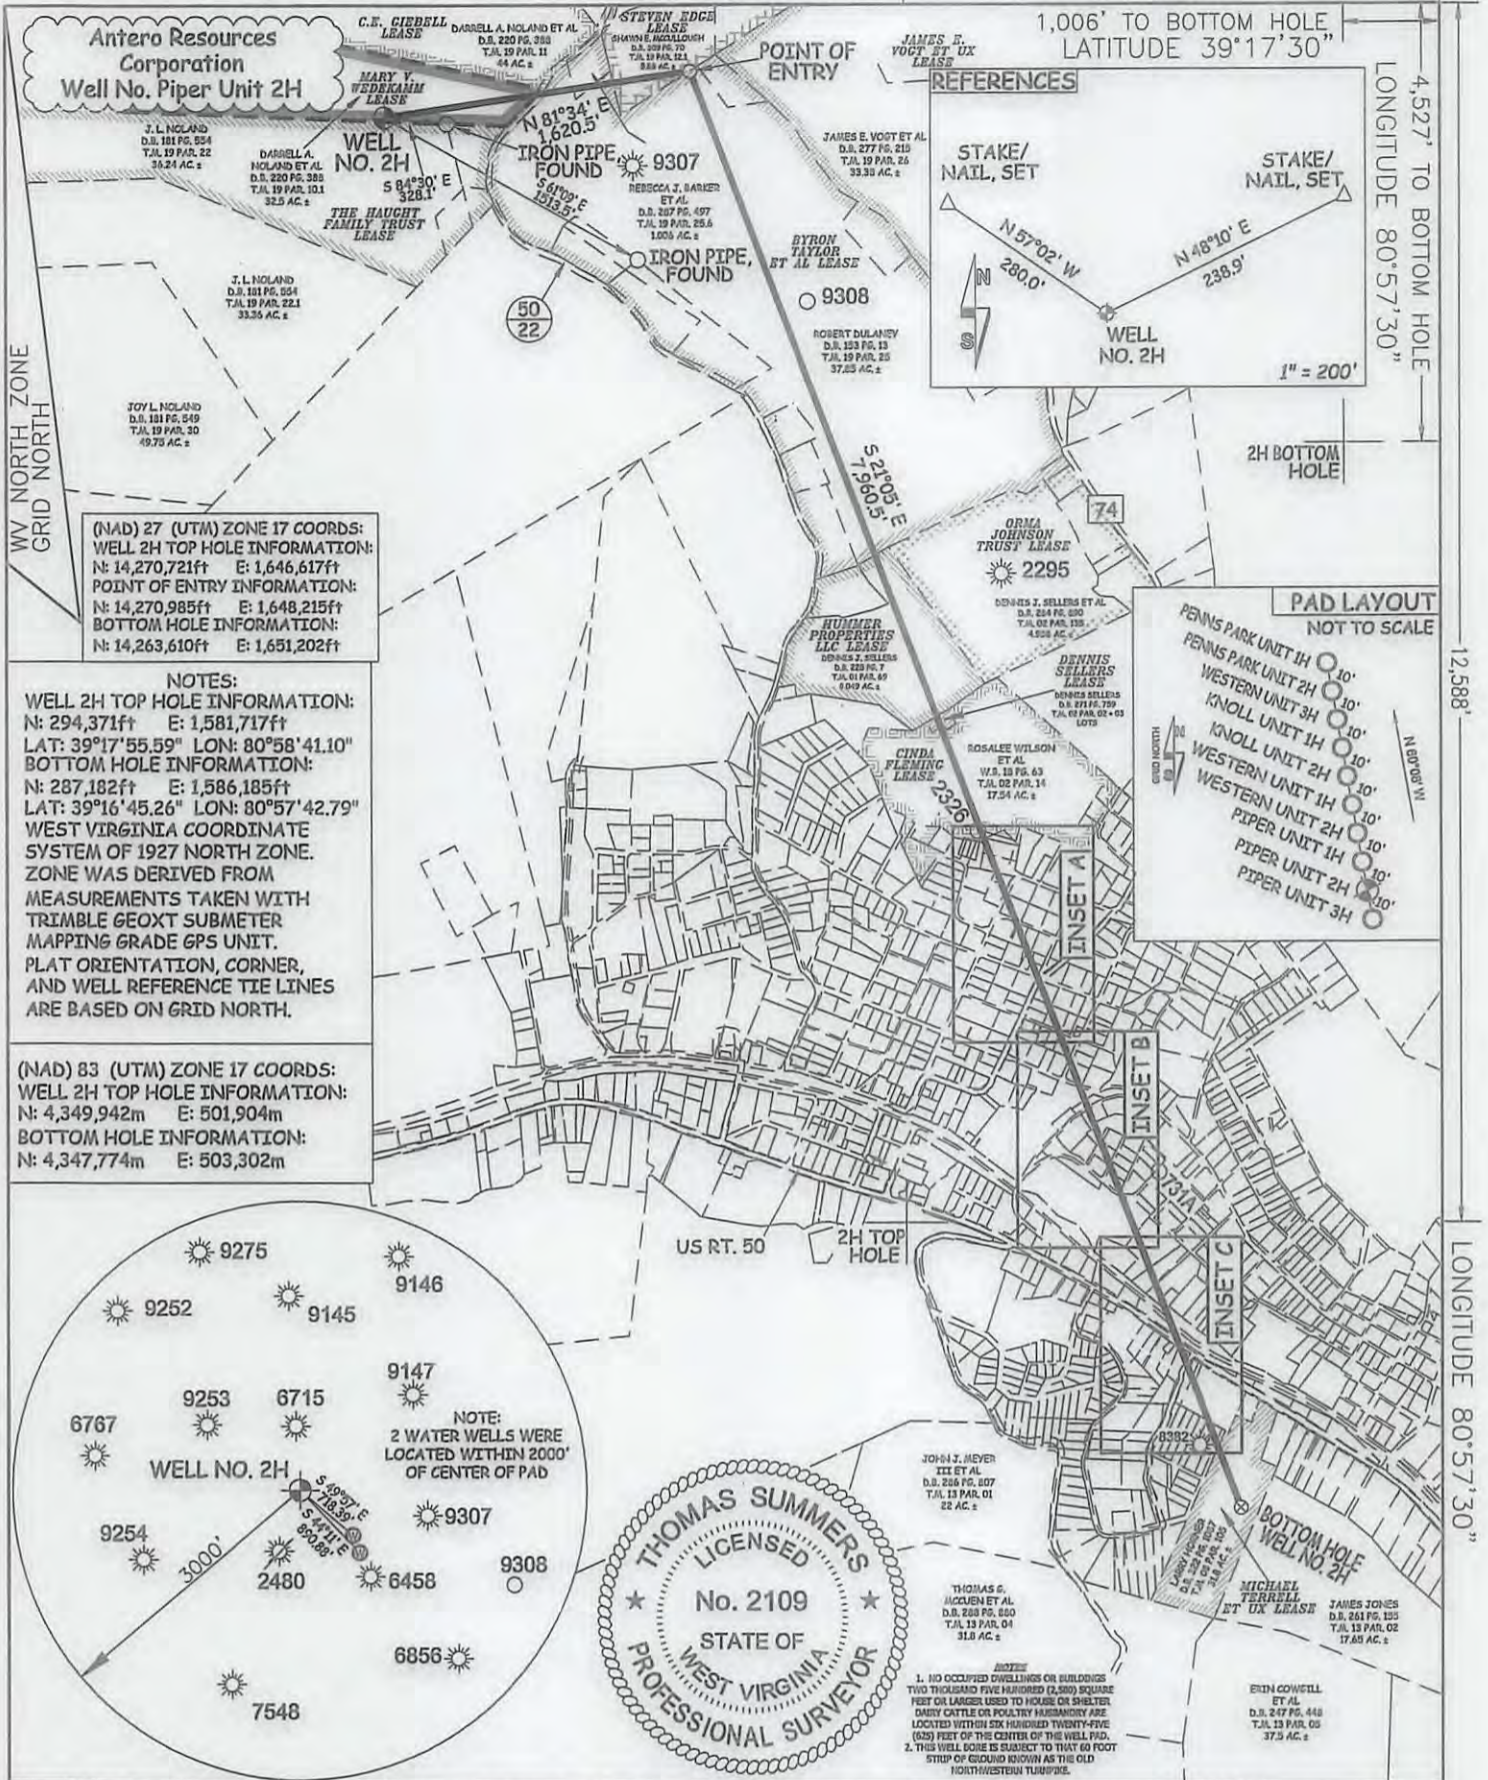

(NAD) 27 (UTM) ZONE 17 COORDS:
WELL 2H TOP HOLE INFORMATION:
N: 14,270,721ft E: 1,646,617ft
POINT OF ENTRY INFORMATION:
N: 14,270,985ft E: 1,648,215ft
BOTTOM HOLE INFORMATION:
N: 14,263,610ft E: 1,651,202ft

NOTES:
WELL 2H TOP HOLE INFORMATION:
N: 294,371ft E: 1,581,717ft
LAT: 39°17'55.59" LON: 80°58'41.10"
BOTTOM HOLE INFORMATION:
N: 287,182ft E: 1,586,185ft
LAT: 39°16'45.26" LON: 80°57'42.79"
WEST VIRGINIA COORDINATE SYSTEM OF 1927 NORTH ZONE. ZONE WAS DERIVED FROM MEASUREMENTS TAKEN WITH TRIMBLE GEOXT SUBMETER MAPPING GRADE GPS UNIT. PLAT ORIENTATION, CORNER, AND WELL REFERENCE TIE LINES ARE BASED ON GRID NORTH.

(NAD) 83 (UTM) ZONE 17 COORDS:
WELL 2H TOP HOLE INFORMATION:
N: 4,349,942m E: 501,904m
BOTTOM HOLE INFORMATION:
N: 4,347,774m E: 503,302m

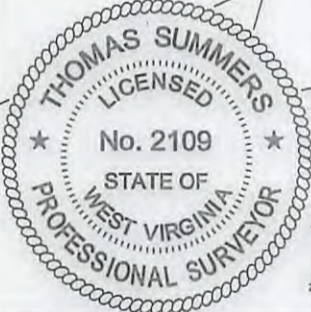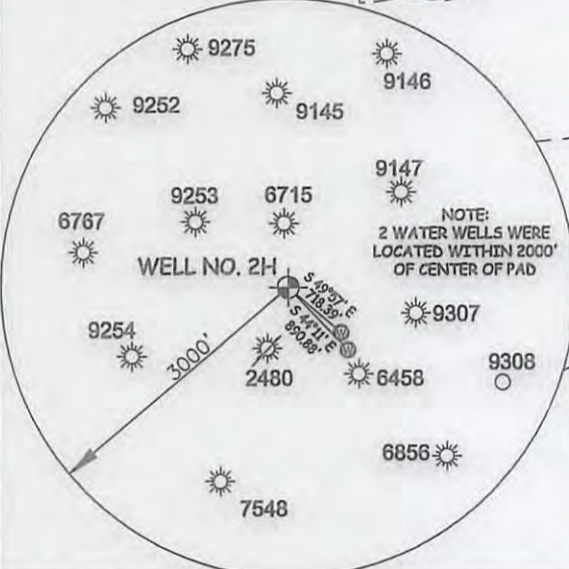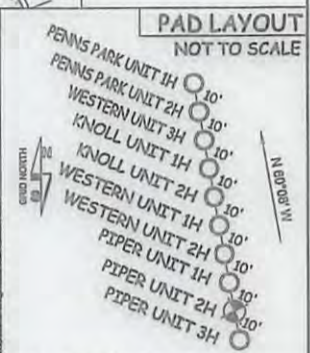

NOTES:

JOB # 16-005WA
DRAWING # PIPER2HR1
SCALE 1" = 1000'

MINIMUM DEGREE OF ACCURACY SUBMETER
PROVEN SOURCE OF ELEV. SUBMETER MAPPING GRADE GPS

STATE OF WEST VIRGINIA DEPARTMENT OF ENERGY DIVISION OF OIL AND GAS

WELL TYPE: OIL GAS LIQUID INJECTION WASTE DISPOSAL
(IF "GAS") PRODUCTION STORAGE DEEP SHALLOW
LOCATION: ELEVATION 1,159' ORIGINAL - 1,143' AS DRILLED WATERSHED NORTH FORK HUGHES RIVER
QUADRANGLE PENNSBORO 7.5 DISTRICT CLAY COUNTY RITCHIE

SURFACE OWNER DARRELL A. NOLAND ET AL ACREAGE 32.5 ACRES +/-
OIL & GAS ROYALTY OWNER SEE ATTACHED PAGES FOR LEASE INFORMATION LEASE ACREAGE SEE ATTACHED PAGES

PROPOSED WORK: DRILL CONVERT DRILL DEEPER REDRILL FRACTURE OR STIMULATE
PLUG OFF OLD FORMATION PERFORATE NEW FORMATION OTHER PHYSICAL CHANGE IN WELL (SPECIFY) MOD-BHL PLUG & ABANDON CLEAN OUT & REPLUG
TARGET FORMATION MARCELLUS ESTIMATED DEPTH 6,500' TVD 15,500 MD

WELL OPERATOR ANTERO RESOURCES CORP. DESIGNATED AGENT DIANNA STAMPER
ADDRESS 1615 WYNKOOP STREET ADDRESS 5400 D BIG TYLER ROAD
DENVER, CO 80202 CHARLESTON, WV 25313

I THE UNDERSIGNED, HEREBY CERTIFY THAT THIS PLAT IS CORRECT TO THE BEST OF MY KNOWLEDGE AND BELIEF AND SHOWS ALL THE INFORMATION REQUIRED BY LAW AND THE RULES ISSUED AND PERSCRIBED BY THE DEPARTMENT OF ENVIRONMENTAL PROTECTION.



STATE OF WEST VIRGINIA, DIVISION OF ENVIRONMENTAL PROTECTION, OFFICE OF OIL AND GAS

WILLOW LAND SURVEYING PLLC
266 HUSHERS RUN RD PENNSBORO WEST VIRGINIA 26415

LEGEND

- Surface Owner Boundary Lines +/-
- Interior Surface Tracts +/-
- Existing Fence
- Rebar, Found

Thomas Summers
THOMAS SUMMERS P.S. 2109

DATE 11/07/16
OPERATOR'S WELL# PIPER UNIT 2H

API WELL # 47 - 085 - 10292 MD
STATE COUNTY PERMIT

RECEIVED
Oil and Gas

ENVIRONMENTAL PROTECTION
DIANNA STAMPER
CT CORPORATION SYSTEM