

WW-7
8-30-06



West Virginia Department of Environmental Protection
Office of Oil and Gas
WELL LOCATION FORM: GPS

API: 47-085-10429 WELL NO.: Steel Run (80604)

FARM NAME: Mike Ross Inc.

RESPONSIBLE PARTY NAME: WVDEP
COUNTY: Ritchie DISTRICT: Grant

QUADRANGLE: Petroleum

SURFACE OWNER: Mike Ross Inc.

ROYALTY OWNER: Carle & Cuthbert Heirs

UTM GPS NORTHING: 4340091.0

UTM GPS EASTING: 475916.0 Elevation 855'

The Responsible Party named above has chosen to submit GPS coordinates in lieu of preparing a new well location plat for a plugging permit or assigned API number on the above well. The Office of Oil and Gas will not accept GPS coordinates that do not meet the following requirements:

1. Datum: NAD 1983, Zone: 17 North, Coordinate Units: meters, Altitude: height above mean sea level (MSL) – meters.

2. Accuracy to Datum – 3.05 meters

3. Data Collection Method:

Survey grade GPS _____: Post Processed Differential _____
Real-Time Differential _____

Mapping Grade GPS _____: Post Processed Differential _____
Real-Time Differential _____

4. Letter size copy of the topography map showing the well location.

I the undersigned, hereby certify this data is correct to the best of my knowledge and belief and shows all the information required by law and the regulations issued and prescribed by the Office of Oil and Gas.

David Scranage _____ Inspector Specialist _____
Signature Title

Date 5/12/2022


RECEIVED
Office of Oil and Gas

JUN 3 2022

WV Department of
Environmental Protection

06/10/2022

47-085-10429P

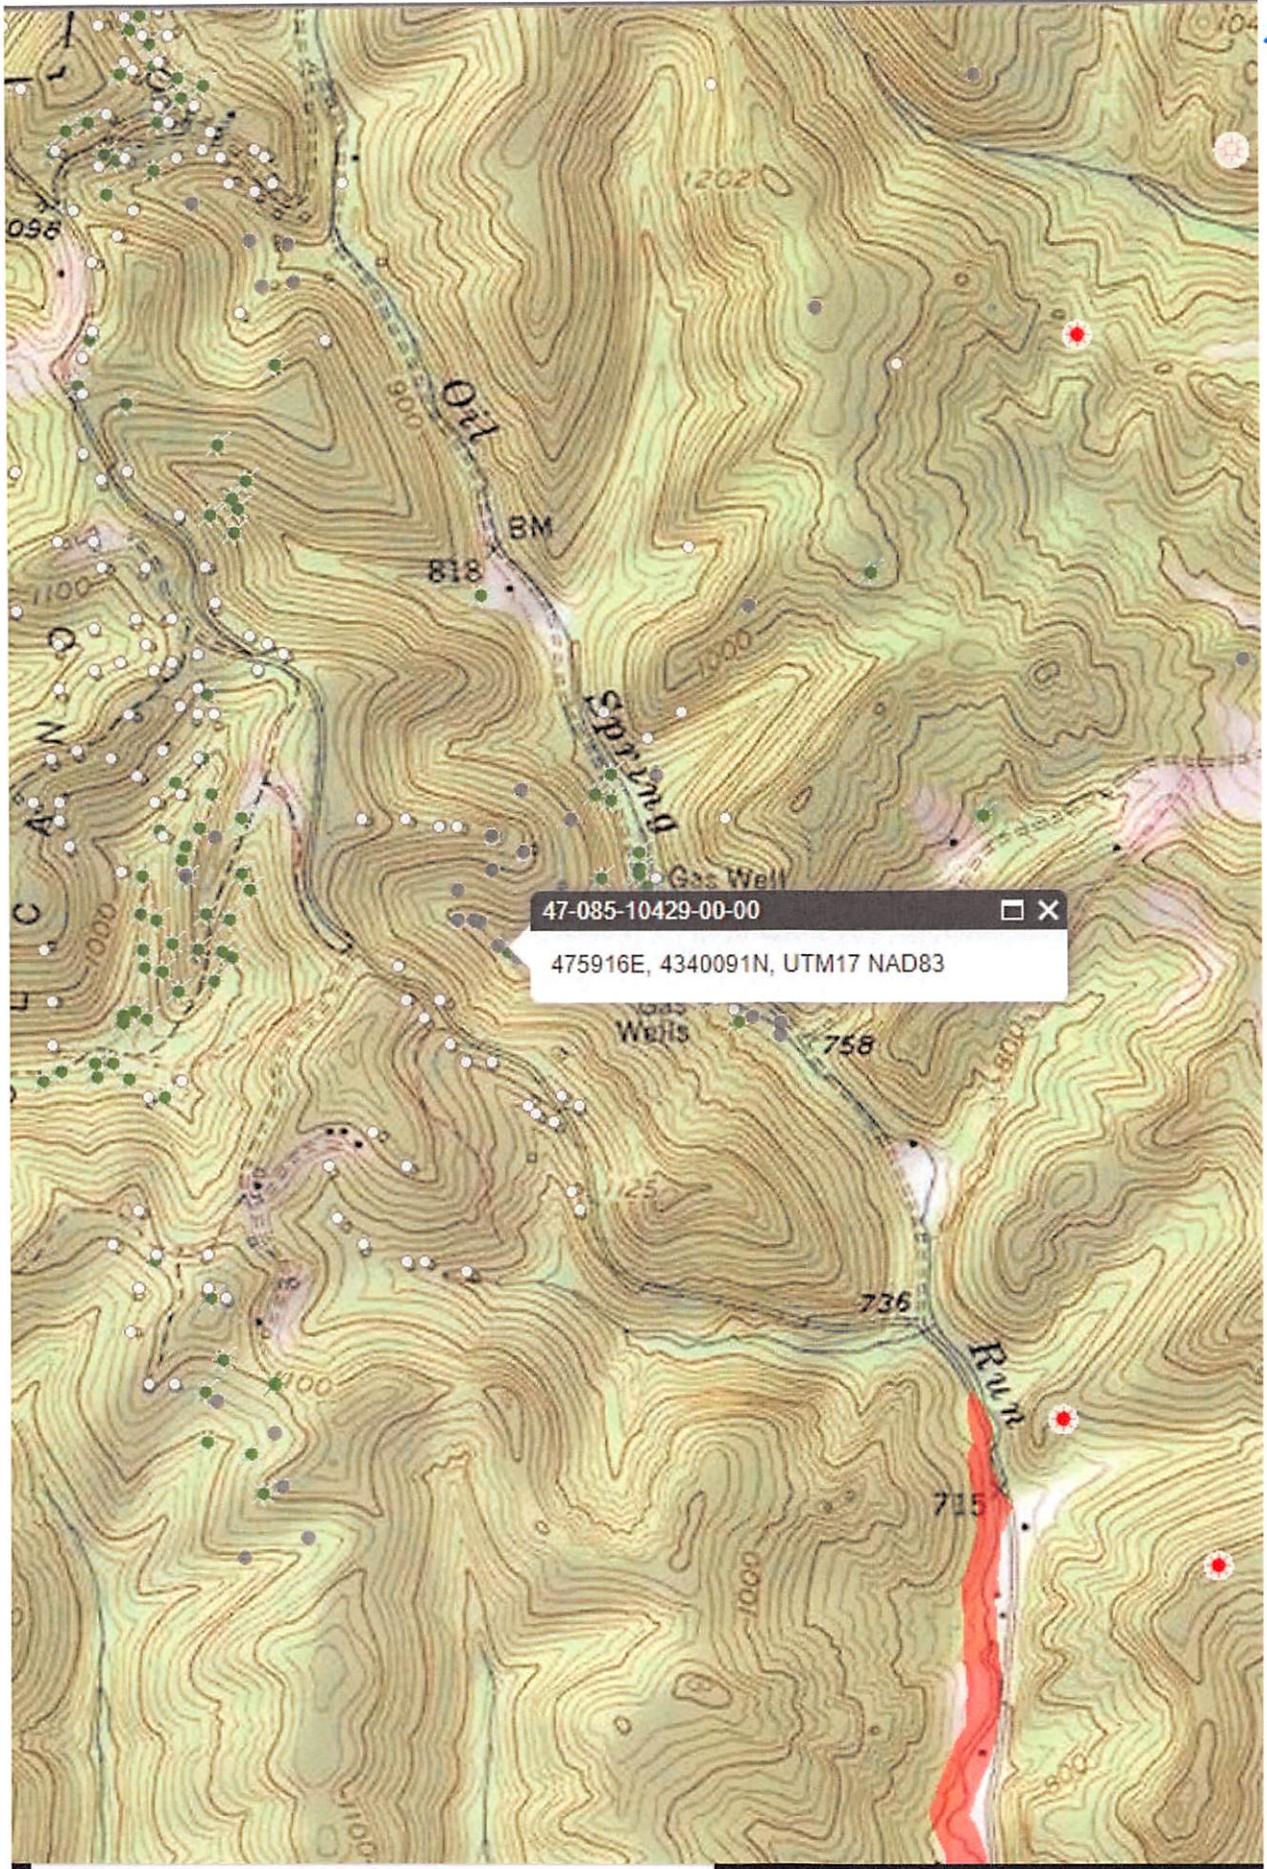

06/10/2022