

WW-7  
8-30-06



West Virginia Department of Environmental Protection  
Office of Oil and Gas  
**WELL LOCATION FORM: GPS**

API: 47-085-10432 WELL NO.: Steel Run (90094)

FARM NAME: Mike Ross Inc. et, al

RESPONSIBLE PARTY NAME: WVDEP

COUNTY: Ritchie DISTRICT: Grant

QUADRANGLE: Petroleum

SURFACE OWNER: Mike Ross Inc.

ROYALTY OWNER: Carle & Cuthbert Heirs

UTM GPS NORTHING: 4340232.8

UTM GPS EASTING: 475904.8 Elevation 988'

The Responsible Party named above has chosen to submit GPS coordinates in lieu of preparing a new well location plat for a plugging permit or assigned API number on the above well. The Office of Oil and Gas will not accept GPS coordinates that do not meet the following requirements:

- Datum: NAD 1983, Zone: 17 North, Coordinate Units: meters, Altitude: height above mean sea level (MSL) – meters.
- Accuracy to Datum – 3.05 meters
- Data Collection Method:

Survey grade GPS : Post Processed Differential   
Real-Time Differential

Mapping Grade GPS : Post Processed Differential   
Real-Time Differential

- Letter size copy of the topography map showing the well location.

I the undersigned, hereby certify this data is correct to the best of my knowledge and belief and shows all the information required by law and the regulations issued and prescribed by the Office of Oil and Gas.

David Scranage Inspector Specialist  
Signature Title


Date 5/12/2022

RECEIVED  
Office of Oil and Gas  
JUN 3 2022  
WV Department of  
Environmental Protection

06/10/2022



47-085-10432 P

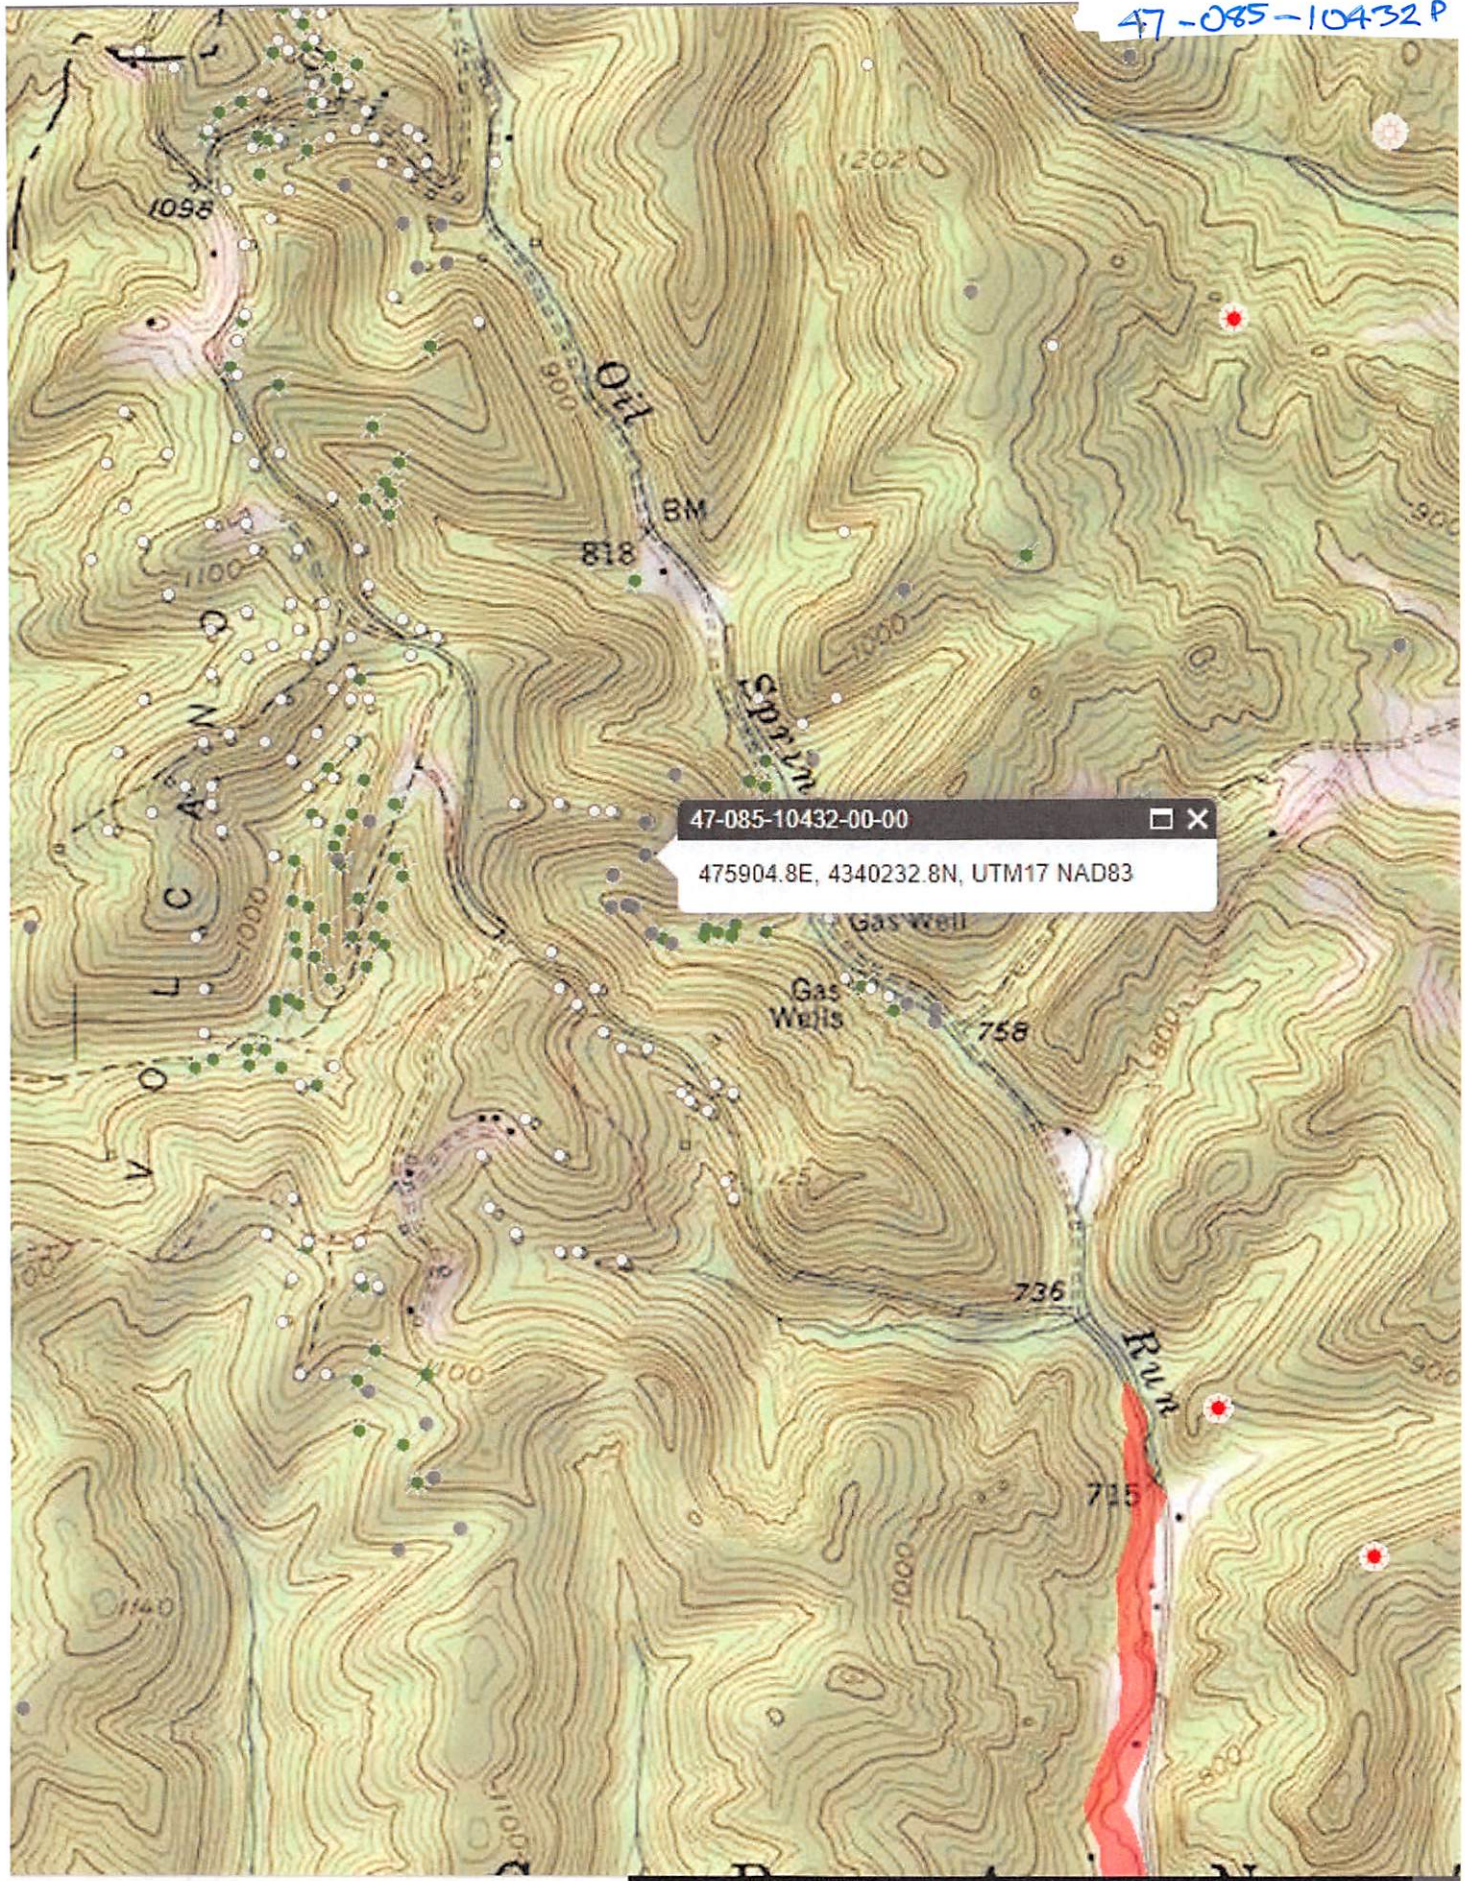

47-085-10432-00-00  
475904.8E, 4340232.8N, UTM17 NAD83

06/10/2022