


07/28/2023

TH: 2653' LAT: 39-07-30

47-085-10491
West Virginia Department of Environmental Protection


47-085-10491 coordinates are
NAD 83 N: 228,306.93 E: 1,461,146.98
NAD 83 Lat: 39.114029 Long: -91.217992
NAD 83 UTM N: 4,329,453.18 E: 481,160.84
West Virginia Coordinate system of 1983 (North Zone)
based upon Differential GPS Measurements.
Plat orientation, corner and well ties are based upon
the grid north meridian.
Well location references are based upon the grid north
meridian.
UTM coordinates are NAD83, Zone 17, Meters.

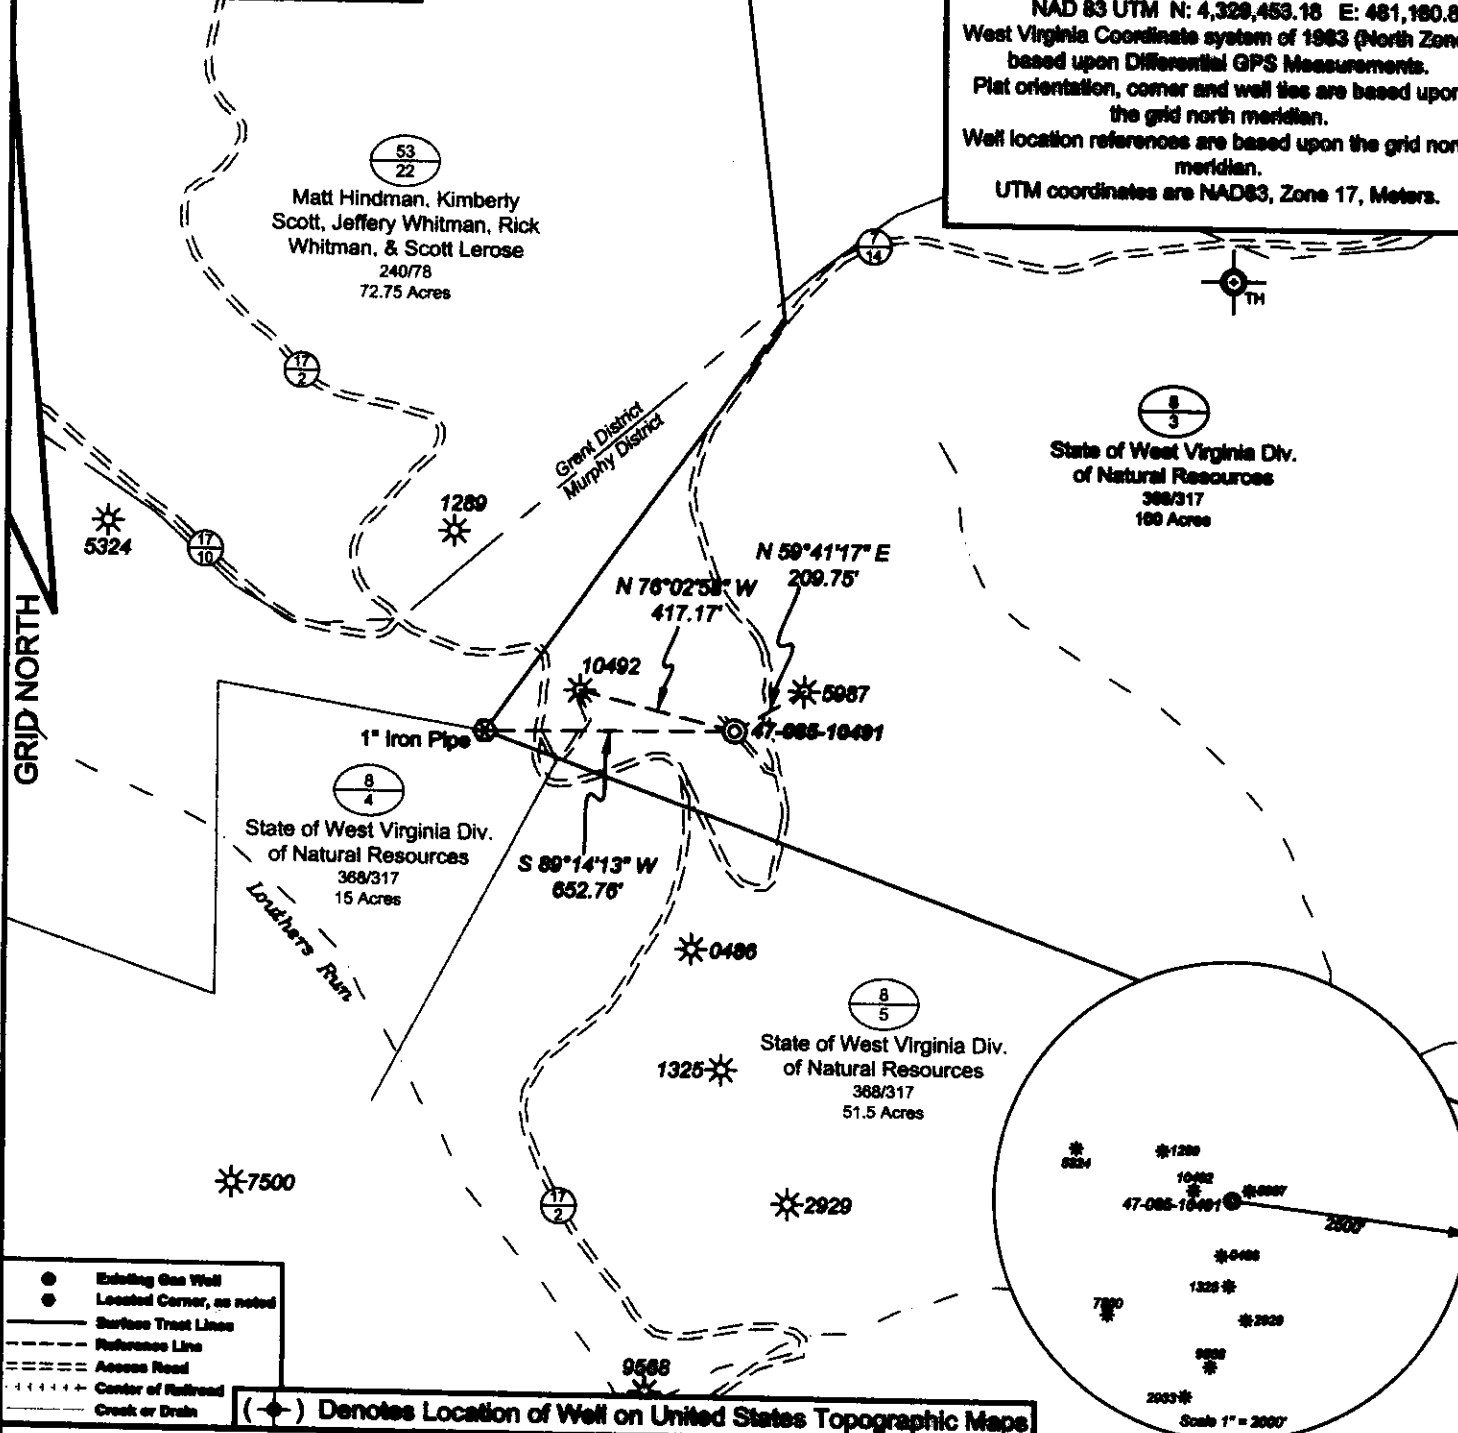

TH: 3996' LON: 81-12-30

- Existing Gas Well
- Locust Corner, as noted
- Surface Tract Lines
- - - Reference Line
- - - - - Access Road
- - - - - Center of Railroad
- - - - - Creek or Drain

(*) Denotes Location of Well on United States Topographic Maps

 

I, the undersigned, hereby certify that this plat is correct to the best of my knowledge and belief and shows all the information required by law and the regulations issued and prescribed by the Department of Environmental Protection.

[Signature]
P.S. 2002



SEAL

FILE NO: 121-23
DRAWING NO: 47-085-10491
SCALE: 1" = 500'
MINIMUM DEGREE OF ACCURACY: 1:2500
PROVEN SOURCE OF ELEVATION: NGS CORS Station

STATE OF WEST VIRGINIA
DEPARTMENT OF ENVIRONMENTAL PROTECTION
OIL AND GAS DIVISION

DATE: May 22 20 23
OPERATOR'S WELL NO.: 47-085-10491
API WELL NO
47 - 085 - 10491
STATE COUNTY PERMIT

WELL TYPE: OIL GAS LIQUID INJECTION WASTE DISPOSAL
(IF GAS) PRODUCTION: STORAGE DEEP SHALLOW
LOCATION: ELEVATION: 1002' WATERSHED: Louthers Run QUADRANGLE: Mactarian
DISTRICT: Murphy COUNTY: Ritchie DATE: 07/28/2023
SURFACE OWNER: State of West Virginia Division of Natural Resources ACREAGE: 100
ROYALTY OWNER: LEASE NO: ACREAGE:
PROPOSED WORK: DRILL CONVERT DRILL DEEPER FRACTURE OR STIMULATE PLUG OFF OLD FORMATION
 PERFORATE NEW FORMATION OTHER PHYSICAL CHANGE IN WELL (SPECIFY)
 PLUG AND ABANDON CLEAN OUT AND REPLUG TARGET FORMATION: Unknown ESTIMATED DEPTH: Unknown
WELL OPERATOR: Unknown - DEP Paid Plugging Contract WVDEP DESIGNATED AGENT: H. Jason Harmon
ADDRESS: 601 57th Street ADDRESS: 601 57th Street
Charleston, WV 25304 Charleston, WV 25304