

LATITUDE 39°20'00"

8,695'

LATITUDE 39°22'30" 3,839' TO BOTTOM HOLE

8,746' TO BOTTOM HOLE

9,030'

LONGITUDE 81°02'30"

LONGITUDE 81°00'00"

COUNTY NAME

PERMIT

Antero Resources Corporation
Well No. McKinney #1H

AS DRILLED DATA:


WELL 1H TOP HOLE INFORMATION:
N: 298,178ft E: 1,566,881ft
LAT: 39°18'30.75" LON: 81°01'50.62"
BOTTOM HOLE INFORMATION:
N: 313,754ft E: 1,560,213ft
LAT: 39°21'03.56" LON: 81°03'18.87"
WEST VIRGINIA COORDINATE
SYSTEM OF 1927 NORTH ZONE.
ZONE WAS DERIVED FROM
MEASUREMENTS TAKEN WITH
TRIMBLE GEOXT SUBMETER
MAPPING GRADE GPS UNIT.
PLAT ORIENTATION, CORNER,
AND WELL REFERENCE TIE LINES
ARE BASED ON GRID NORTH.

(NAD) 83 (UTM) ZONE 17 COORDS:
WELL 1H TOP HOLE INFORMATION:
N: 4,351,026m E: 497,365m
BOTTOM HOLE INFORMATION:
N: 4,355,737m E: 495,255m

(NAD) 27 (UTM) ZONE 17 COORDS:
WELL 1H TOP HOLE INFORMATION:
N: 14,274,278ft E: 1,631,724ft
POINT OF ENTRY INFORMATION:
N: 14,274,068ft E: 1,630,176ft
BOTTOM HOLE INFORMATION:
N: 14,289,735ft E: 1,624,800ft

- NOTE
1. NO OCCUPIED DWELLINGS OR BUILDINGS TWO THOUSAND FIVE HUNDRED (2,500) SQUARE FEET OR LARGER USED TO HOUSE OR SHELTER DAIRY CATTLE OR POULTRY HUSBANDRY ARE LOCATED WITHIN SIX HUNDRED TWENTY-FIVE (625) FEET OF THE CENTER OF THE WELL PAD.
 2. TOP HOLE DATA SHOWN HEREON WAS PROVIDED BY ANTERO RESOURCES CORPORATION.
 3. AS DRILLED DATA WAS PROVIDED BY ANTERO RESOURCES CORPORATION.
 4. WLS IS NOT CERTIFYING THE DATA AND INFORMATION PROVIDED LISTED IN NOTES 2 AND 3, ONLY THE RELATIONSHIP TO THE DATA AND INFORMATION PROVIDED TO THE LEASE BOUNDARIES.
 5. WLS IS BY NO MEANS RESPONSIBLE FOR ANY ERRORS OR INACCURACIES WITH THE DATA AND INFORMATION THAT HAS BEEN PROVIDED.

NOTE:
NO WATER WELLS
LOCATED WITHIN 2000'
OF PROPOSED WELL

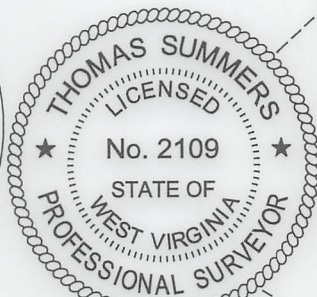

I THE UNDERSIGNED, HEREBY CERTIFY THAT THIS PLAT IS CORRECT TO THE BEST OF MY KNOWLEDGE AND BELIEF AND SHOWS ALL THE INFORMATION REQUIRED BY LAW AND THE RULES ISSUED AND PERSCRIBED BY THE DEPARTMENT OF ENVIRONMENTAL PROTECTION.



STATE OF WEST VIRGINIA, DIVISION
OF ENVIRONMENTAL PROTECTION,
OFFICE OF OIL AND GAS

WILLOW LAND SURVEYING PLLC
220 MASONIC AVE. PENNSBORO
WEST VIRGINIA 26415

JOB # 23-026WA
DRAWING # MCKINNEY1HAD
SCALE 1" = 2000'
MINIMUM DEGREE OF
ACCURACY SUBMETER
PROVEN SOURCE OF ELEV.
SUBMETER MAPPING GRADE GPS

LEGEND

- Surface Owner Boundary Lines +/-
- Interior Surface Tracts +/-
- Proposed Well Path
- As Drilled Well Path

THOMAS SUMMERS P.S. 2109

STATE OF WEST VIRGINIA
DEPARTMENT OF ENERGY
DIVISION OF OIL AND GAS

DATE 12/12/24
OPERATOR'S WELL# MCKINNEY UNIT #1H

WELL TYPE: OIL ☐ GAS ☒ LIQUID INJECTION ☐ WASTE DISPOSAL ☐ 47 - 085 - 10513
(IF "GAS") PRODUCTION ☒ STORAGE ☐ DEEP ☐ SHALLOW ☒ STATE COUNTY PERMIT
LOCATION: ELEVATION 1,066' - AS BUILT WATERSHED NORTH FORK HUGHES RIVER
QUADRANGLE ELLENBORO 7.5' DISTRICT CLAY COUNTY RITCHIE
SURFACE OWNER MICHAEL UNDERWOOD ET AL ACREAGE 50 ACRES +/-
OIL & GAS ROYALTY OWNER RONNEL L. UNDERWOOD ET AL LEASE ACREAGE 266.83 ACRES

PROPOSED WORK: DRILL ☐ CONVERT ☐ DRILL DEEPER ☐ REDRILL ☐ FRACTURE OR STIMULATE
PLUG OFF OLD FORMATION ☐ PERFORATE NEW FORMATION ☐ OTHER PHYSICAL CHANGE IN WELL ☐
(SPECIFY) AS DRILLED PLUG & ABANDON CLEAN OUT & REPLUG
TARGET FORMATION MARCELLUS ESTIMATED DEPTH 6,158' TVD 23,328' MD
WELL OPERATOR ANTERO RESOURCES CORP. DESIGNATED AGENT KEVIN ELLIS
ADDRESS 1615 WYNKOOP ST. ADDRESS 535 WHITE OAKS BLVD
FORM WW-6 DENVER, CO 80202 BRIDGEPORT, WV 26330

CLAY DISTRICT RITCHIE COUNTY		LAFAYETTE DISTRICT PLEASANTS COUNTY	
6-18	Consolidated Timberlands LLC	9-11	Harold Anderson
11-12	Donald Ritchey	9-21	Alton Glatfelter
11-12.1	Donald Ritchey	10-25	Christopher Hackathorn II
11-14	Kevin Mossor	10-25.1	Rex Cox
11-32	Lorena Mossor Et Al	10-25.3	Ellery Wilson
11-32.1	Roger Mossor	10-25.4	Ellery Wilson
11-42.1	Judith Packman Et Al	10-25.5	Rex Cox
12-1.3	Johnny Cool	10-26	Mark Hadley
12-5	Wanda McKinney	10-32	Emily Williamson
12-5.1	Wanda McKinney	10-33	Charles McCullough
12-5.2	Wanda McKinney	10-34	Charles McCullough
12-5.3	Andrea Mahaney	10-39	Robert Jay
12-6	Andrea Mahaney	10-40	Mark Hadley
12-6.2	Adams County Hunt Club LLP	12-2	Robert Jay
12-6.3	Adams County Hunt Club LLP	12-2.1	Stanley Martin
12-16	Michael Underwood Et Al	12-2.2	David Metz
12-16.1	Michael Underwood Et Al	12-2.3	Teresa Williamson
12-16.2	Michael Underwood Et Al	12-2.4	Teresa Williamson
12-16.3	Michael Underwood Et Al	12-2.5	Nancy Martin
12-17	Erma Smith Et Al	12-3	Robert Jay
18-4	David Villers	12-4	Hazel Workman
18-5	Michael Underwood Et Al	12-4.1	Ricky Mossor
		12-4.2	Ricky Mossor
		12-4.3	Ricky Mossor

LESSOR

A	PAMELA L. NICHOLS
B	ANTERO MINERALS, LLC.
C	REX A. COX AND PAMELA L. COX
D	SONYA G. POLING
E	MARY V. TEMPLETON ET AL
F	MARY V. TEMPLETON
G	ADA WEEKLY ET AL
H	ROBERT H. JAY AND MADGE V. JAY
I	WANDA MAE GLOVER
J	RIVERSIDE RESOURCES, LLC.
K	J.R. MORRISON ET AL
L	HERITAGE RESOURCES - MARCELLUS MINERALS, LLC.
M	SHEILA R. McDONALD
N	SARAH B. MIHLBAUER ET AL
O	NATHANIEL LYLE MASON
P	STEVEN ALKIRE
Q	RIDGETOP CAPITOL VI, LP.
R	ROSE ALKIRE ET AL
S	RONNEL UNDERWOOD ET AL
T	M. B. LEASEBURG ET UX
U	HAROLD REX ANDERSON, JR.
V	RONNEL UNDERWOOD ET AL