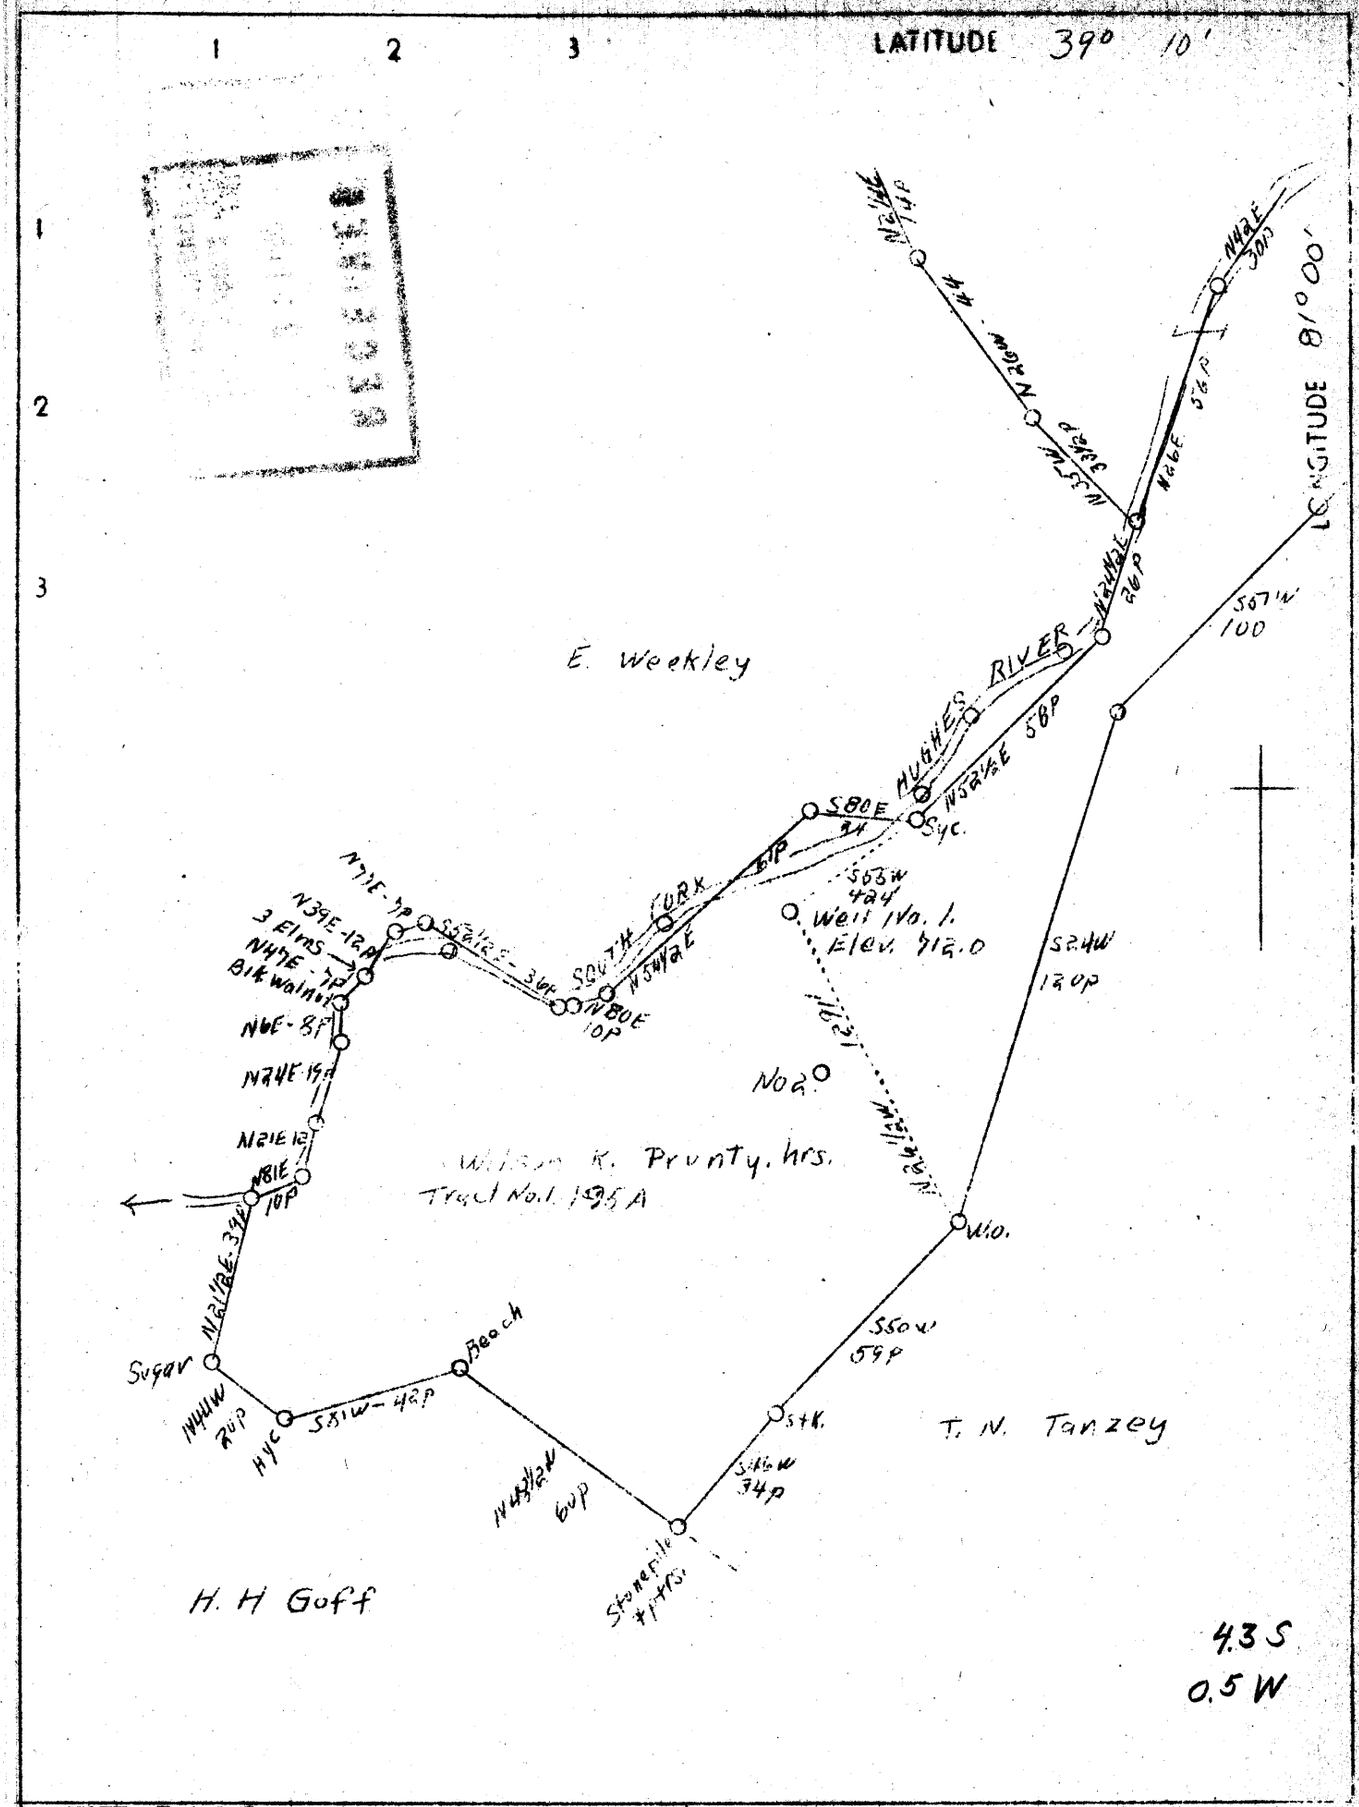

NOTE: Total Lease Acreage 326A.
Company W.A.Bickerstaff
Address Harrisville, W.Va.
Farm Wilson K. Prunty, Hrs.
Tract 1 Acres 195 Lease No.
Well (Farm) No. 1 Serial No.
Elevation (Spirit Level) 712'
Quadrangle Harrisville E.C.
County Ritchie District Murphy
Engineer O.W.Barnhart
Engineer's Registration No. Surveyor
Filo No. Drawing No.
Date May 12,1938 Scale 1"-40 P.

STATE OF WEST VIRGINIA
Department of Mines
OIL AND GAS DIVISION
CHARLESTON

WELL LOCATION MAP

File No. Rit-356-A

Denotes location of well on United States Topographic Maps, scale 1 to 62,500, latitude and longitude lines being represented by border lines as shown.

Denotes one inch spaces on border line of original tracing.

RECEIVED
MAY 23 1938
WEST VIRGINIA
GEOLOGICAL SURVEY