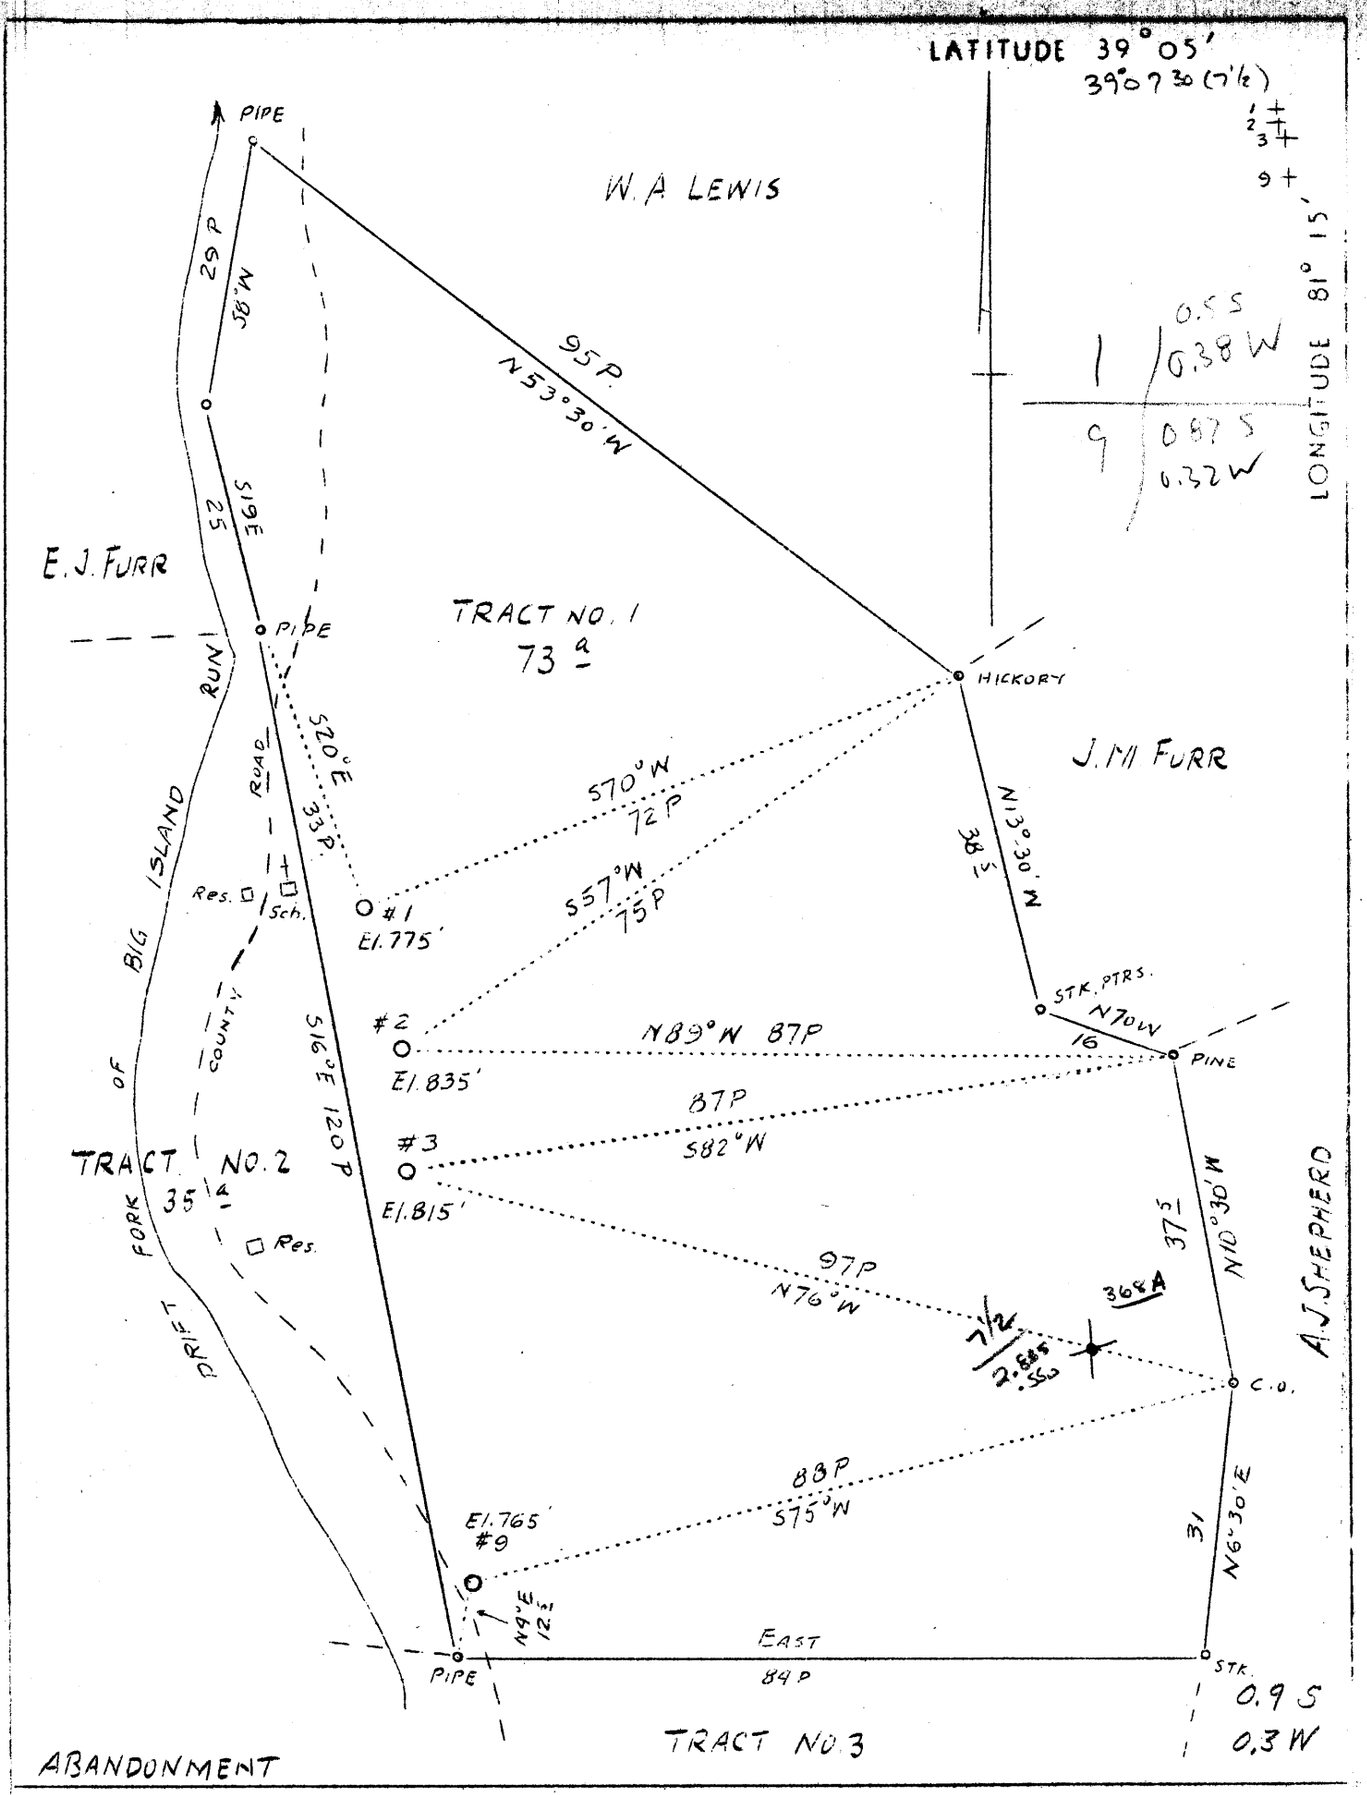

ABANDONMENT

Company	Smith, Feisk & Pierson
Address	Parker, R.D. No. 2 W.Va.
Farm	First Citizens Bank of Pennsboro E. A. Rinehart Rec.
Tract	Acres 73
Well (Farm)	No.s 1, 2, 3
Elevation (Spirit Level)	#1-775; No 2-835; #3-815
Quandrangle	Elizabeth
County	Ritchie
District	Murphy
Engineer	J. E. & Robt. Anderson
Engineer's Registration No.	296
Date	July 17, 1937
Scale	Lin--20p

STATE OF WEST VIRGINIA
Department of Mines
OIL AND GAS DIVISION
Charleston

WELL LOCATION MAP

File No. RIT- 367 - WELL #1 A
368 - " 4 A
370 - " 9 A

x Denotes location of well on United States Topographic Map, scale 1 to 62,500, latitude and longitude lines being represented by border lines as shown.
- Denotes one inch spaces on border line of original tracing.

RECEIVED
AUG 29 1938
WEST VIRGINIA
GEOLOGICAL SURVEY