


0 1 2 3 Latitude 39° 10'

1 Longitude 81° 10'

2

3

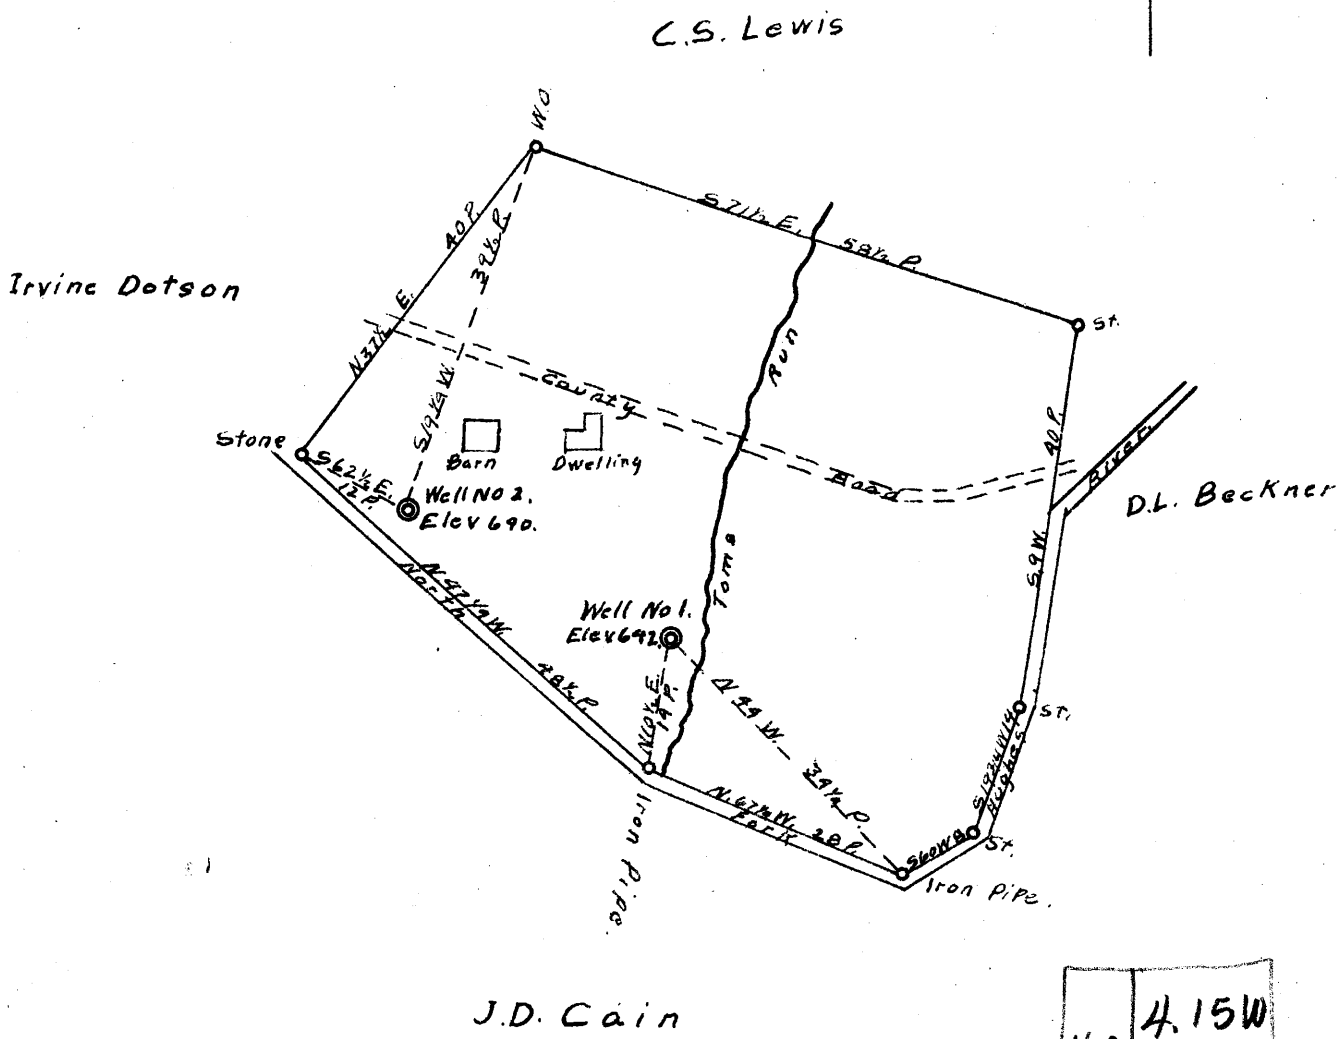

No. 2	4.15W 1.07S
No. 1	4.09W 1.13S

Company Nollem Oil & Gas Corp.
 Address 2212 Oliver Bld. Pittsburg, Pa.
 Farm C.A. Kerns
 Tract _____ Acres 20 Lease No. _____
 Well (Farm) No. 1 & 2 Serial No. _____
 Elevation (Spirit Level) NOL 692 NOL 690
 Quadrangle Harrisville
 County Ritchie District Grant
 Engineer A.H. Westfall
 Engineer's Registration No. _____
 File No. _____ Drawing No. _____
 Date Oct 3 1938 Scale 20 Poles 1"

STATE OF WEST VIRGINIA
 DEPARTMENT OF MINES
 OIL AND GAS DIVISION
 CHARLESTON

WELL LOCATION MAP
 FILE NO. Rit-377-A
RIT-488A
 WELL No. 2

+ Denotes location of well on United States Topographic Maps, scale 1 to 62,500, latitude and longitude lines being represented by border lines as shown.
 - Denotes one inch spaces on border line of original tracing.