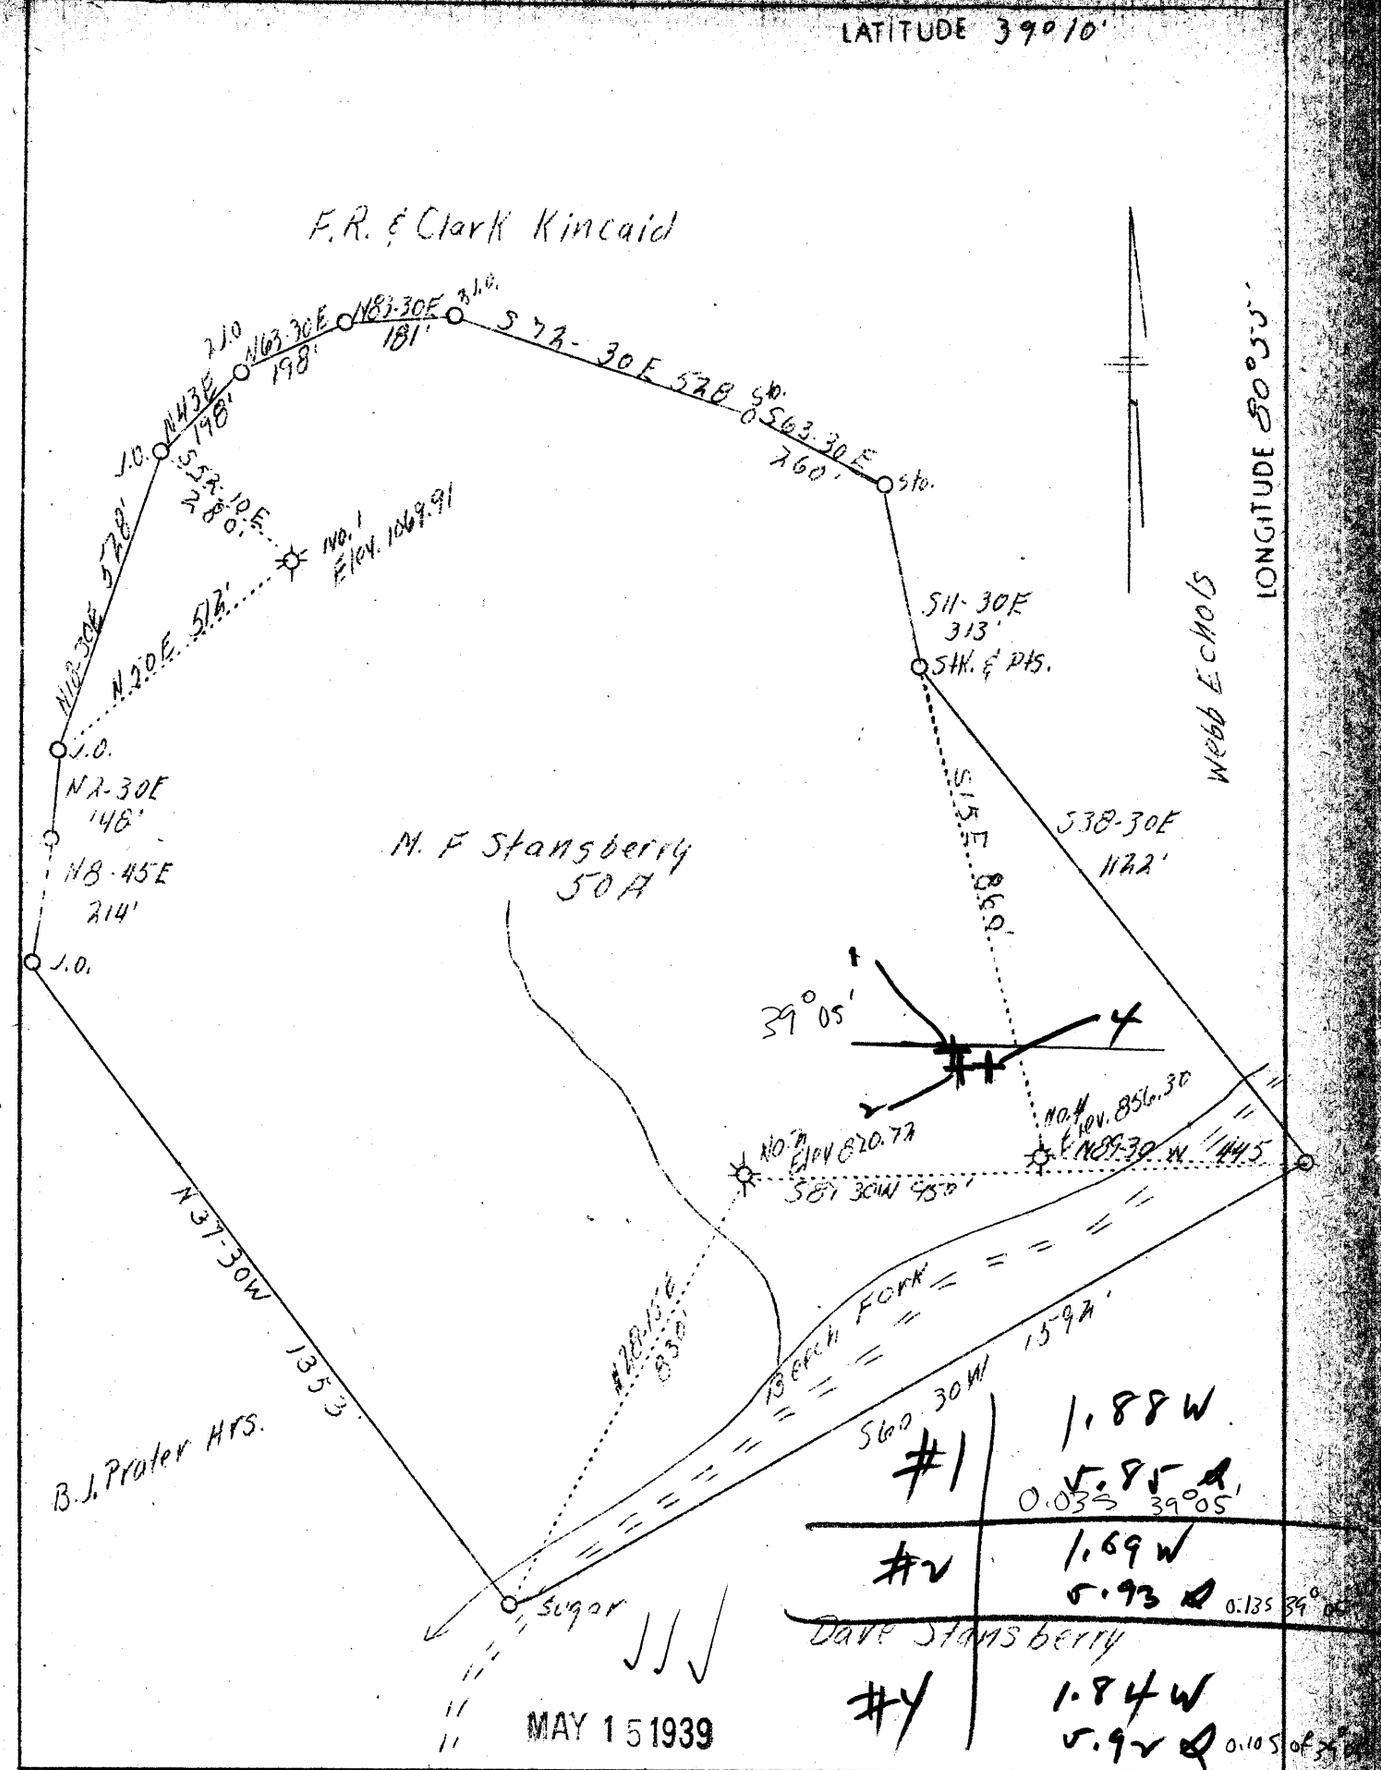

Company	Roane Nat'l Gas Co.
Address	Spencer, W.Va.
Farm	M. F. Stansbury
~~Tract~~	50
Well(Farm)No.	1 - 2 - 4
El.(S. L.)	#1 1069191 #2 870.72 #4 856.30
Quadrangle	Holbrook
County	Ritchie
District	Union
Eng.	L. F. Dye
Eng. Reg. No.	804
Date	4/25/39
Scale	1" - 300'

WC

+ DW

STATE OF WEST VIRGINIA
Department of Mines
OIL AND GAS DIVISION
Charleston

WELL LOCATION MAP

File No. Rit-398-400-A & 401-A

x Denotes location of well on U.S. Topographic Maps, scale 1 to 62,500, latitude and longitude lines being represented by border lines as shown.

May 39

- Denotes one inch spaces on border line of original tracing.

M. F. STANSBURY NOS. 1, 2, and 4 - ROANE NATURAL GAS CO. - RIT-