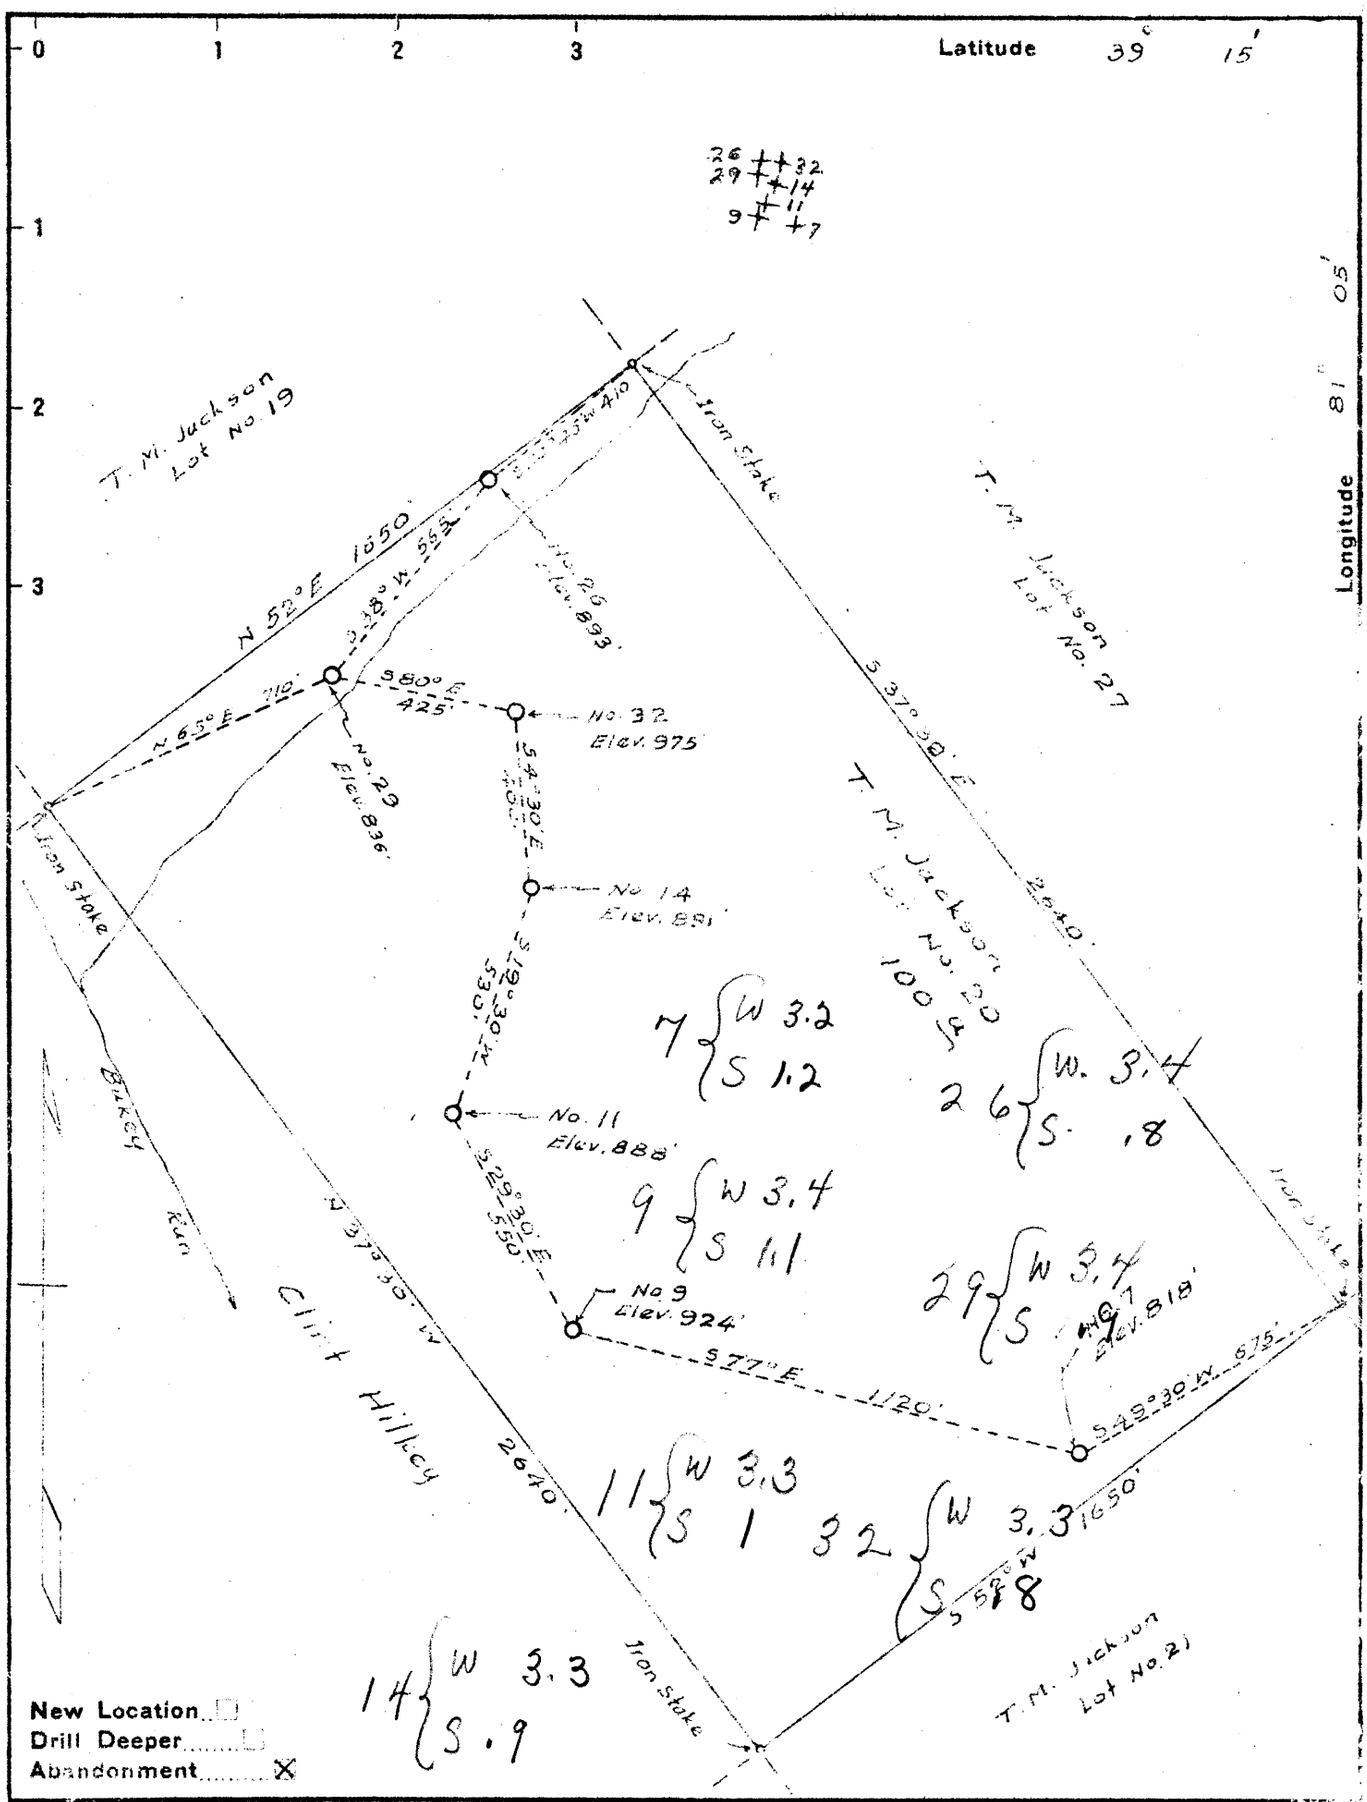

Company W. S. King

Address Spencer, W.Va.

Farm T. M. Jackson

Tract One Acres 100 Lease No.

Well (Farm) No. 14, 11, 9, 7 26, 29, 32 Serial No.

Elevation (Spirit Level)

Quadrangle Harrisville N

County Ritchie District Grant

Engineer Logan McDonald

Engineer's Registration No. 610

File No. Drawing No.

Date Sept 10, 1940 Scale 1" = 400'

STATE OF WEST VIRGINIA
DEPARTMENT OF MINES
OIL AND GAS DIVISION
CHARLESTON

WELL LOCATION MAP

FILE NO. RIT-4736-7-8-81-4&5 A
WELLS 7-9-11-14-26-29-32

+ Denotes location of well on United States Topographic Maps, scale 1 to 62,500, latitude and longitude lines being represented by border lines as shown.

— Denotes one inch spaces on border line of original tracing.