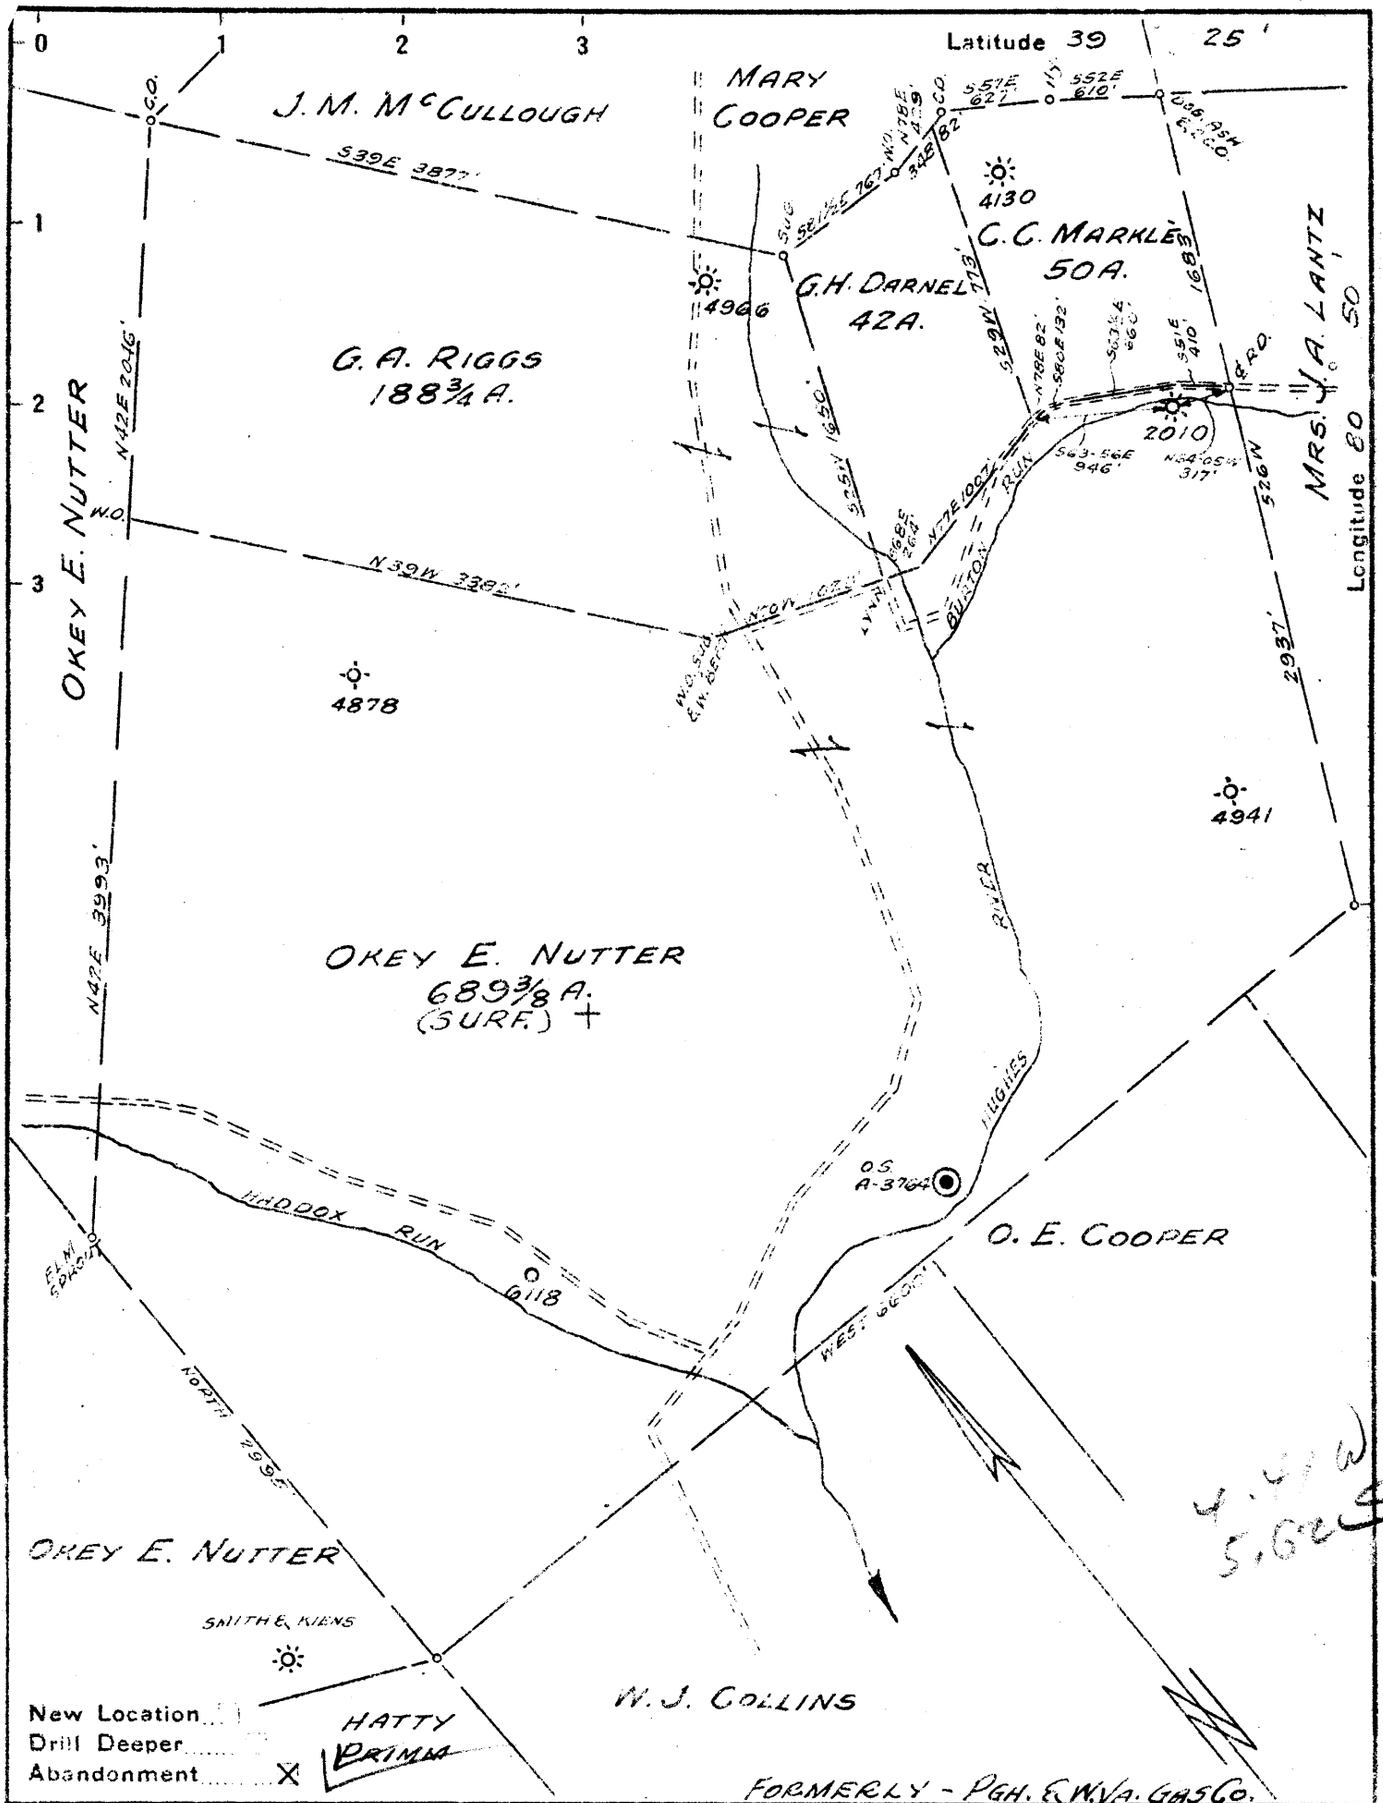

Company E.S. WOODYARD & J.H. JONES

Address PENNSBORO, W.VA.

Farm OKEY E. NUTTER

Tract _____ Acres 1000 Lease No. 7781

Well (Farm) No. ONE Serial No. 2010

Elevation (Spirit Level) 850'

Quadrangle WEST UNION, S.W., 2-3.

County RITCHIE District CLAY

Engineer James T. Griffin

Engineer's Registration No. 1084

File No. 82/125 Drawing No. _____

Date AUG. 6, 1940 Scale 1" = 1000'

STATE OF WEST VIRGINIA
DEPARTMENT OF MINES
OIL AND GAS DIVISION
CHARLESTON

WELL LOCATION MAP

FILE NO. RIT-533A

+ Denotes location of well on United States Topographic Maps, scale 1 to 62,500, latitude and longitude lines being represented by border lines as shown.

— Denotes one inch spaces on border line of original tracing.

PRINTED ON
PERMANENT TRACING CLOTH
K & E CO., N.Y.