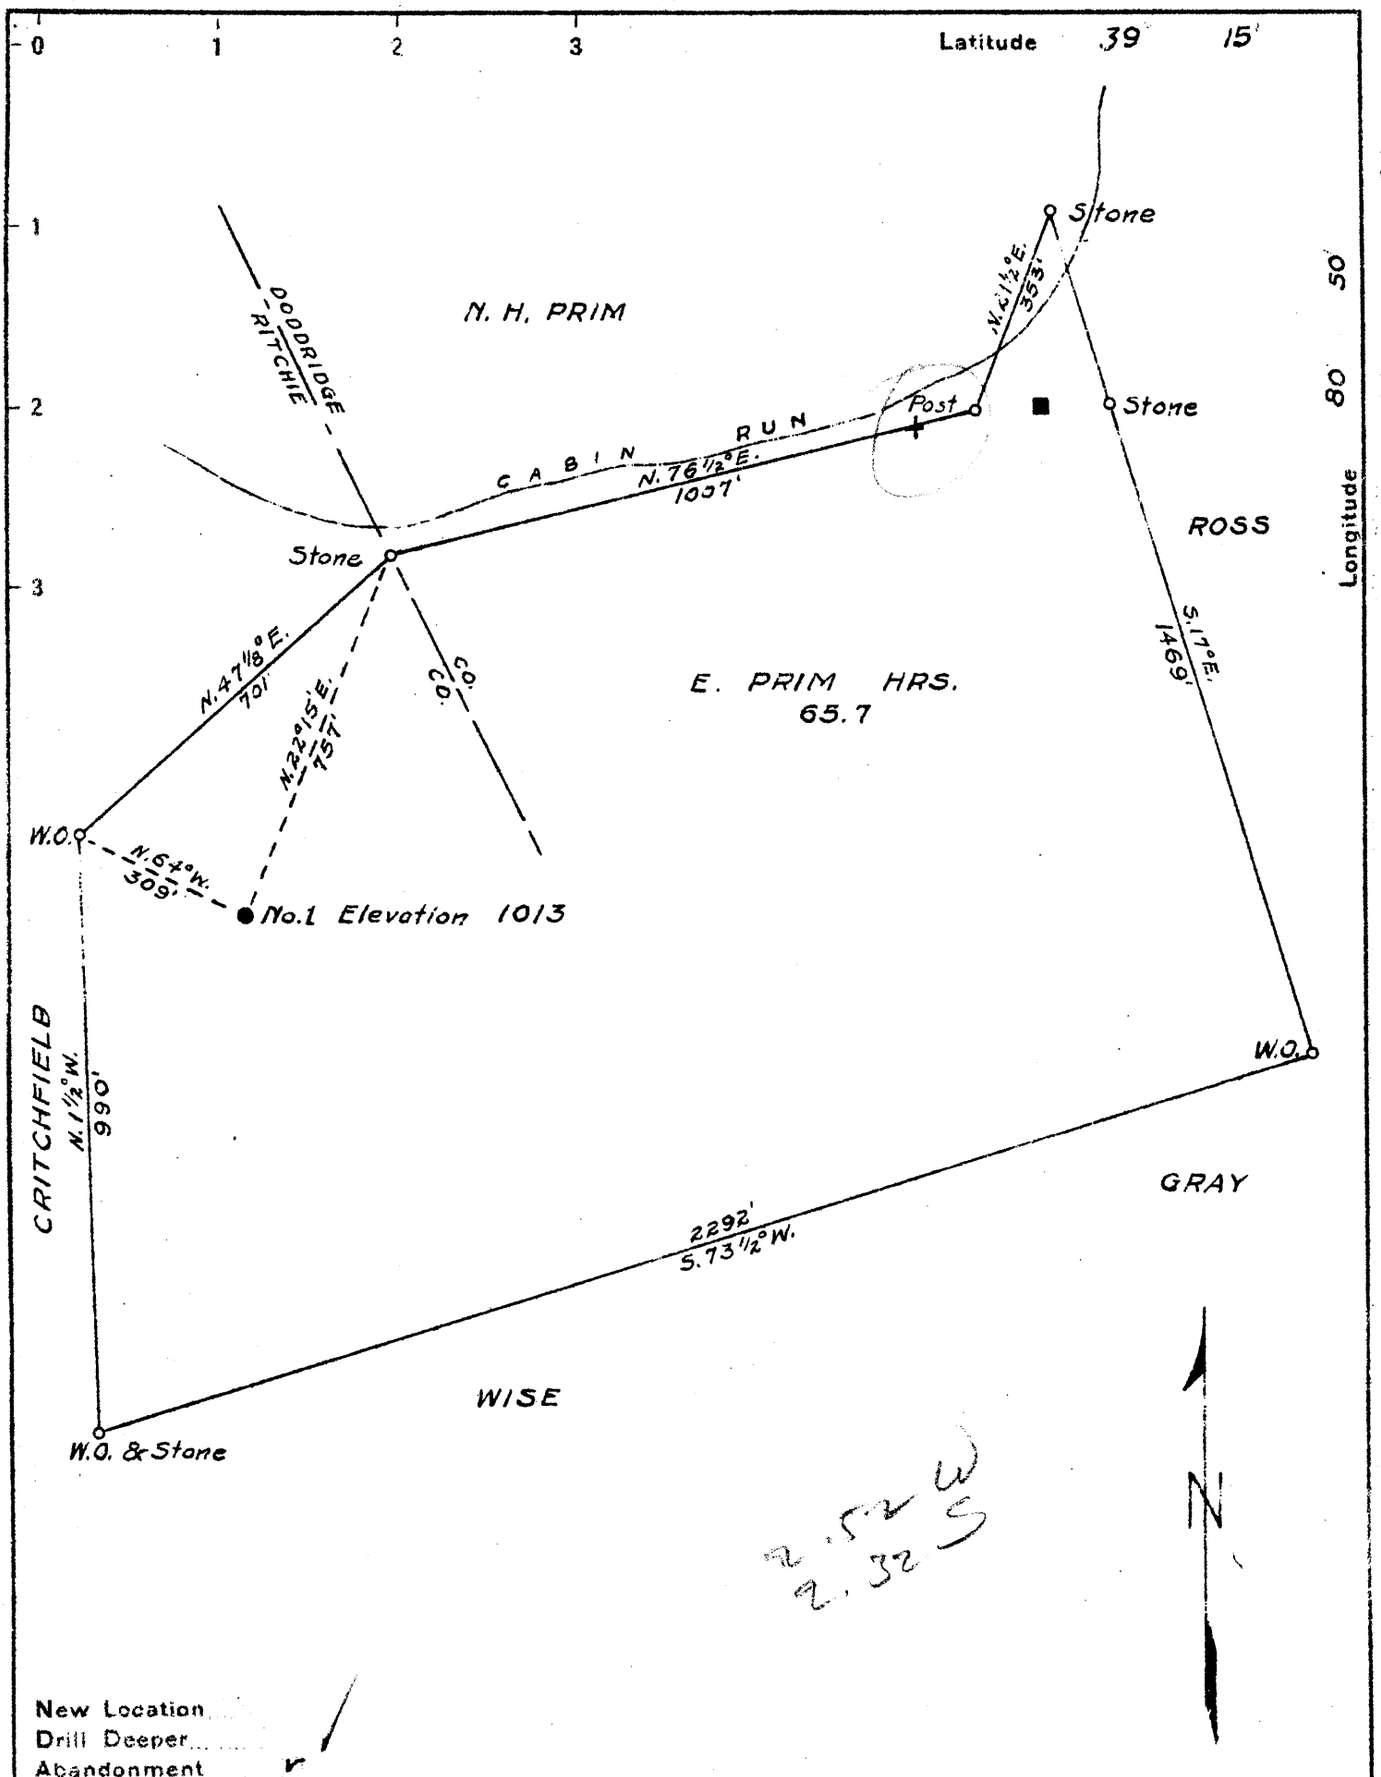


Company CABIN RUN OIL CO.

Address PARKERSBURG, W.VA.

Farm E. PRIM HRS.

Tract ____ Acres 65.7 Lease No. ____

Well (Farm) No. 1 Serial No. ____

Elevation (Spirit Level) 1013

Quadrangle HOLBROOK

County RITCHIE District UNION

Engineer W. T. Rinehart

Engineer's Registration No. 648

File No. ____ Drawing No. 275-U-R

Date June 19, 1941 Scale 1 in. = 300 ft.

STATE OF WEST VIRGINIA
DEPARTMENT OF MINES
OIL AND GAS DIVISION
CHARLESTON

# WELL LOCATION MAP

FILE NO. RIT-536A

+ Denotes location of well on United States Topographic Maps, scale 1 to 62,500, latitude and longitude lines being represented by border lines as shown.

— Denotes one inch spaces on border line of original tracing.