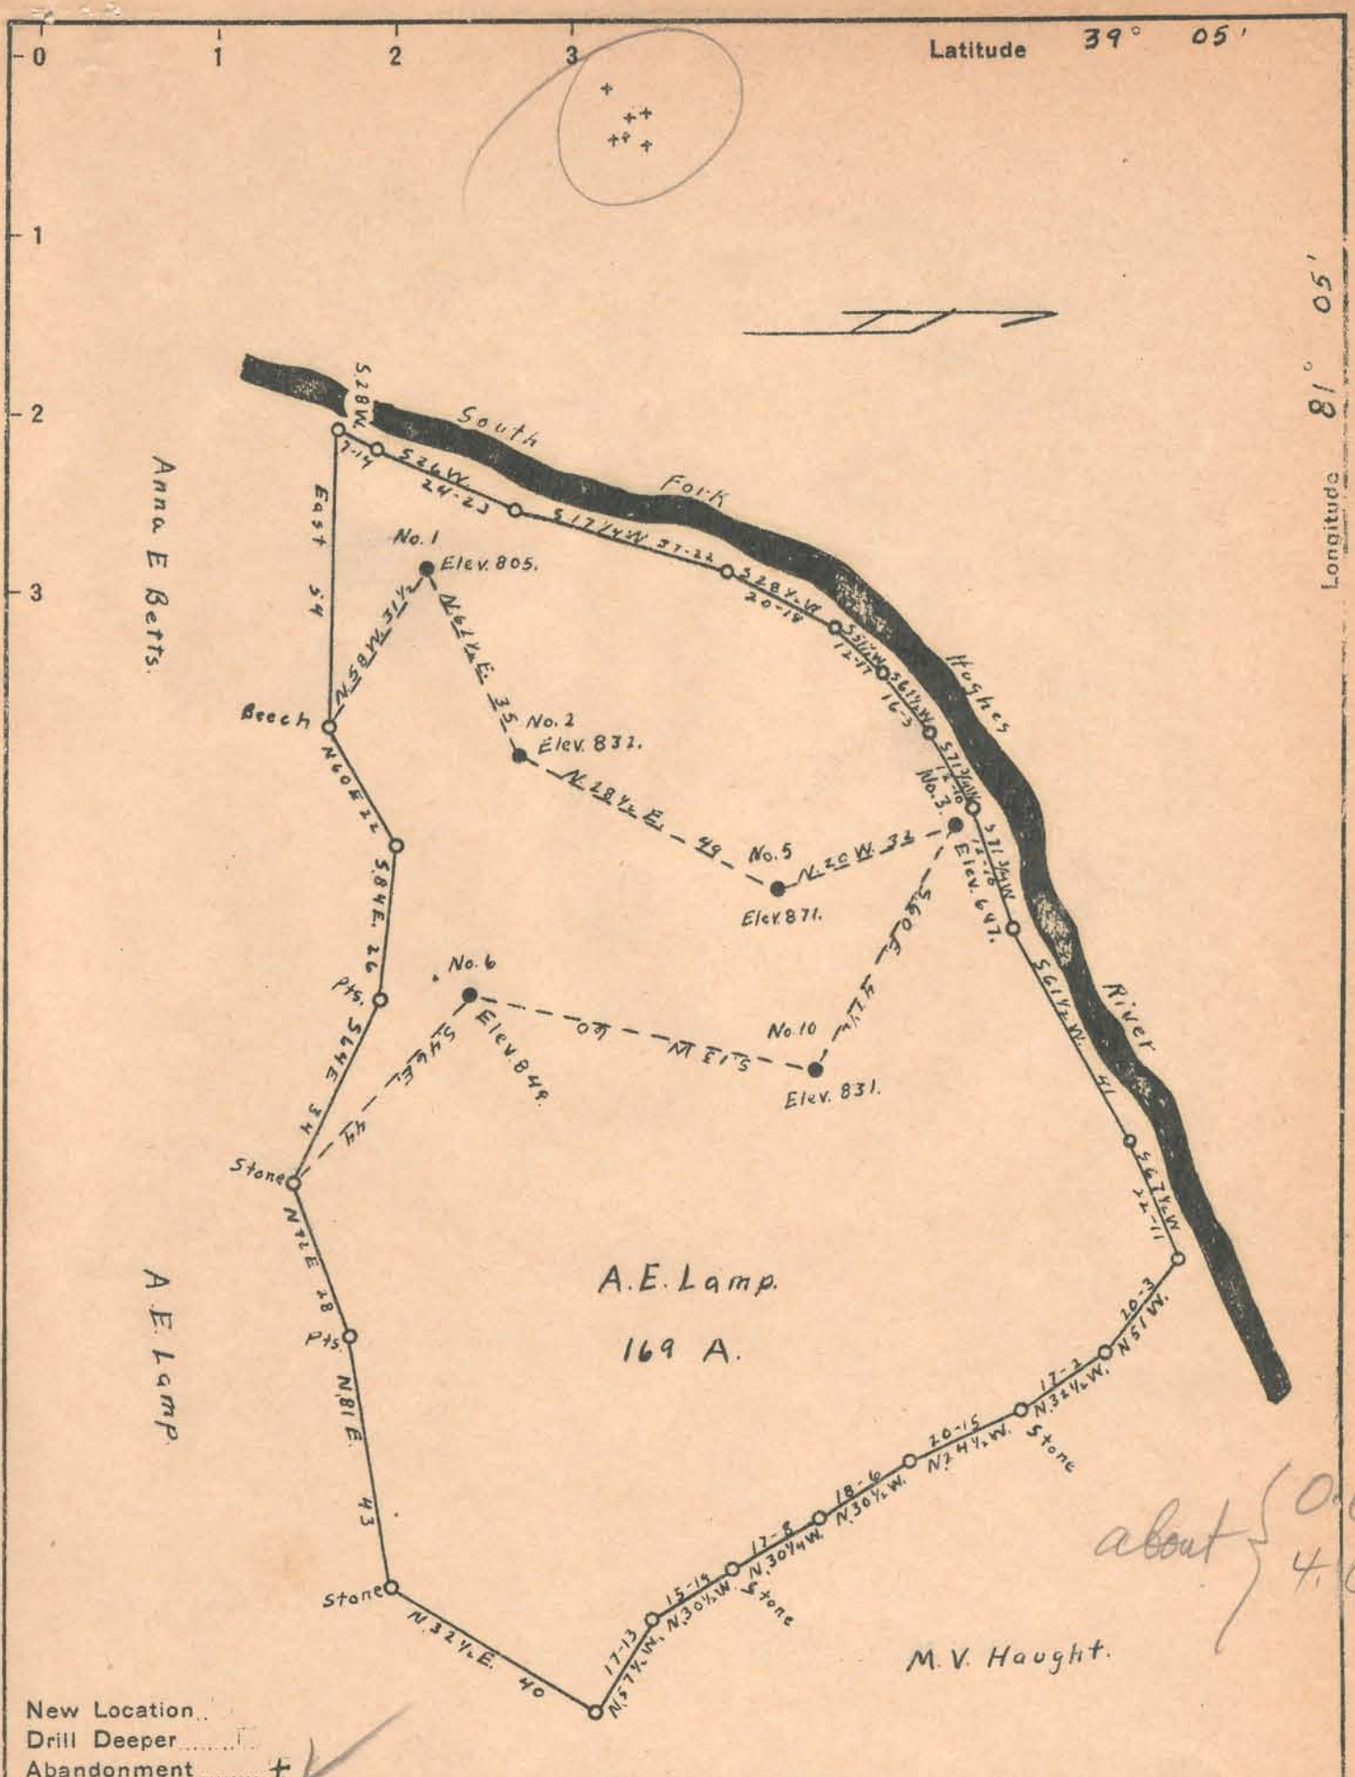

New Location
Drill Deeper
Abandonment +

Company W. R. Baker
Address Beatrice, W.Va.
Farm A.E. Lamp
Tract ____ Acres 169 Lease No. ____
Well (Farm) No. 1-2-3-5-6-10 Serial No. ____
Elevation (Spirit Level) 805-832-647-871-849-831
Quadrangle Harrisville
County Ritchie District Murphy
Engineer A.K. Westfall.
Engineer's Registration No. Co. Surveyor, Ritchie Co.
File No ____ Drawing No. ____
Date April 12 1941 Scale 1" = 30 Poles

STATE OF WEST VIRGINIA
DEPARTMENT OF MINES
OIL AND GAS DIVISION
CHARLESTON

WELL LOCATION MAP

FILE NO. RIT-543A-545A INC 1-5-10
(6) RIT-567A

+ Denotes location of well on United States Topographic Maps, scale 1 to 62,500, latitude and longitude lines being represented by border lines as shown.

— Denotes one inch spaces on border line of original tracing.

IMPERIAL TRACING CLOTH
K & E CO., N.Y.

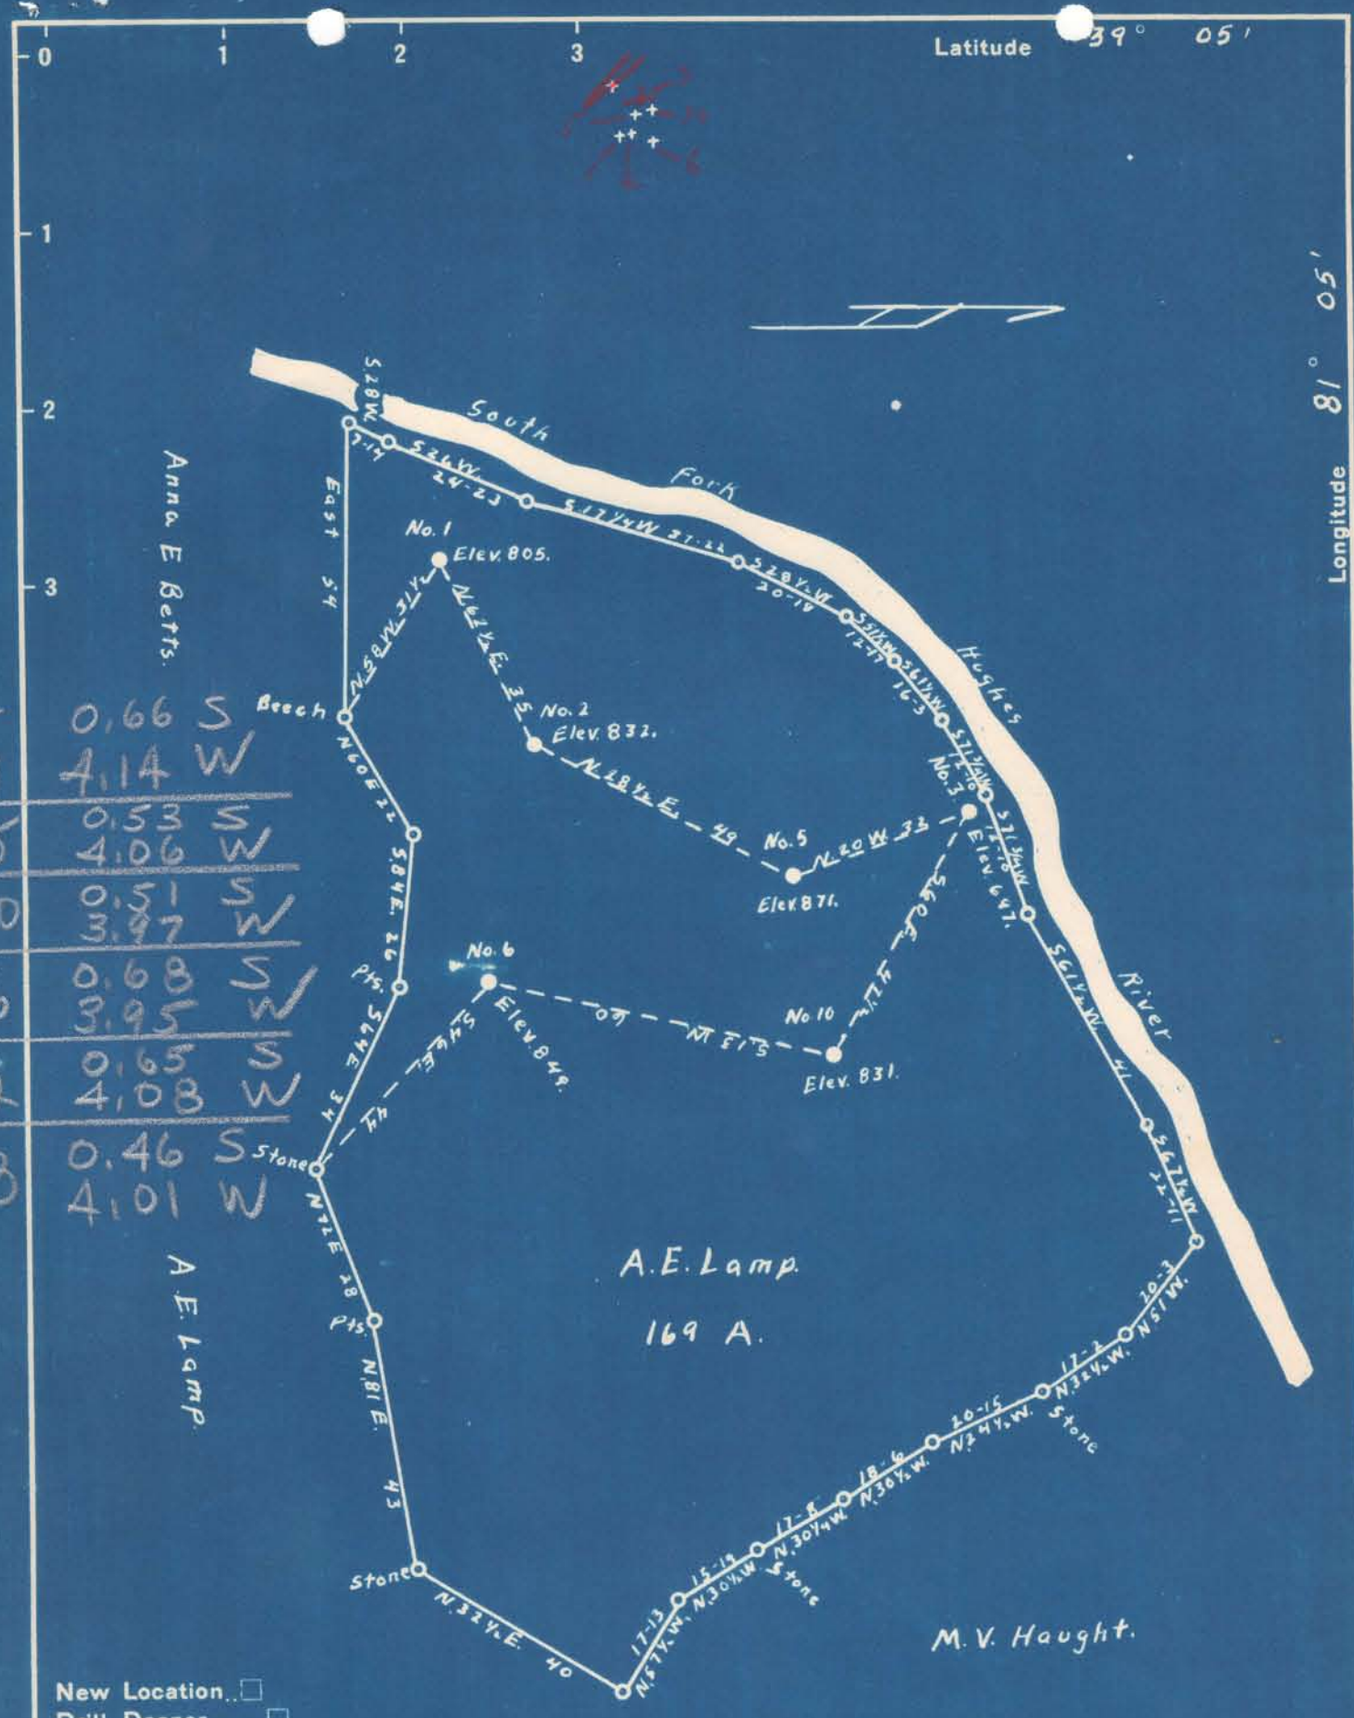

#	
1	0.66 S 4.14 W
5	0.53 S 4.06 W
10	0.51 S 3.97 W
6	0.68 S 3.95 W
2	0.65 S 4.08 W
3	0.46 S 4.01 W

New Location ☐
Drill Deeper ☐
Abandonment ✚

Company W. R. Baker
Address Beatrice, W.Va.
Farm A.E. Lamp
Tract ____ Acres 169 Lease No. SC
Well (Farm) No. 1-2-3-5-6-10 Serial No. ____
Elevation (Spirit Level) 805-832-697-871-849-831
Quadrangle Harrisville
County Ritchie District Murphy
Engineer A.K. Westfall.
Engineer's Registration No. Co. Surveyor, Ritchie Co.
File No. ____ Drawing No. ____
Date April, 15 1941 Scale 1" = 30 Poles

"IMPERIAL" TRACING CLOTH
K & E CO., N. Y.

STATE OF WEST VIRGINIA
DEPARTMENT OF MINES
OIL AND GAS DIVISION
CHARLESTON

WELL LOCATION MAP

FILE NO. RIT-543A-545A INC 1-5-10
(6) RIT-567A

+ Denotes location of well on United States Topographic Maps, scale 1 to 62,500, latitude and longitude lines being represented by border lines as shown.

— Denotes one inch spaces on border line of original tracing.