
PLAT OF THE LOCATION OF WELL NO. 3 OF THE W. C. LAMP, OF VIENNA, W. VA. ON THE W. A. SMITH FARM, CONSISTING OF 101 ACRES, TO BE AFANDONED, LOCATED IN MURPHY DISTRICT, RITCHIE COUNTY.

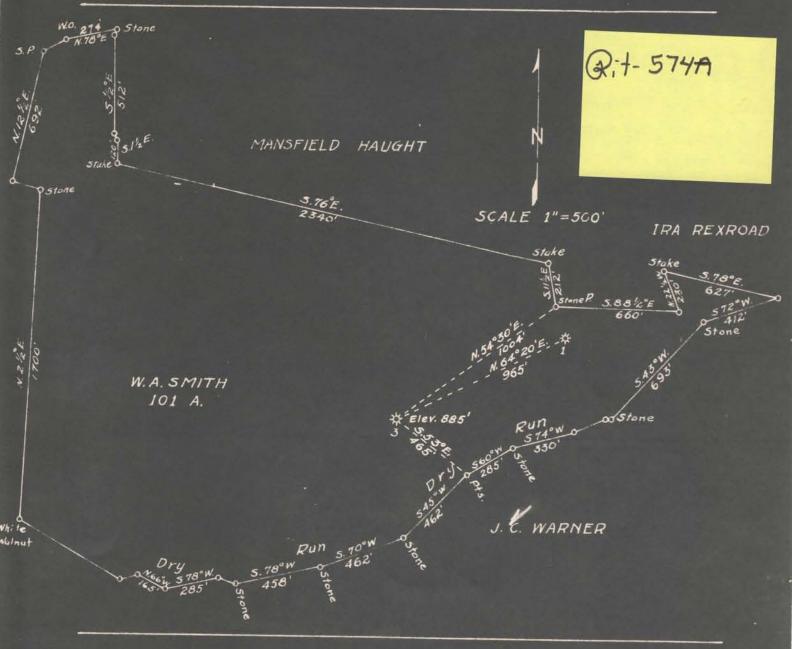

## ENGINEER'S CERTIFICATE

I, THE UNDERSIGNED, HEREBY CERTIFY THAT THIS MAP IS CORPECT, AND SHOWS ALL INFORMATION, TO THE FEST OF MY KNOWLEDGE AND FELIEF, REQUIRED BY THE OIL AND GAS SECTION OF THE MINING LAWS OF WEST VIRGINA.

B. F. Binehart

ACKNOWLEDGED REFORE ME A NOTARY PUBLIC FOR RITCHIE COUNTY, THIS 27 DAY OF 1935.

MOTARY PURILIC

MY COMMISSION EXPIRES / /

me 17

194

RIT -252

+t=(574-A