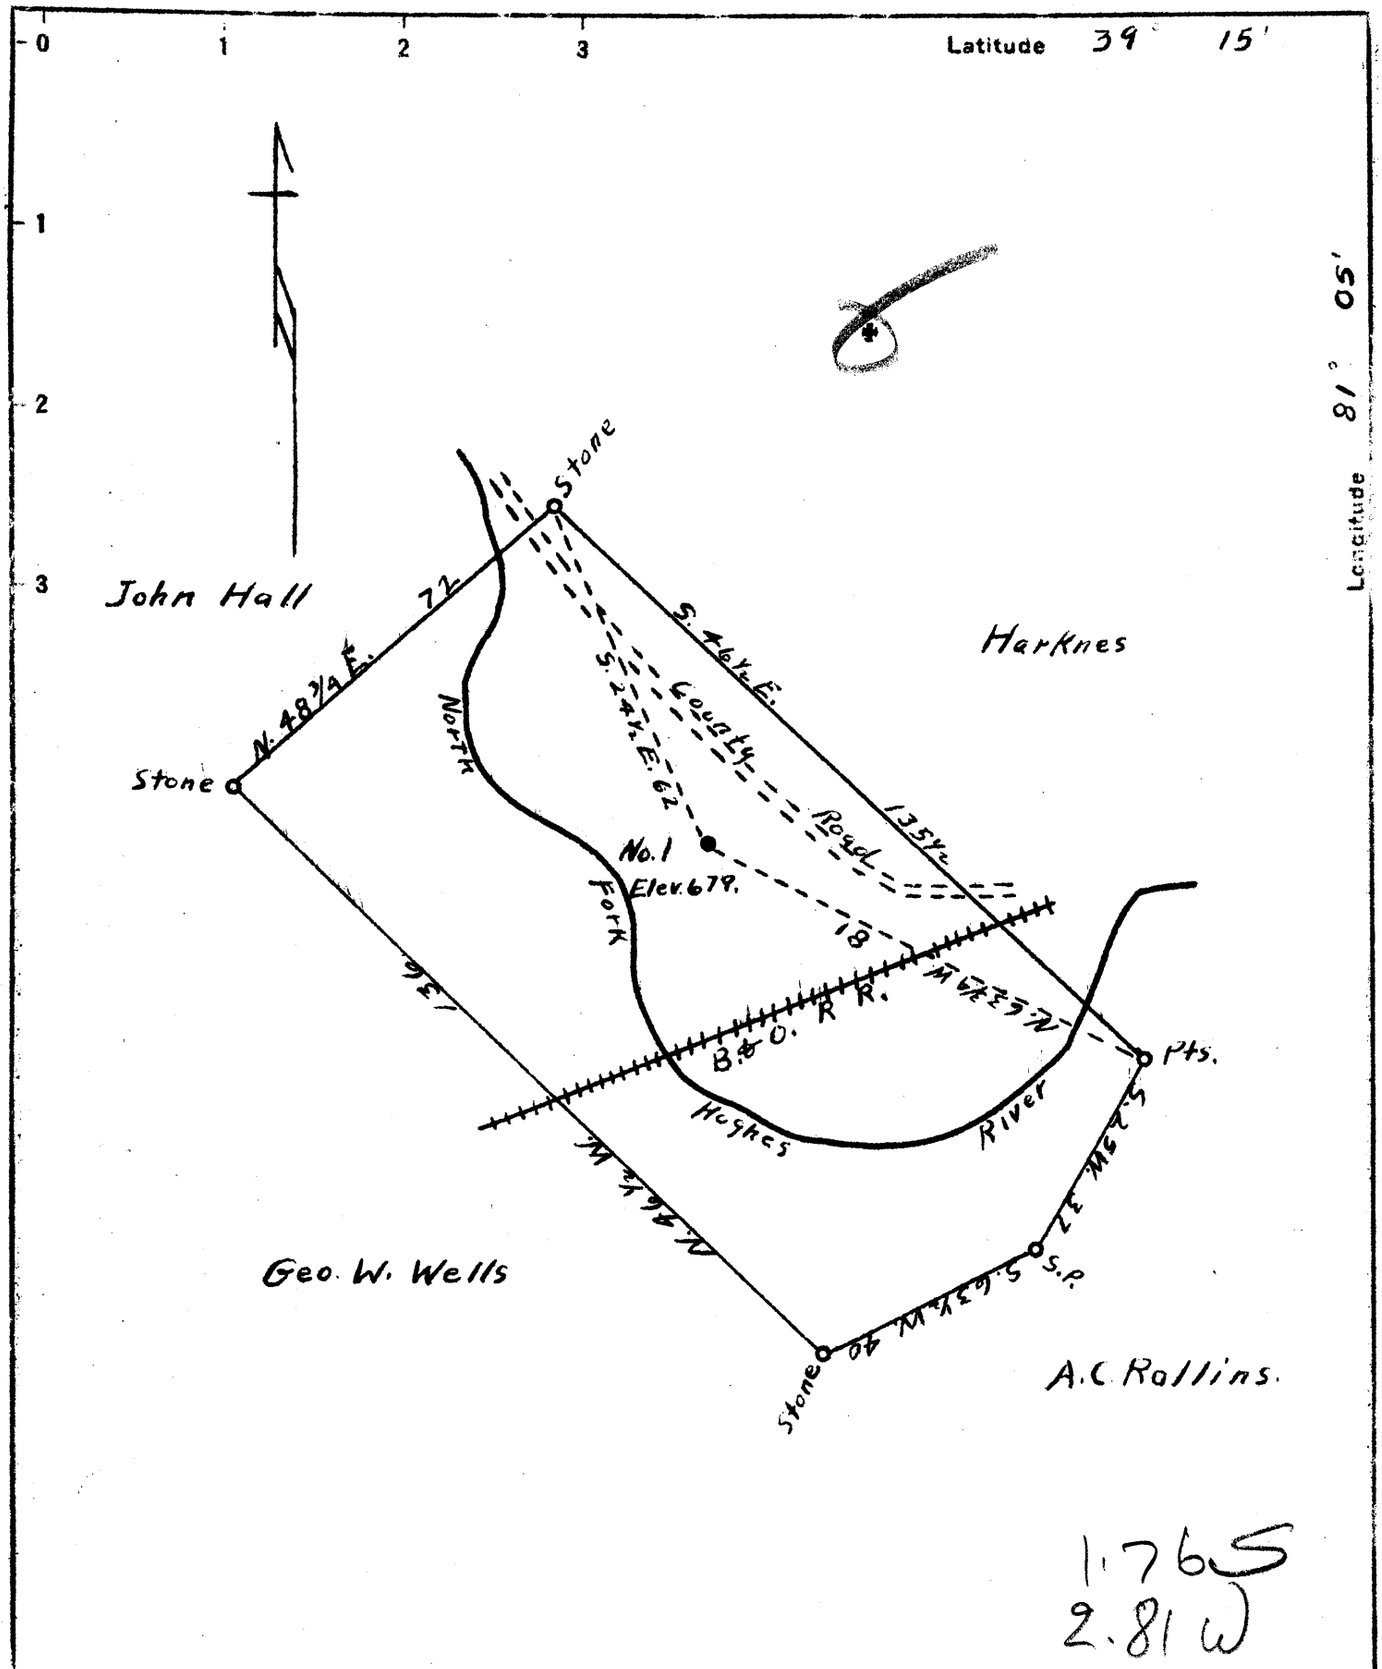

1.76 S
2.81 W

New Location ☐
Drill Deeper ☐
Abandonment ✓

Company Newman and Davitt
Address Stackport Ohio
Farm Blinda Lavelle Hrs
Tract _____ Acres 63½ Lease No. _____
Well (Farm) No. One Serial No. _____
Elevation (Spirit Level) 679
Quadrangle Harrisville
County Ritchie District Grant
Engineer A.K. Westfall
Engineer's Registration No. County Surveyor
File No. _____ Drawing No. _____
Date July 30, 1942 Scale 1" = 30 Poles

STATE OF WEST VIRGINIA
DEPARTMENT OF MINES
OIL AND GAS DIVISION
CHARLESTON

WELL LOCATION MAP

FILE NO. RIT-626-A

✚ Denotes location of well on United States Topographic Maps, scale 1 to 62,500, latitude and longitude lines being represented by border lines as shown.

— Denotes one inch spaces on border line of original tracing.

"IMPERIAL" TRACING CLOTH
K & E CO., N.Y.