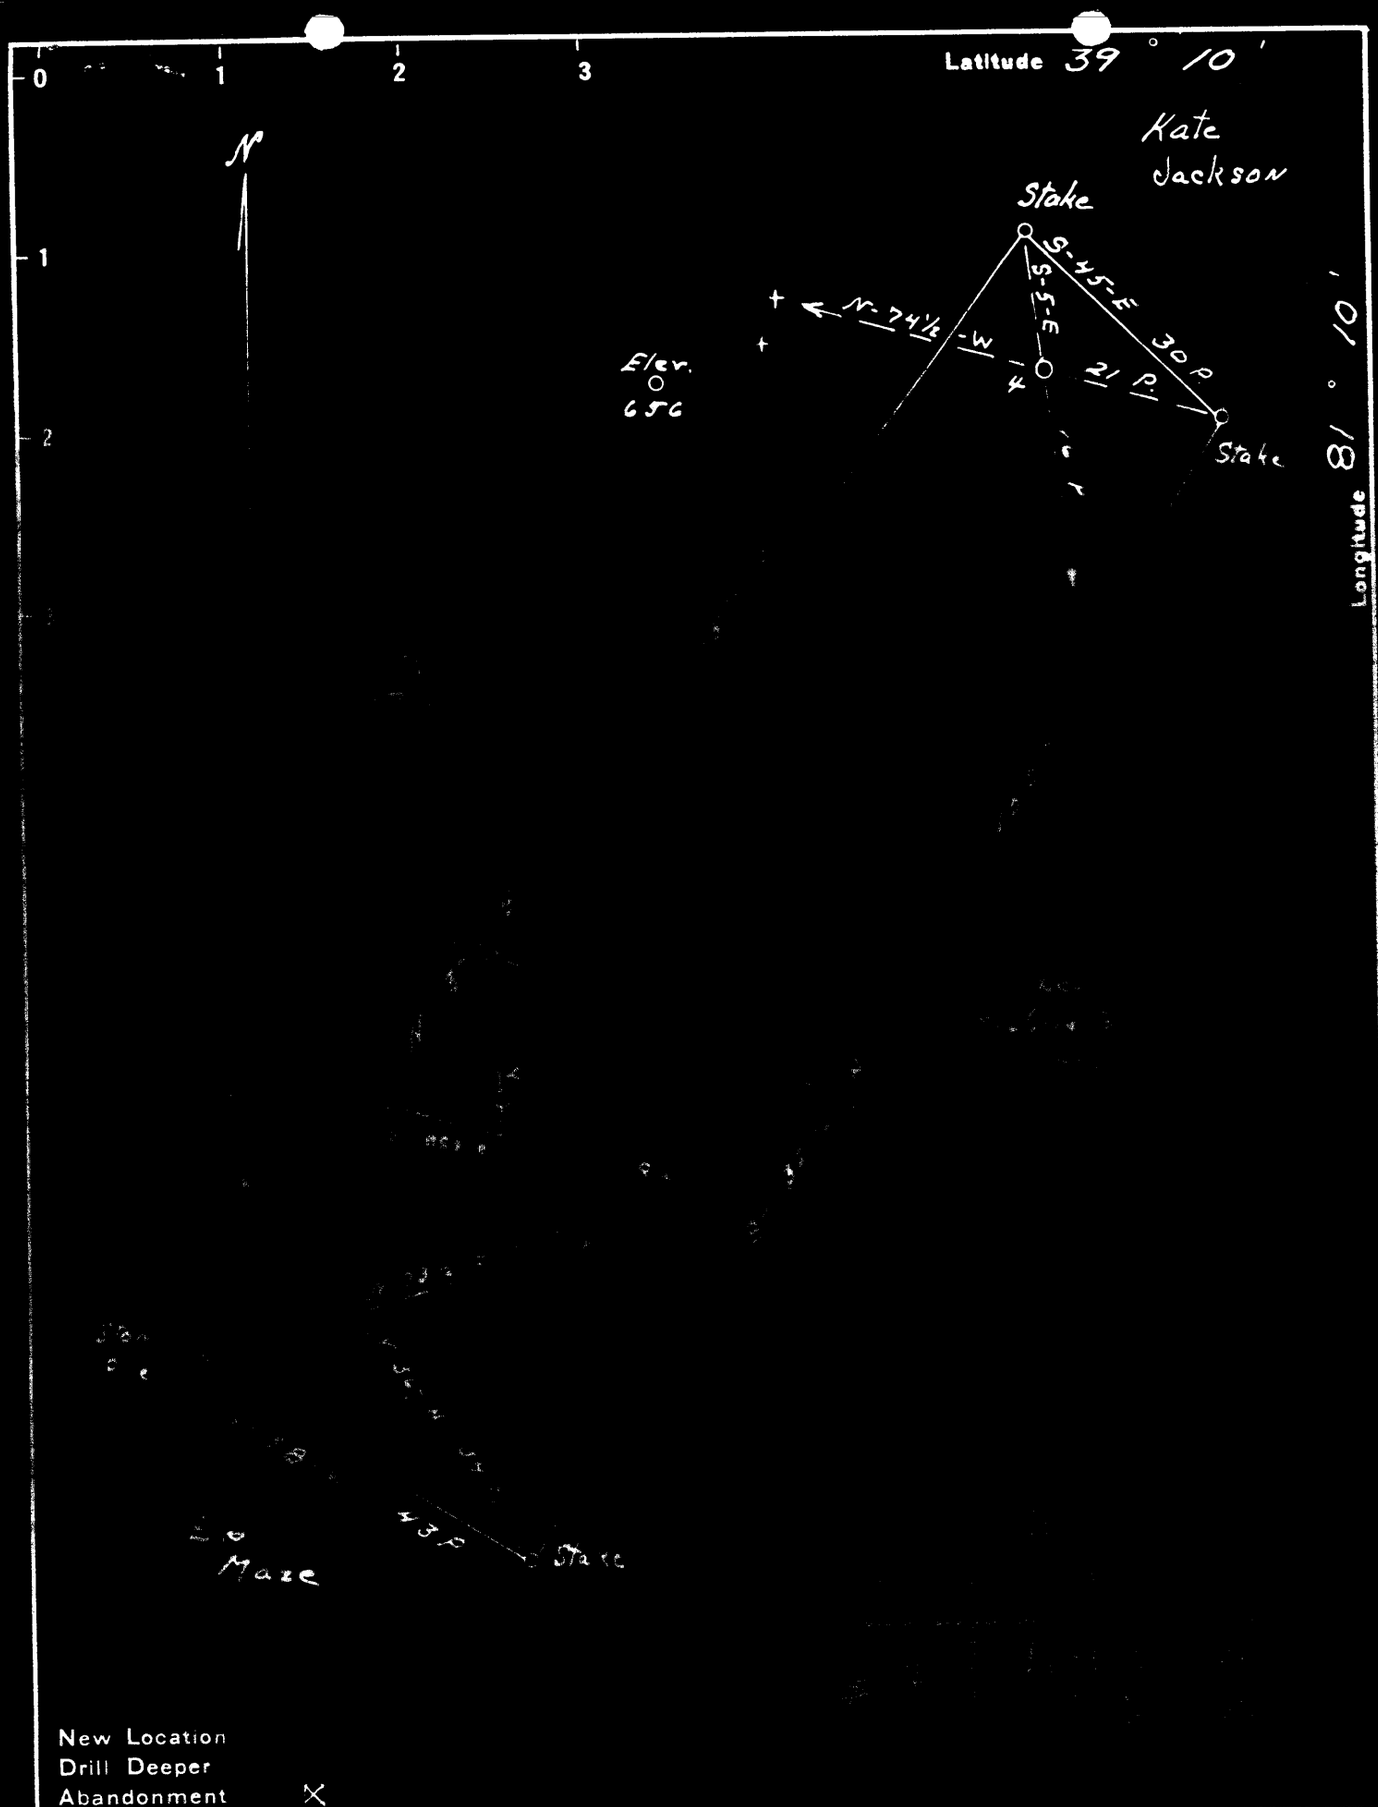

Company American Oil Development Co.
Address Sistersville West Virginia
Farm W. H. MAZE
Tract ____ Acres 34 Lease No. ____
Well (Farm) No. 1 & 4 Serial No. ____
Elevation (Spirit Level) 1-771.00 4-883.00
Quadrangle Harrisville
County Ritchie District Grant
Engineer J. J. Haught
Engineer's Registration No. County Surveyor Tyler County
File No. ____ Drawing No. ____
Date 3-7-49 Scale 20 rods = 1 inch

"IMPERIAL" TRACING CLOTH
K & E CO., N. Y.

STATE OF WEST VIRGINIA
DEPARTMENT OF MINES
OIL AND GAS DIVISION
CHARLESTON

WELL LOCATION MAP

FILE NO. Rit-917-A-#1 Rit-918-A-#4

+ Denotes location of well on United States Topographic Maps, scale 1 to 62,500, latitude and longitude lines being represented by border lines as shown.

— Denotes one inch spaces on border line of original tracing.