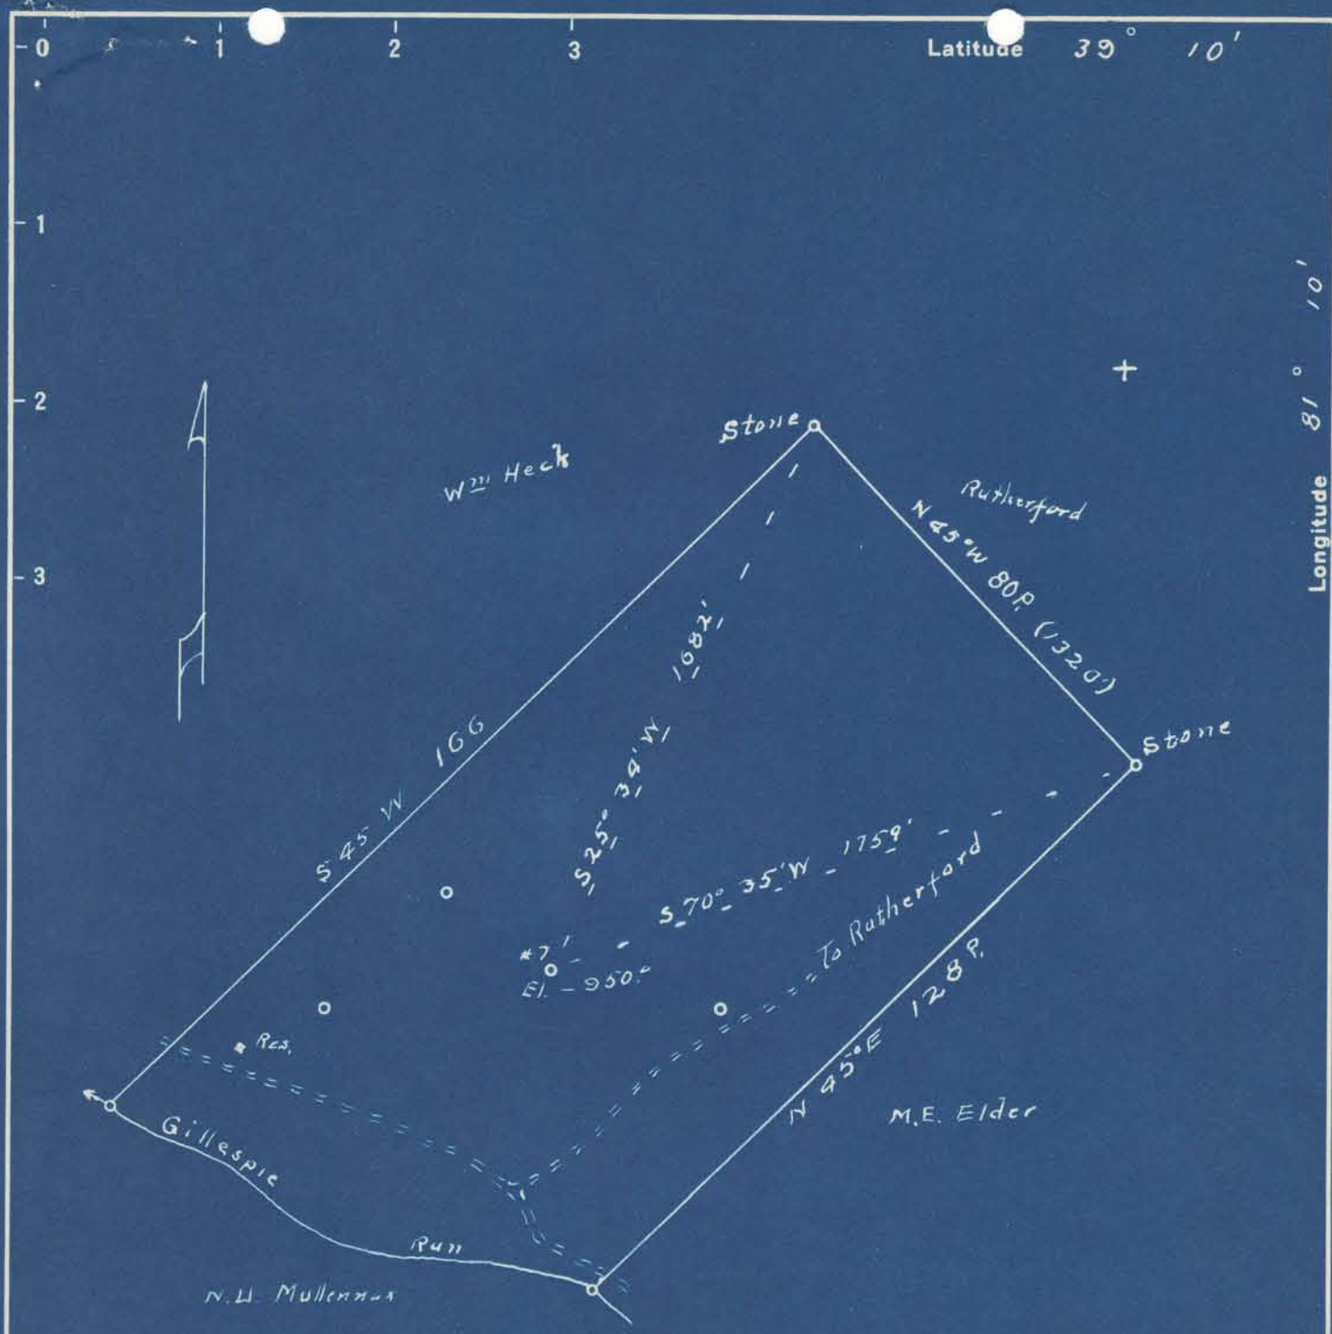

S 1.95
W 1.19

New Location ☐
Drill Deeper ☐
Abandonment ☒

Company Clarence Beardmore
Address 809 5th St. Marietta O.
Farm L.S. Felsenthal
Tract _____ Acres 72 Lease No. _____
Well (Farm) No. 7 Serial No. _____
Elevation (Spirit Level) 950° WC
Quadrangle Harrisville
County Ritchie District Grant
Engineer Robert R. Cochran by O. Meredith
Engineer's Registration No. 296
File No. _____ Drawing No. _____
Date June 16th 32 Scale 1 in = 30 Poles

STATE OF WEST VIRGINIA
DEPARTMENT OF MINES
OIL AND GAS DIVISION
CHARLESTON

WELL LOCATION MAP

FILE NO. Rit-990-A

+ Denotes location of well on United States Topographic Maps, scale 1 to 62,500, latitude and longitude lines being represented by border lines as shown.

— Denotes one inch spaces on border line of original tracing.

"IMPERIAL" TRACING CLOTH
K & E CO., N. Y.

DG-10

STATE OF WEST VIRGINIA
DEPARTMENT OF MINES
OIL AND GAS DIVISION

WELL RECORD

Permit No. Rit-990-P2

Oil or Gas Well oil (KIND)

Company C.E. Beardmore
Address 809-5th St. Marietta, Ohio
Farm L.S. Felsenthal Acres 72
Location (waters) Gillispie Run
Well No. 7 Elev. 950
District Grant County Ritchie
The surface of tract is owned in fee by Lloyd Hill
Star Route Address Cairo, W.Va.
Mineral rights are owned by same
Address
Drilling commenced 4-22-14
Drilling completed 5-20-14
Date Shot 5-21-14 From 1747 To 1757
With 40 qts.
Open Flow /10ths Water in Inch
/10ths Merc. in Inch
Volume Cu. Ft.
Rock Pressure lbs. hrs.
Oil 8 bbls., 1st 24 hrs.
Fresh water feet feet
Salt water feet feet

Casing and Tubing	Used in Drilling	Left in Well	Packers
Size			
16			Kind of Packer
13			
10	160		Size of
8¼	1100		
6⅝	1580	1580	Depth set
5 3/16			
3			Perf. top
2	1763	1763	Perf. bottom
Liners Used			Perf. top
			Perf. bottom

CASING CEMENTED SIZE No. Ft. Date

COAL WAS ENCOUNTERED AT None FEET INCHES
FEET INCHES FEET INCHES
FEET INCHES FEET INCHES

Formation	Color	Hard or Soft	Top	Bottom	Oil, Gas or Water	Depth Found	Remarks
Salt Sand			1724	1763	oil	1751	

SEP 1950
WEST VIRGINIA
DEPARTMENT OF MINES

(Over)

NOV 18 1950

Formation	Color	Hard or Soft	Top	Bottom	Oil, Gas or Water	Depth Found	Remarks

Date 9 5, 1950

APPROVED C. E. Bearsmore, Owner

By owner
(Title)

MATHEWS PRINTING AND LITHOGRAPHING CO
CHARLESTON W. VA.