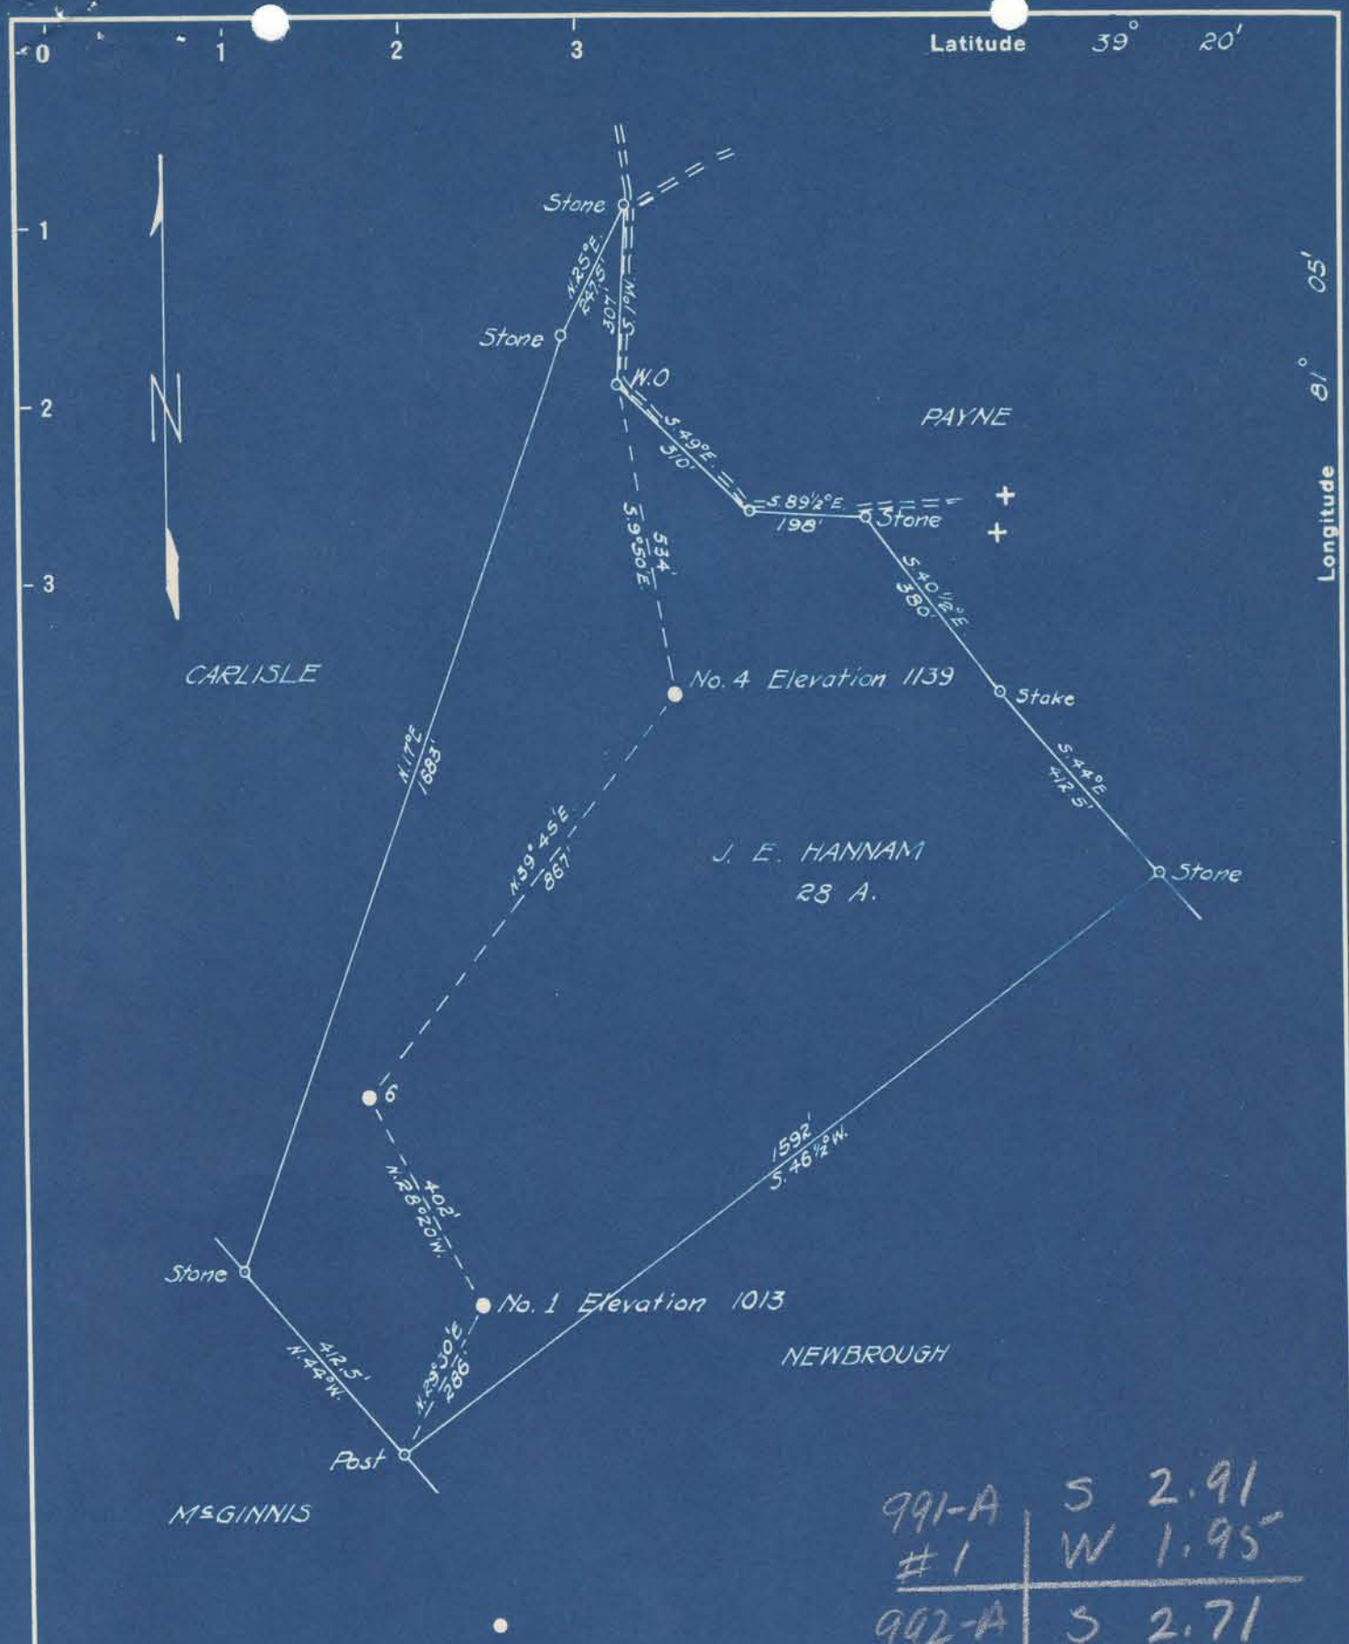

991-A #1	S	2.91
	W	1.95
992-A #4	S	2.71
	W	1.91

New Location ☐
Drill Deeper ☐
Abandonment ☑

Company GENERAL OIL CO.
Address PARKERSBURG, W. VA.
Farm J. E. HANNAM
Tract _____ Acres 28 Lease No. _____
Well (Farm) No. 1 & 4 Serial No. _____
Elevation (Spirit Level) 1013 & 1139
Quadrangle SAINT MARYS
County RITCHIE District GRANT
Engineer B. F. RINEHART
Engineer's Registration No. 648
File No. _____ Drawing No. 762-GR.
Date July 29, 1950 Scale 1 in. = 300 ft.

STATE OF WEST VIRGINIA
DEPARTMENT OF MINES
OIL AND GAS DIVISION
CHARLESTON

WELL LOCATION MAP

FILE NO. Rit-991-A-#1
Rit-992-A-#4

+ Denotes location of well on United States Topographic Maps, scale 1 to 62,500, latitude and longitude lines being represented by border lines as shown.

— Denotes one inch spaces on border line of original tracing.

"IMPERIAL" TRACING CLOTH
K & E CO., N. Y.

OG-10

STATE OF WEST VIRGINIA
DEPARTMENT OF MINES
OIL AND GAS DIVISION

WELL RECORD

Permit No. BTF 991-A

Oil or Gas Well Oil (KIND)

Company General Oil Co., Inc.
Address Box 1755 Parkersburg, W. Va. 215 - 4th St.
Farm J. E. Hannam Acres 28
Location (waters) Wolf Pen Run
Well No. 1 Elev. 1013
District Grant County Ritchie
The surface of tract is owned in fee by J. E. Hannum
Address Cairo, R2, W. Va.
Mineral rights are owned by J. E. Hannum
Address Cairo R2, W. Va.
Drilling commenced Not known
Drilling completed Feby 6, 1917
Date Shot not known From To
With
Open Flow /10ths Water in Inch
/10ths Merc. in Inch
Volume Cu. Ft.
Rock Pressure lbs. hrs.
Oil bbls., 1st 24 hrs.
Fresh water feet feet
Salt water feet feet

Casing and Tubing	Used in Drilling	Left in Well	Packers
Size			
16			Kind of Packer
13			
10			Size of
8¼			
6⅝		1630	Depth set
5 3/16			
3			Perf. top
2			Perf. bottom
Liners Used			Perf. top
			Perf. bottom

CASING CEMENTED SIZE No. Ft. Date

COAL WAS ENCOUNTERED AT FEET INCHES
FEET INCHES FEET INCHES
FEET INCHES FEET INCHES

Formation	Color	Hard or Soft	Top	Bottom	Oil, Gas or Water	Depth Found	Remarks
Well purchased by us in 1947. No well record. The only information we have is Maxon 1725 - Oil 1760 - Total depth 1790							

SEP 1950 WEST VIRGINIA DEPARTMENT OF MINES

NOV 18 1950

(Over)

Formation	Color	Hard or Soft	Top	Bottom	Oil, Gas or Water	Depth Found	Remarks

Date Sept. 8, 1950

APPROVED General Oil Co Inc, Owner

By A H Decker, Secy & Treas
(Title)

MATHEWS PRINTING AND LITHOGRAPHING CO
CHARLESTON W VA