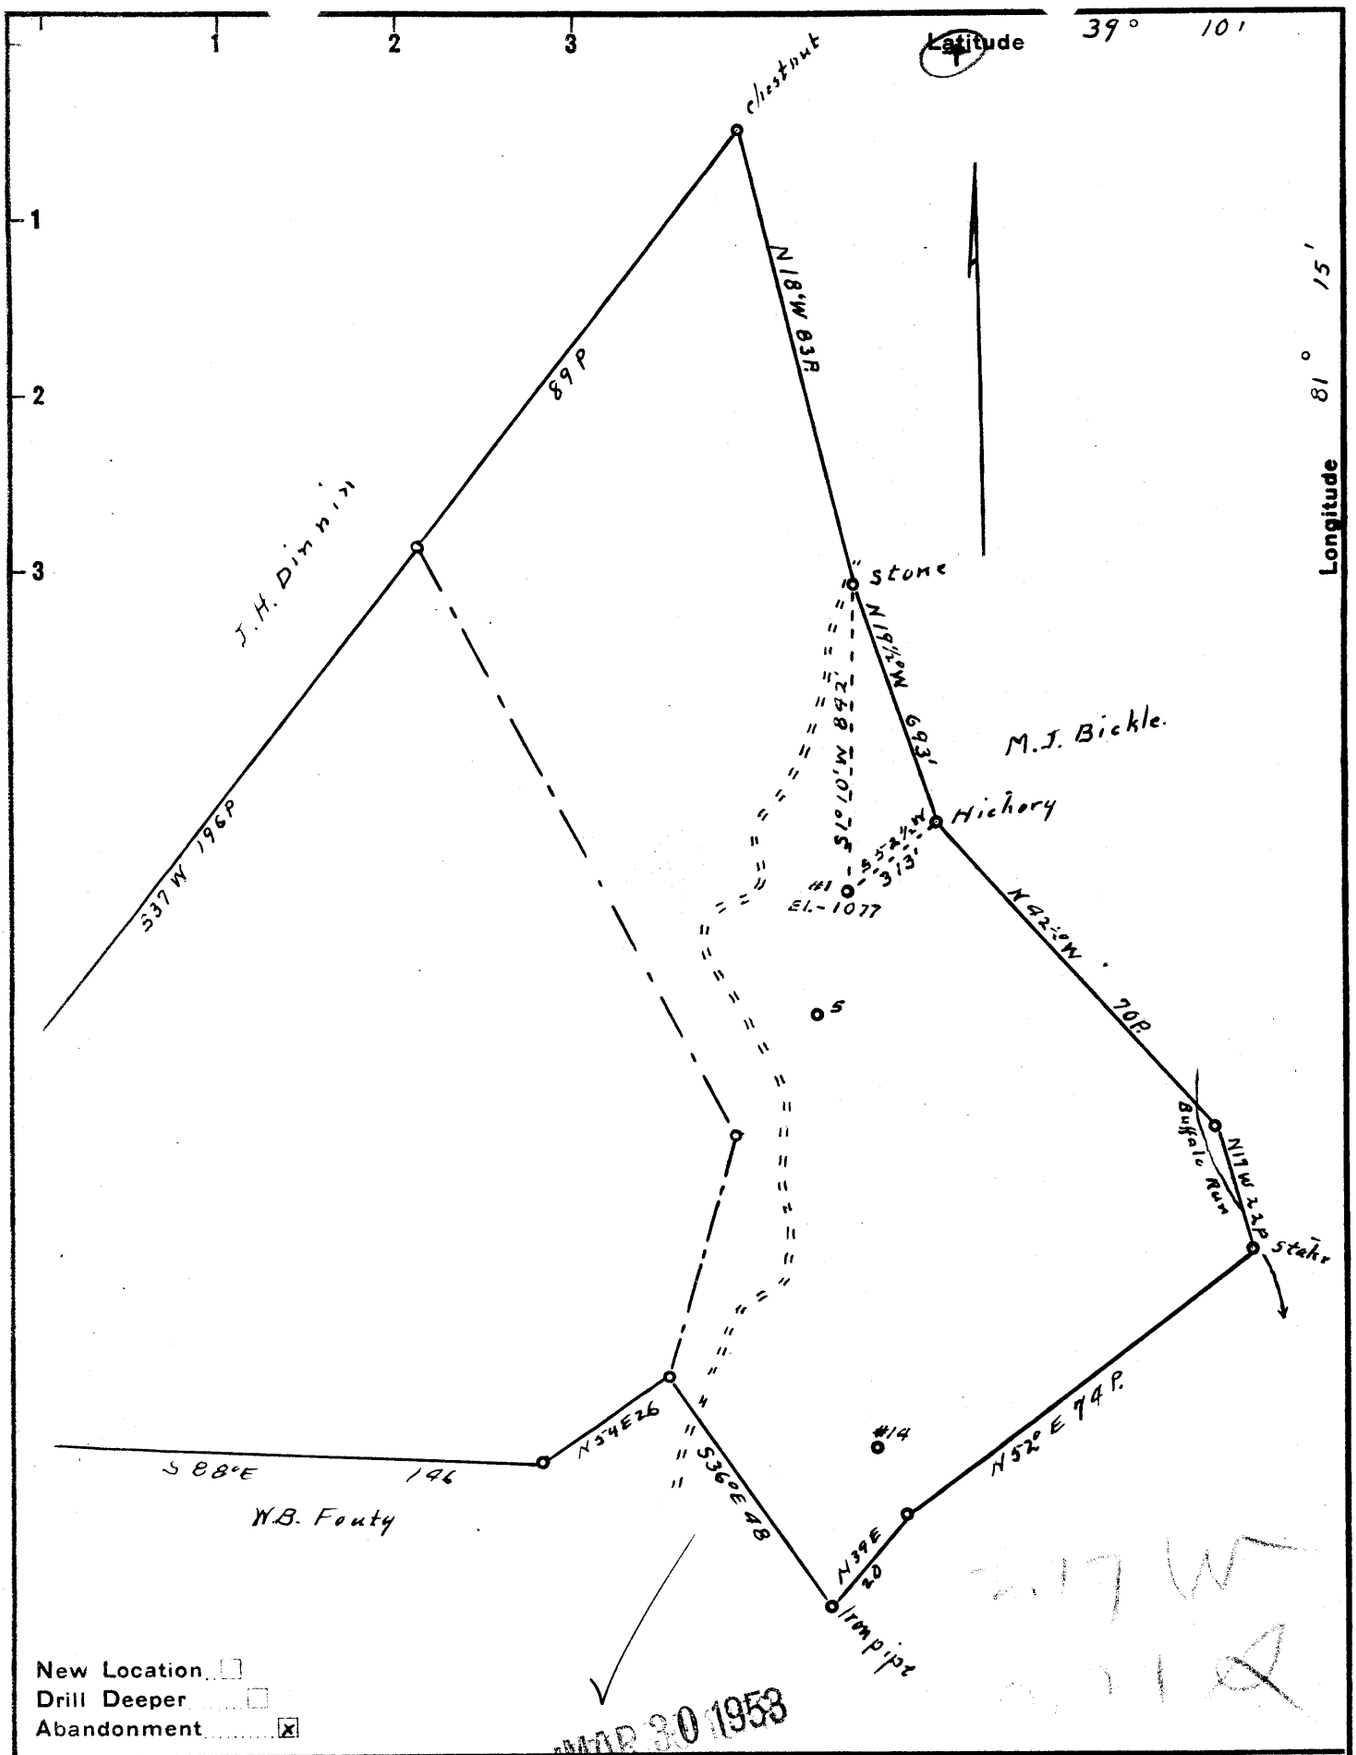

New Location ☐
Drill Deeper ☐
Abandonment ☒

MAR 30 1953

Company Piersol Smith, Feick & Coss
Address R.2 Walker W. Va.
Farm Astron Oil Co
Tract _____ Acres 92.75 Lease No. _____
Well (Farm) No. 1 Serial No. _____
Elevation (Spirit Level) 1077' EL
Quadrangle Elizabeth
County Ritchie District Grant
Engineer Robert R Anderson
Engineer's Registration No. 296
File No. _____ Drawing No. _____
Date 3/19 53 Scale 1 in = 30 Poles

STATE OF WEST VIRGINIA
DEPARTMENT OF MINES
OIL AND GAS DIVISION
CHARLESTON

WELL LOCATION MAP

FILE NO. Rit-1189-A

+ Denotes location of well on United States Topographic Maps, scale 1 to 62,500, latitude and longitude lines being represented by border lines as shown.

— Denotes one inch spaces on border line of original tracing.

156 IMPERIAL

ASTRON OIL CO. NO. 1 — PIERSOL, SMITH, FEICK & COSS — RIT-1189-A