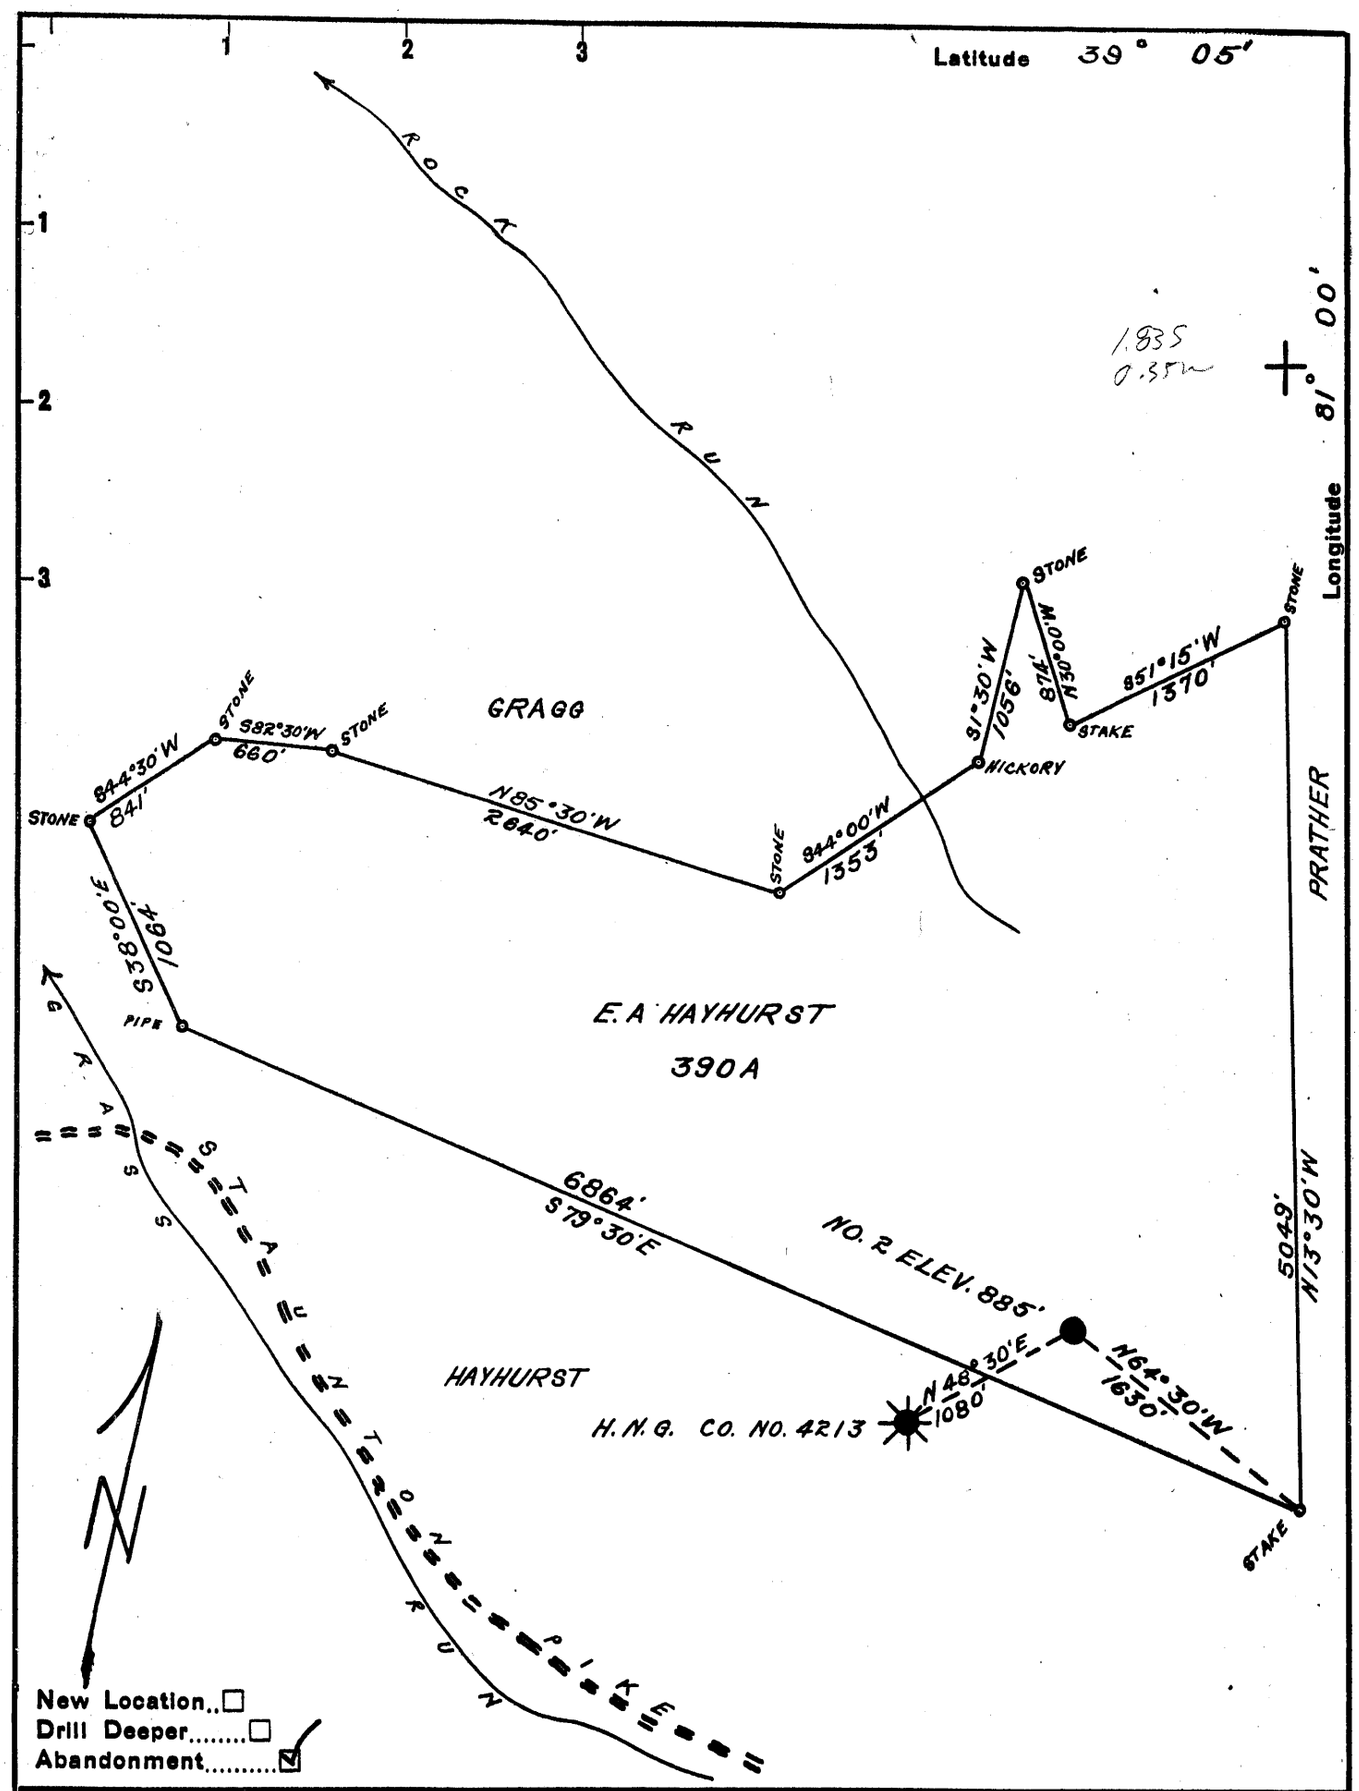

Company OTIS HARDIN

Address WILLIAMSTOWN, W. VA.

Farm E. A. HAYHURST

Tract _____ Acres 390 Lease No. _____

Well (Farm) No. 2 Serial No. _____

Elevation (Spirit Level) 885'

Quadrangle HARRISVILLE

County RITCHIE District MURPHY

Engineer Donald W. Morris

SURVEYED BY J. F. DEEM

Engineer's Registration No. 1653

File No. _____ Drawing No. _____

Date MARCH 6, 1954 Scale 1" = 1000'

STATE OF WEST VIRGINIA
DEPARTMENT OF MINES
OIL AND GAS DIVISION
CHARLESTON

WELL LOCATION MAP

FILE NO. Rit-1232-A

+ Denotes location of well on United States Topographic Maps, scale 1 to 62,500, latitude and longitude lines being represented by border lines as shown.

— Denotes one inch spaces on border line of original tracing.