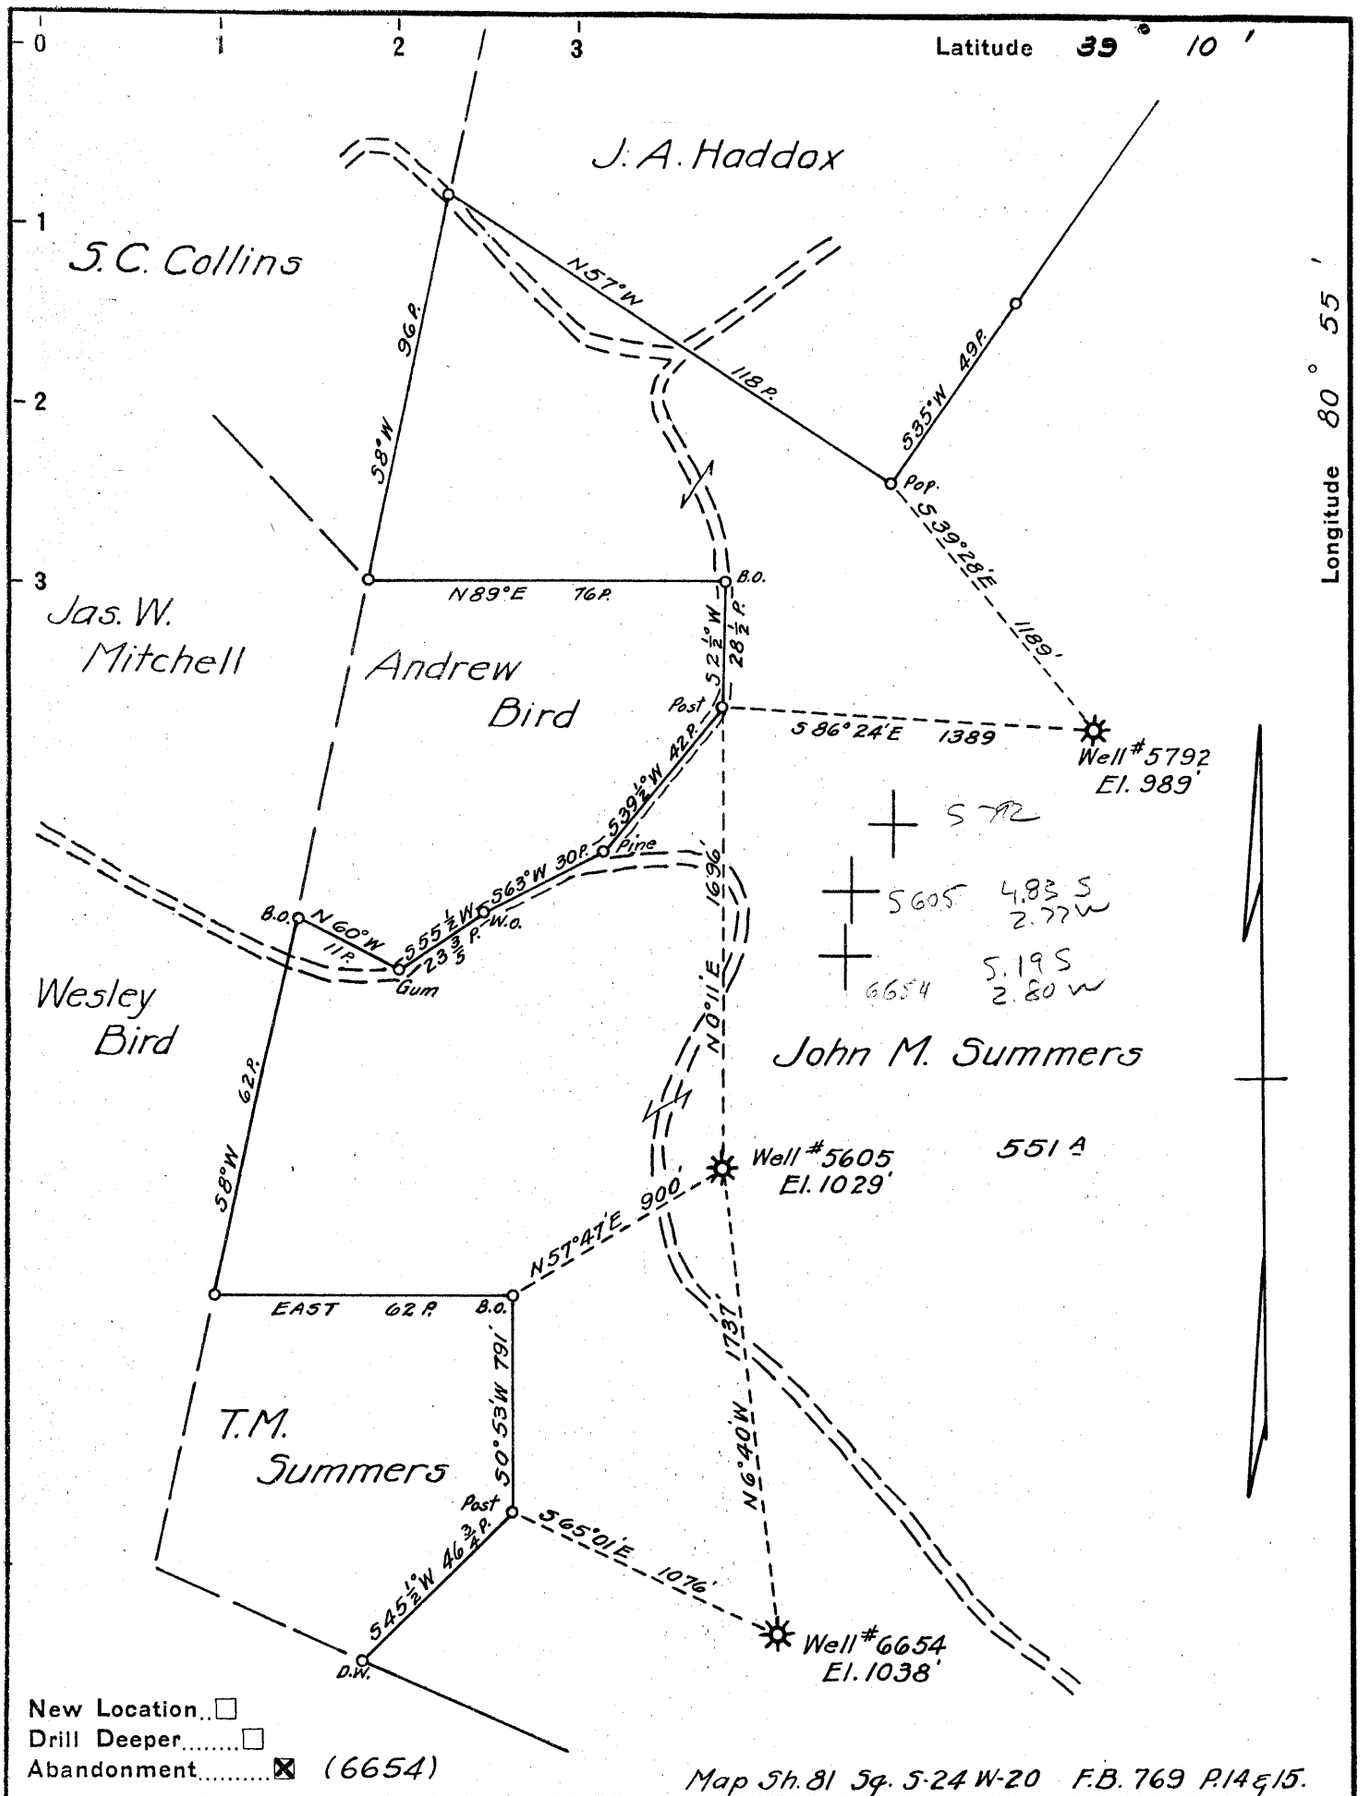


Company Hope Natural Gas Co.
Address Clarksburg, W. Va.
Farm John M. Summers
Tract _____ Acres 551 Lease No. 22704
Well (Farm) No. _____ Serial No. As Shown
Elevation (Spirit Level) As Shown
Quadrangle Holbrook
County Ritchie District Union
Engineer W M Bowers
Engineer's Registration No. 900
File No. _____ Drawing No. _____
Date July 9, 1945 Scale 1" = 40 Po.

STATE OF WEST VIRGINIA
DEPARTMENT OF MINES
OIL AND GAS DIVISION
CHARLESTON

# WELL LOCATION MAP

FILE NO. Rit-728-A-#6654
Rit-1235-A-#5605

+ Denotes location of well on United States Topographic Maps, scale 1 to 62,500, latitude and longitude lines being represented by border lines as shown.

— Denotes one inch spaces on border line of original tracing.