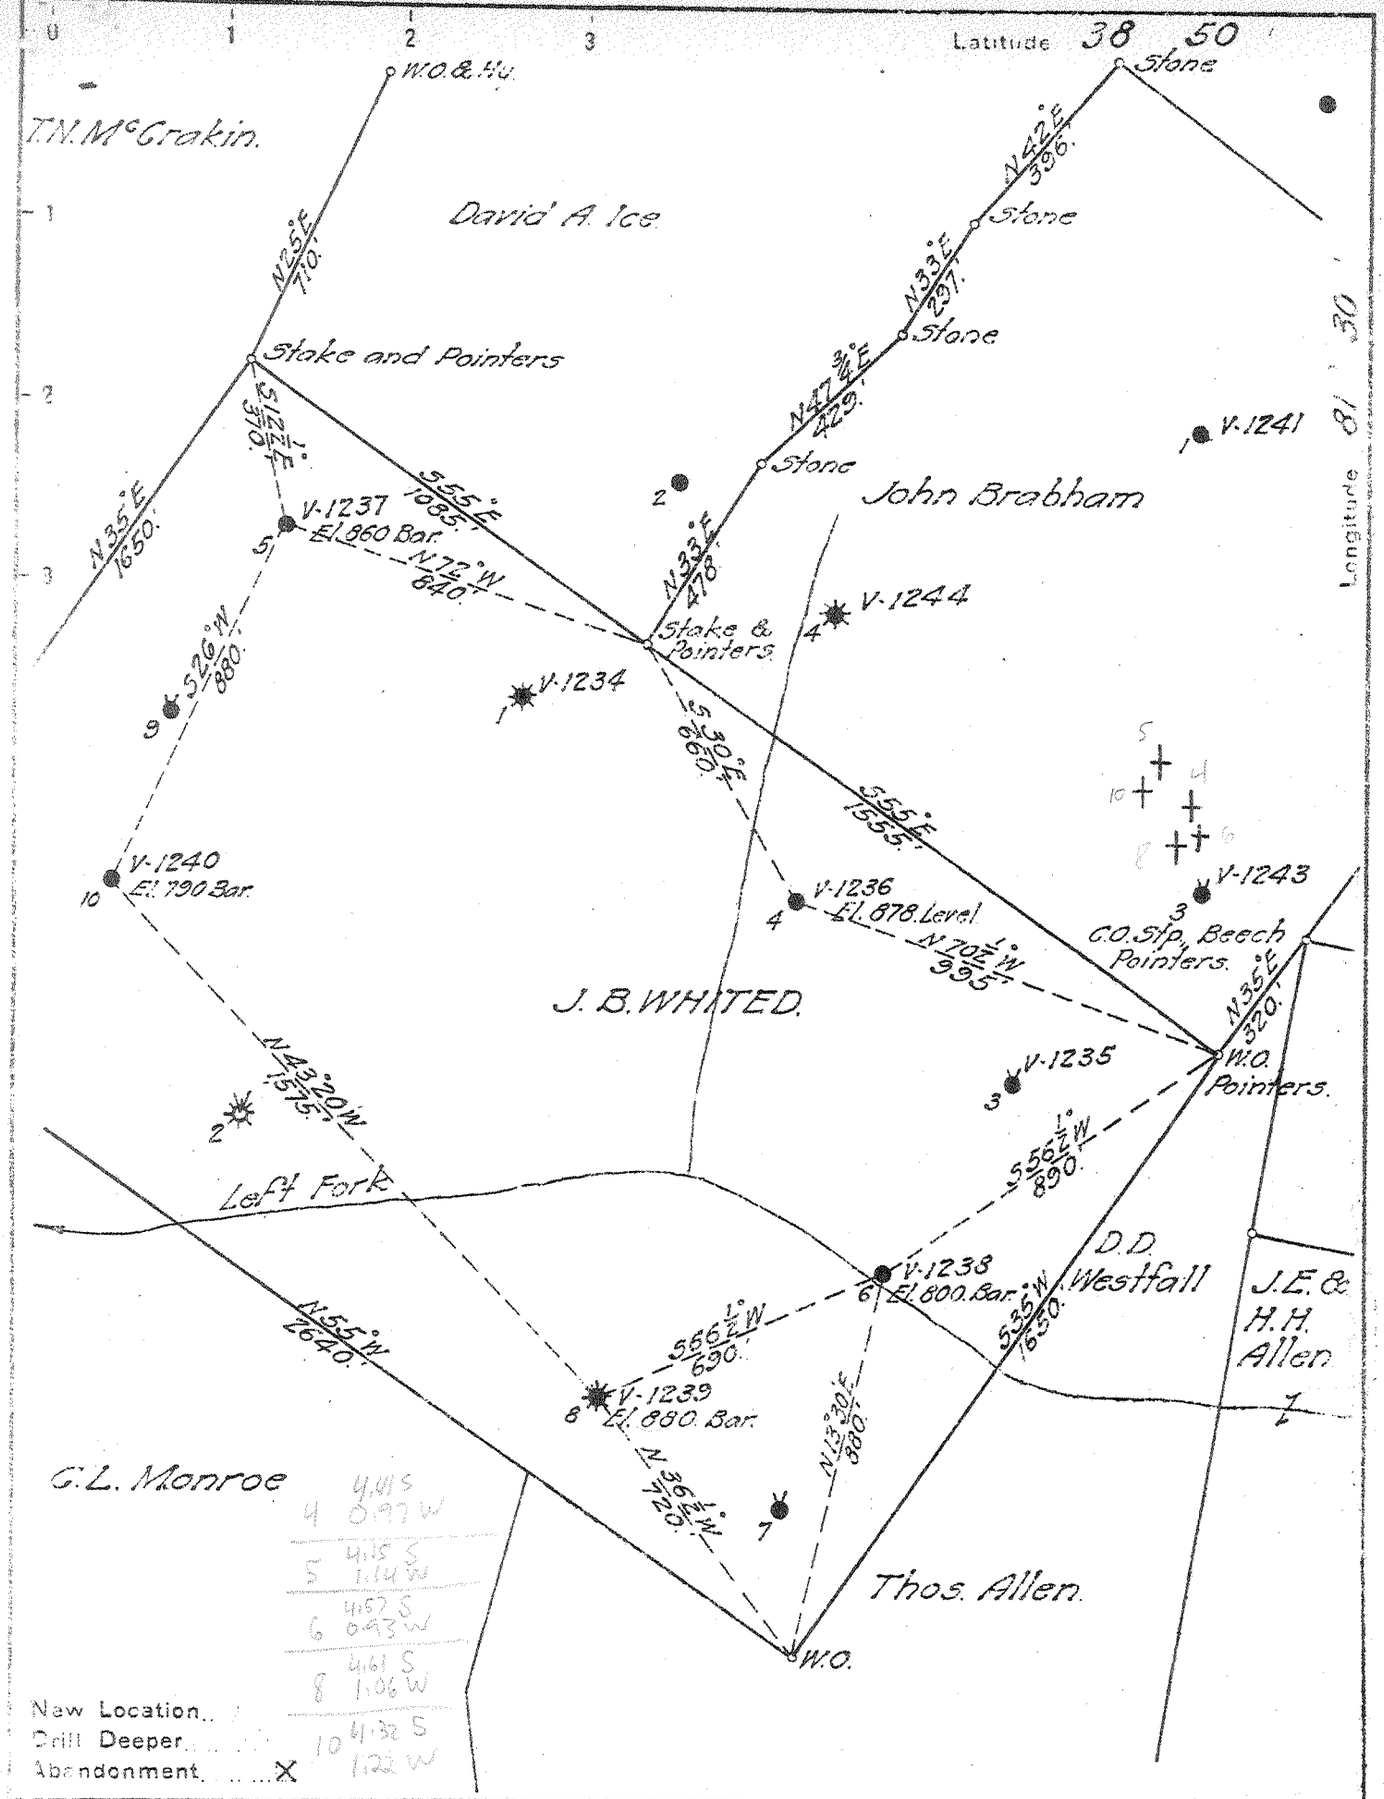

Company SUPERIOR PIPE & SUPPLY CO.
Address GRAND RAPIDS, MICHIGAN
Farm J.B. WHITED
Tract ____ Acres 100 Lease No. 15819
Well (Farm) No. 4568&10 Serial No. ____
Elevation ~~(Spirit Level)~~ AS SHOWN
Quadrangle RIPLEY
County ROANE District CURTIS
Engineer [illegible]
Engineer's Registration No. 659
File No. 68-87 Drawing No. ____
Date Oct. 23, 1944 Scale 1" = 400'

STATE OF WEST VIRGINIA
DEPARTMENT OF MINES
OIL AND GAS DIVISION
CHARLESTON

ROA-424-A - #10; ROA-425-A-#5

WELL LOCATION MAP

FILE NO. ~~ROA-413-A~~ - #4
~~ROA-414-A~~ - #6
ROA-416-A - #8

+ Denotes location of well on United States Topographic Maps, scale 1 to 62,500, latitude and longitude lines being represented by border lines as shown.

— Denotes one inch spaces on border line of original tracing.