

Diversified Gas & Oil  
Corporation  
100 Diversified Way  
Pikeville KY, 41501

47-095-00050  
Well Plugging Map


**Legend**

- Well
- Access Road
- Pits
- Pad
- Public Roads



1 " = 500'  
0 250 500  
Ft

Copyright © 2013 National Geographic Society, Inc.

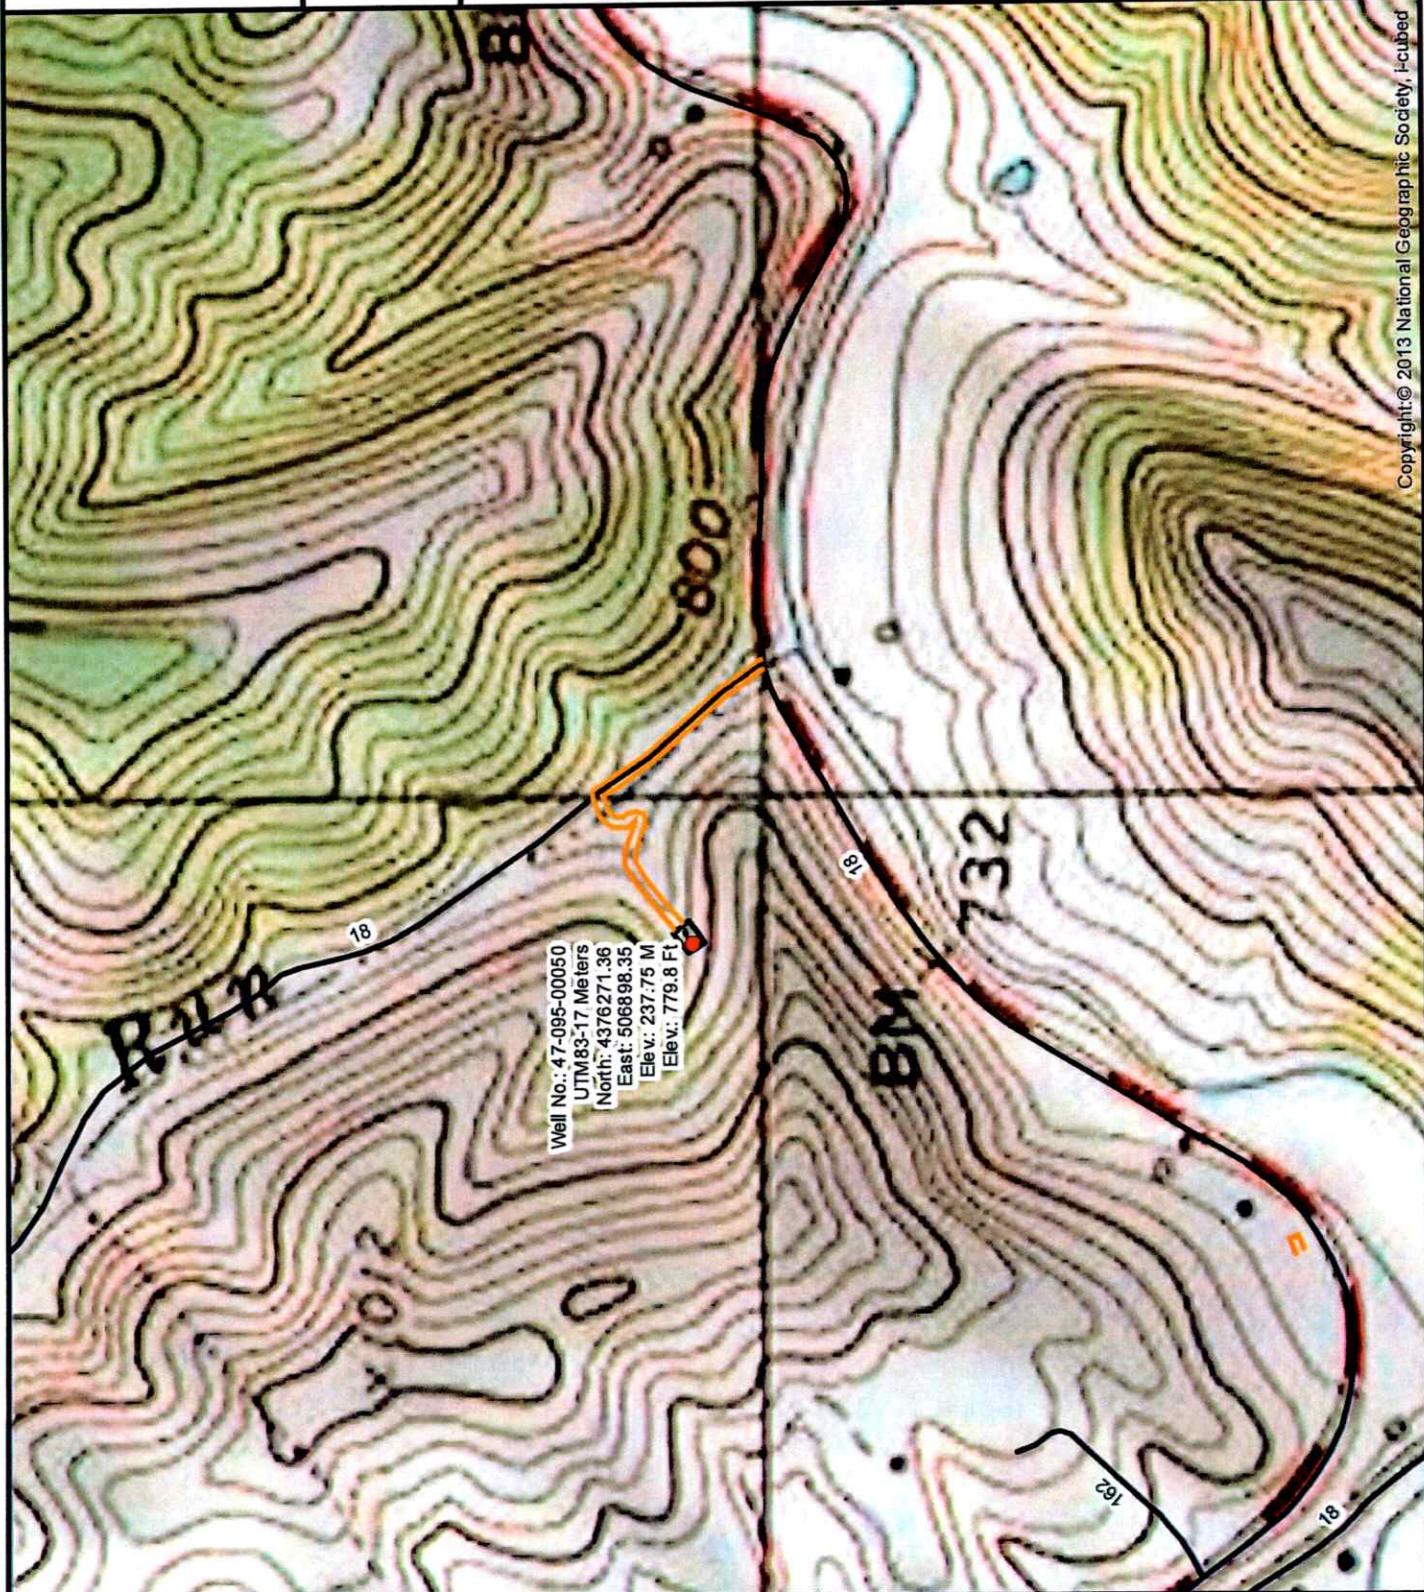

01/16/2026



**Diversified Gas & Oil  
Corporation**  
**100 Diversified Way  
Pikeville KY, 41051**

47-095-00050

---

Well Plugging Map

### Legend



Source: EST, MEX, EARTH Geographic, and the GCS User Community

Well No.: 47-095-000050  
UTM83-17Meters  
North: 4376271.36  
East: 506898.35  
Elev.: 237.75 M  
Elev.: 779.8 F

01/16/2026

WW-7  
8-30-06



West Virginia Department of Environmental Protection  
Office of Oil and Gas  
**WELL LOCATION FORM: GPS**

API: 4709500050 WELL NO.: O.J. Wells #1

FARM NAME: O.J. Wells and Heirs

RESPONSIBLE PARTY NAME: Diversified Production, LLC

COUNTY: Tyler DISTRICT: Lincoln

QUADRANGLE: Paden City 7.5'

SURFACE OWNER: Velma Luella Wells

ROYALTY OWNER: \_\_\_\_\_

UTM GPS NORTHING: 4376271.36

UTM GPS EASTING: 506898.35 GPS ELEVATION: 779.8'

The Responsible Party named above has chosen to submit GPS coordinates in lieu of preparing a new well location plat for a plugging permit or assigned API number on the above well. The Office of Oil and Gas will not accept GPS coordinates that do not meet the following requirements:

1. Datum: NAD 1983, Zone: 17 North, Coordinate Units: meters, Altitude: height above mean sea level (MSL) – meters.

2. Accuracy to Datum – 3.05 meters


3. Data Collection Method:

Survey grade GPS       : Post Processed Differential         
Real-Time Differential       

Mapping Grade GPS X : Post Processed Differential X  
Real-Time Differential       

4. Letter size copy of the topography map showing the well location.

I the undersigned, hereby certify this data is correct to the best of my knowledge and belief and shows all the information required by law and the regulations issued and prescribed by the Office of Oil and Gas.

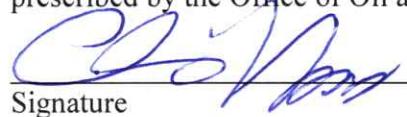  
Signature

Chris Veazey - Director of Administration

Title

RECEIVED  
Office of Oil and Gas  
OCT 27 2025

WV Department of  
Environmental Protection

  
Date

01/16/2026