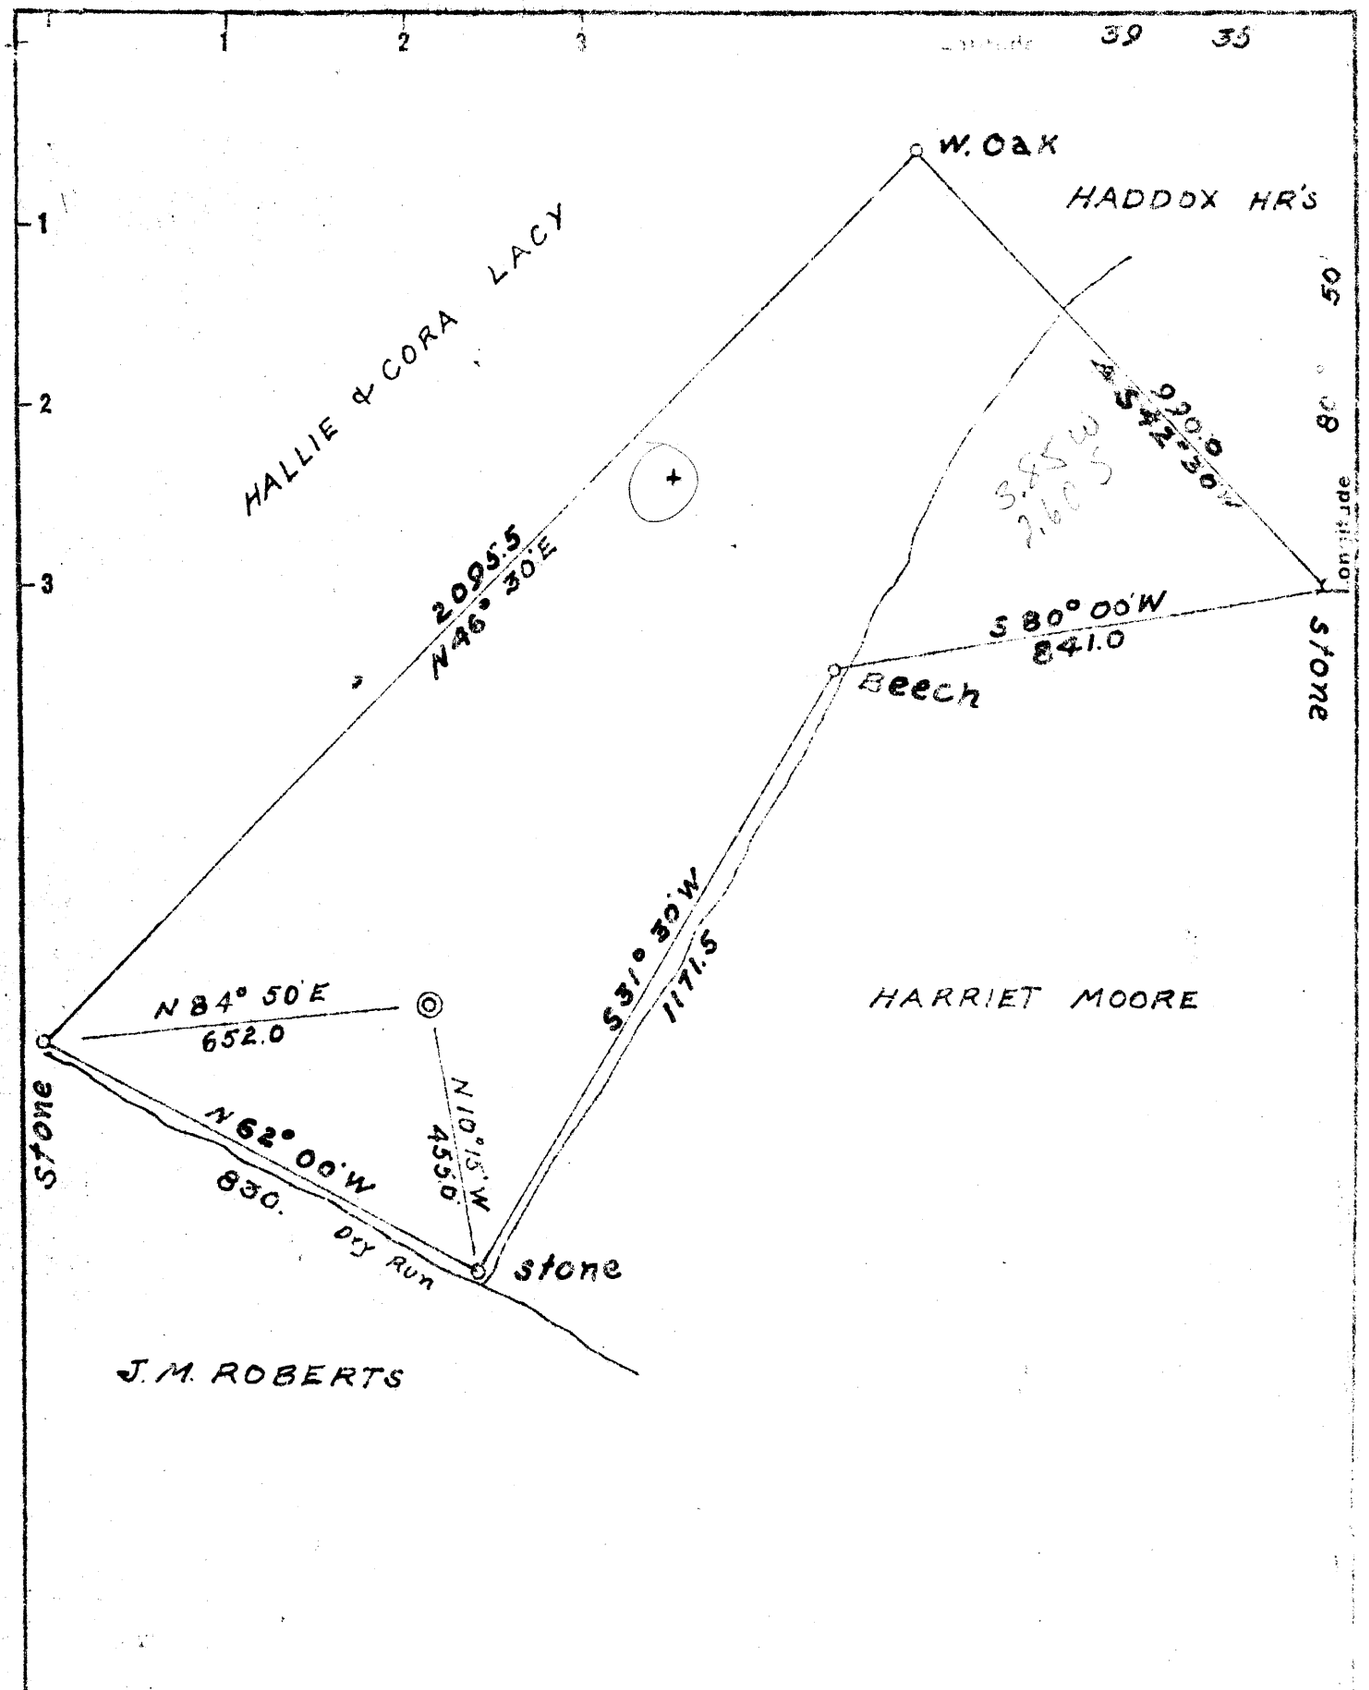

New Location ☒
Drill Deeper ☐
Abandonment ☐

plugged 07/28/1959

Company ANTHONY GUGHICELLO
Address BOX 62 NORTH BEND Pa.
Farm JOHN BUNTING
Tract _____ Acres 33.25 Lease No. _____
Well (Farm) No. ONE Serial No. _____
Elevation (Spirit Level) 811.0
Quadrangle NEW MARTINSVILLE SE
County TYLER District LINCOLN
Engineer GEORGE L. McINTIRE
Engineer's Registration No. 1187
File No. _____ Drawing No. _____
Date 9/1/52 Scale 1" = 300'

STATE OF WEST VIRGINIA
DEPARTMENT OF MINES
OIL AND GAS DIVISION
CHARLESTON

WELL LOCATION MAP
FILE NO. JYL-213

+ Denotes location of well on United States Topographic Maps, scale 1 to 62,500, latitude and longitude lines being represented by border lines as shown.

— Denotes one inch spaces on border line of original tracing.

K+E 156 IMPERIAL TRACING CLOTH

(030)

STATE OF WEST VIRGINIA
DEPARTMENT OF MINES
OIL AND GAS DIVISION

Quadrangle NEW MARTINSVILLE

Permit No. TYL-213-

WELL RECORD

Oil or Gas Well DRY (KIND)

Company ANTHONY GUGHICELLO
Address Box 62 - North Bend, Pa.
Farm John Bunting Acres 33.25
Location (waters) Dry Run
Well No. 1 Elev. 811.0'
District Lincoln County Tyler
The surface of tract is owned in fee by John Bunting
Address Sistersville, W. Va.
Mineral rights are owned by same
Address same
Drilling commenced June - 1952
Drilling completed
Date Shot From To
With
Open Flow /10ths Water in Inch
/10ths Merc. in Inch
Volume Cu. Ft.
Rock Pressure lbs. hrs.
Oil bbls., 1st 24 hrs.
WELL ACIDIZED
WELL FRACTURED

Casing and Tubing	Used in Drilling	Left in Well	Packers
Size			
16			Kind of Packer
13			
10			Size of
8¼	350'	350'	
6⅝	1000'	1000'	Depth set
5 3/16	1600'	1600'	
3			Perf. top
2			Perf. bottom
Liners Used			Perf. top
			Perf. bottom

CASING CEMENTED SIZE No. Ft. Date

COAL WAS ENCOUNTERED AT FEET INCHES
FEET INCHES FEET INCHES
FEET INCHES FEET INCHES

RESULT AFTER TREATMENT
ROCK PRESSURE AFTER TREATMENT
Fresh Water Feet Salt Water Feet

Formation	Color	Hard or Soft	Top	Bottom	Oil, Gas or Water	Depth	Remarks
Drilled 11-foot in Injun Sand							
TOTAL DEPTH 1810'							

RECEIVED JUN 1959 DIV. OF MINES WEST VIRGINIA

(over)