





9500523P

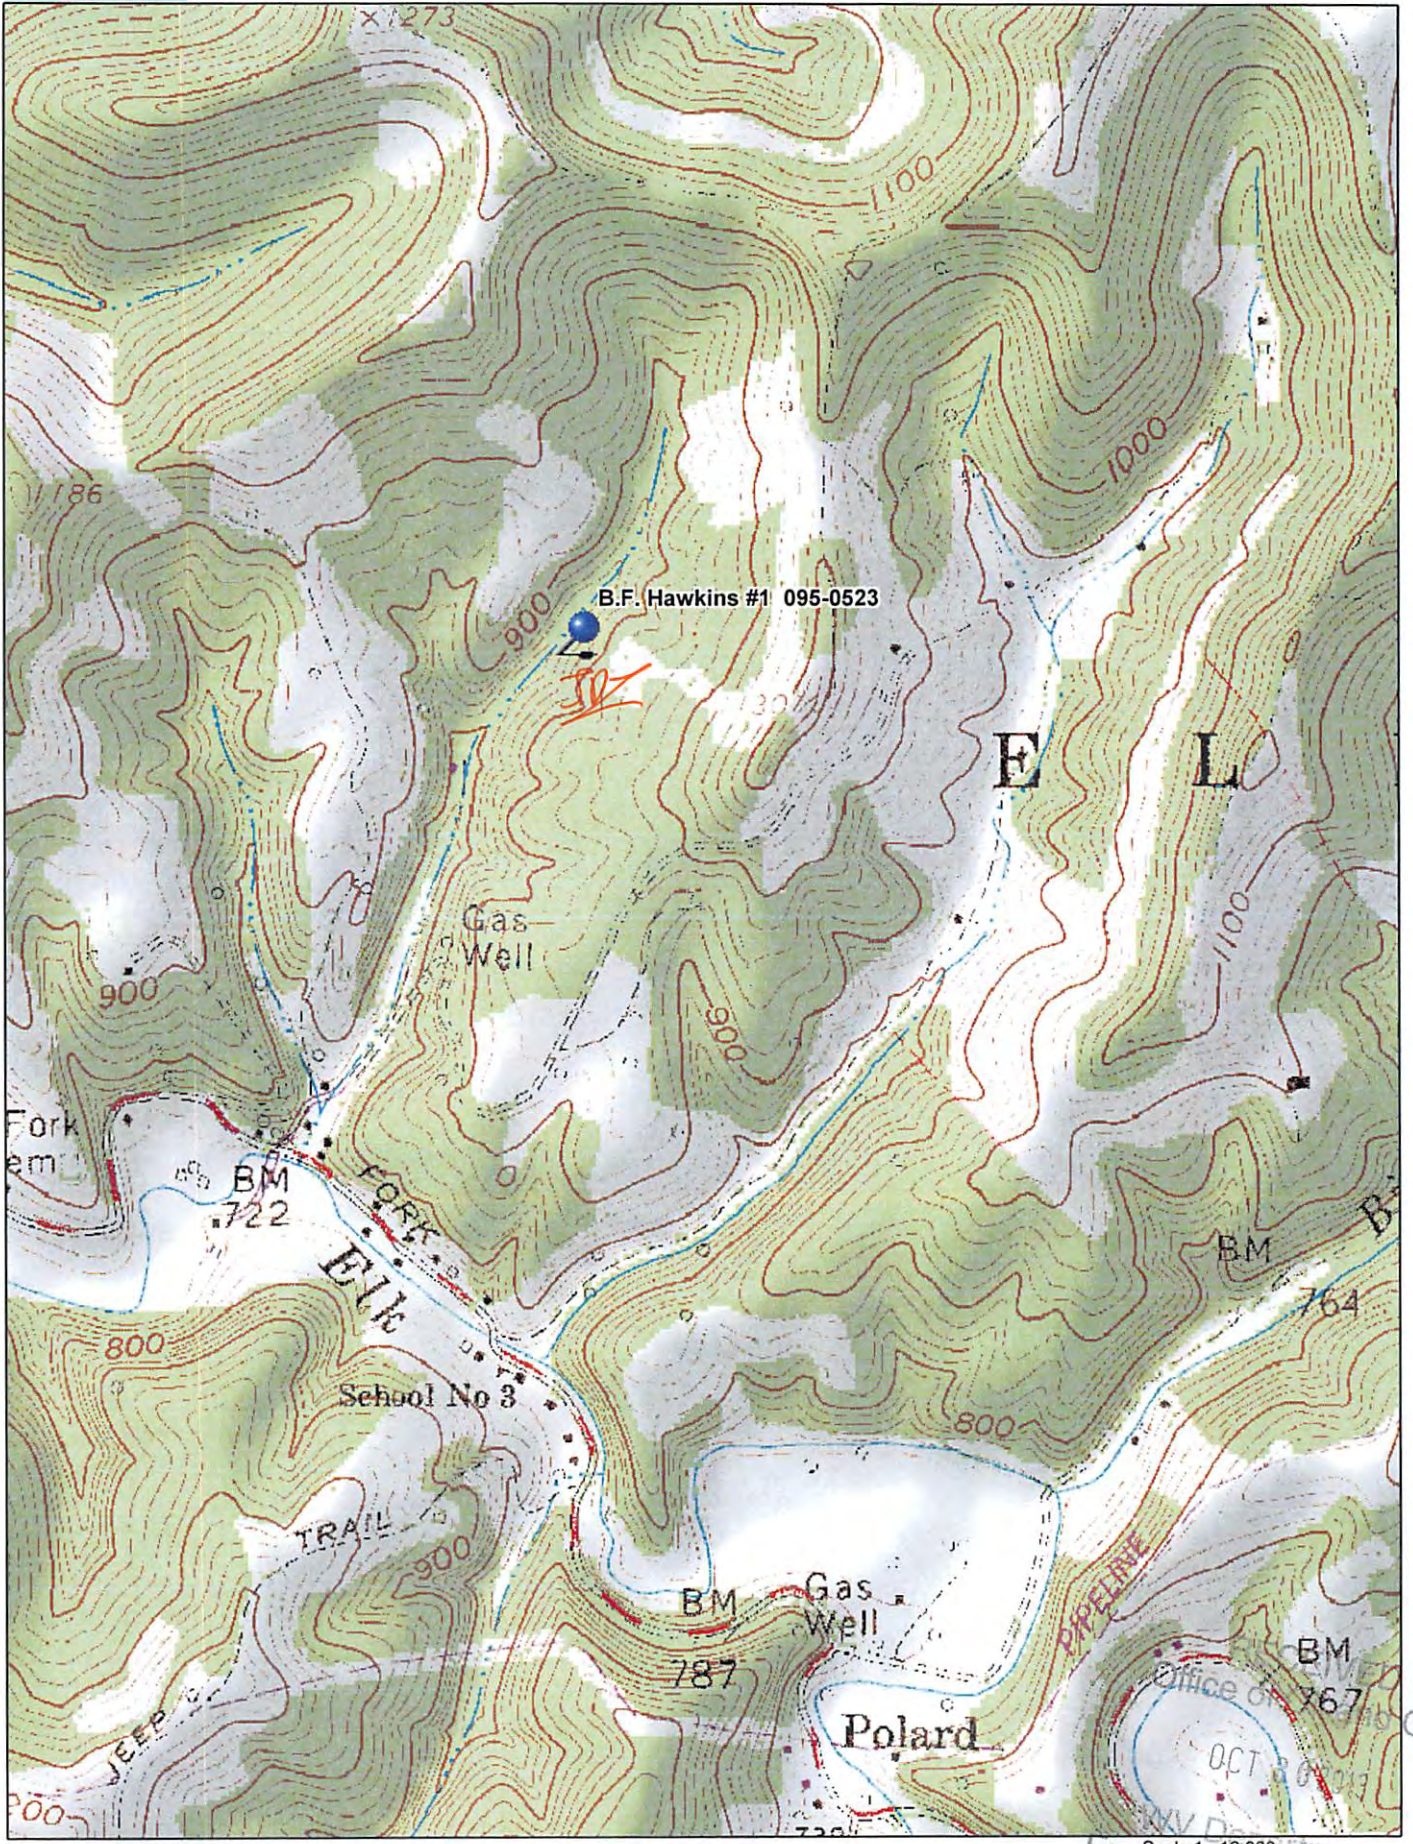

Data use subject to license.  
 © DeLorme. XMap® 7.  
 www.delorme.com

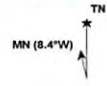

Scale 1 : 12,000  
 0 200 400 600 800 1000  
 0 100 200 300 400 500  
 1" = 1,000.0 ft Data Zoom 13-5

Environment of  
 Protection  
 Office of  
