

9500631 P

WW-7  
8-30-06



West Virginia Department of Environmental Protection  
Office of Oil and Gas  
**WELL LOCATION FORM: GPS**

API: 47-095-0631 WELL NO.: 4

FARM NAME: Joseph Williams

RESPONSIBLE PARTY NAME: Triad Hunter, LLC

COUNTY: Tyler DISTRICT: Ellsworth

QUADRANGLE: Porters Falls

SURFACE OWNER: Jeffery A. and Cheryl A. Ferrell

ROYALTY OWNER: Jeffery A. and Cheryl A. Ferrell et al

UTM GPS NORTHING: 4374617.7669336

UTM GPS EASTING: 512720.18702141 GPS ELEVATION: 1028'

The Responsible Party named above has chosen to submit GPS coordinates in lieu of preparing a new well location plat for a plugging permit or assigned API number on the above well. The Office of Oil and Gas will not accept GPS coordinates that do not meet the following requirements:

- Datum: NAD 1983, Zone: 17 North, Coordinate Units: meters, Altitude: height above mean sea level (MSL) – meters.
- Accuracy to Datum – 3.05 meters
- Data Collection Method:  
Survey grade GPS \_\_\_\_ : Post Processed Differential \_\_\_\_  
Real-Time Differential \_\_\_\_  
Mapping Grade GPS X : Post Processed Differential X  
Real-Time Differential \_\_\_\_

Received  
Office of Oil & Gas  
APR 23 2015

4. Letter size copy of the topography map showing the well location.

I the undersigned, hereby certify this data is correct to the best of my knowledge and belief and shows all the information required by law and the regulations issued and prescribed by the Office of Oil and Gas.


Ben Smeltzer  
Signature

Geologist  
Title

4/15/2013  
Date

06/26/2015




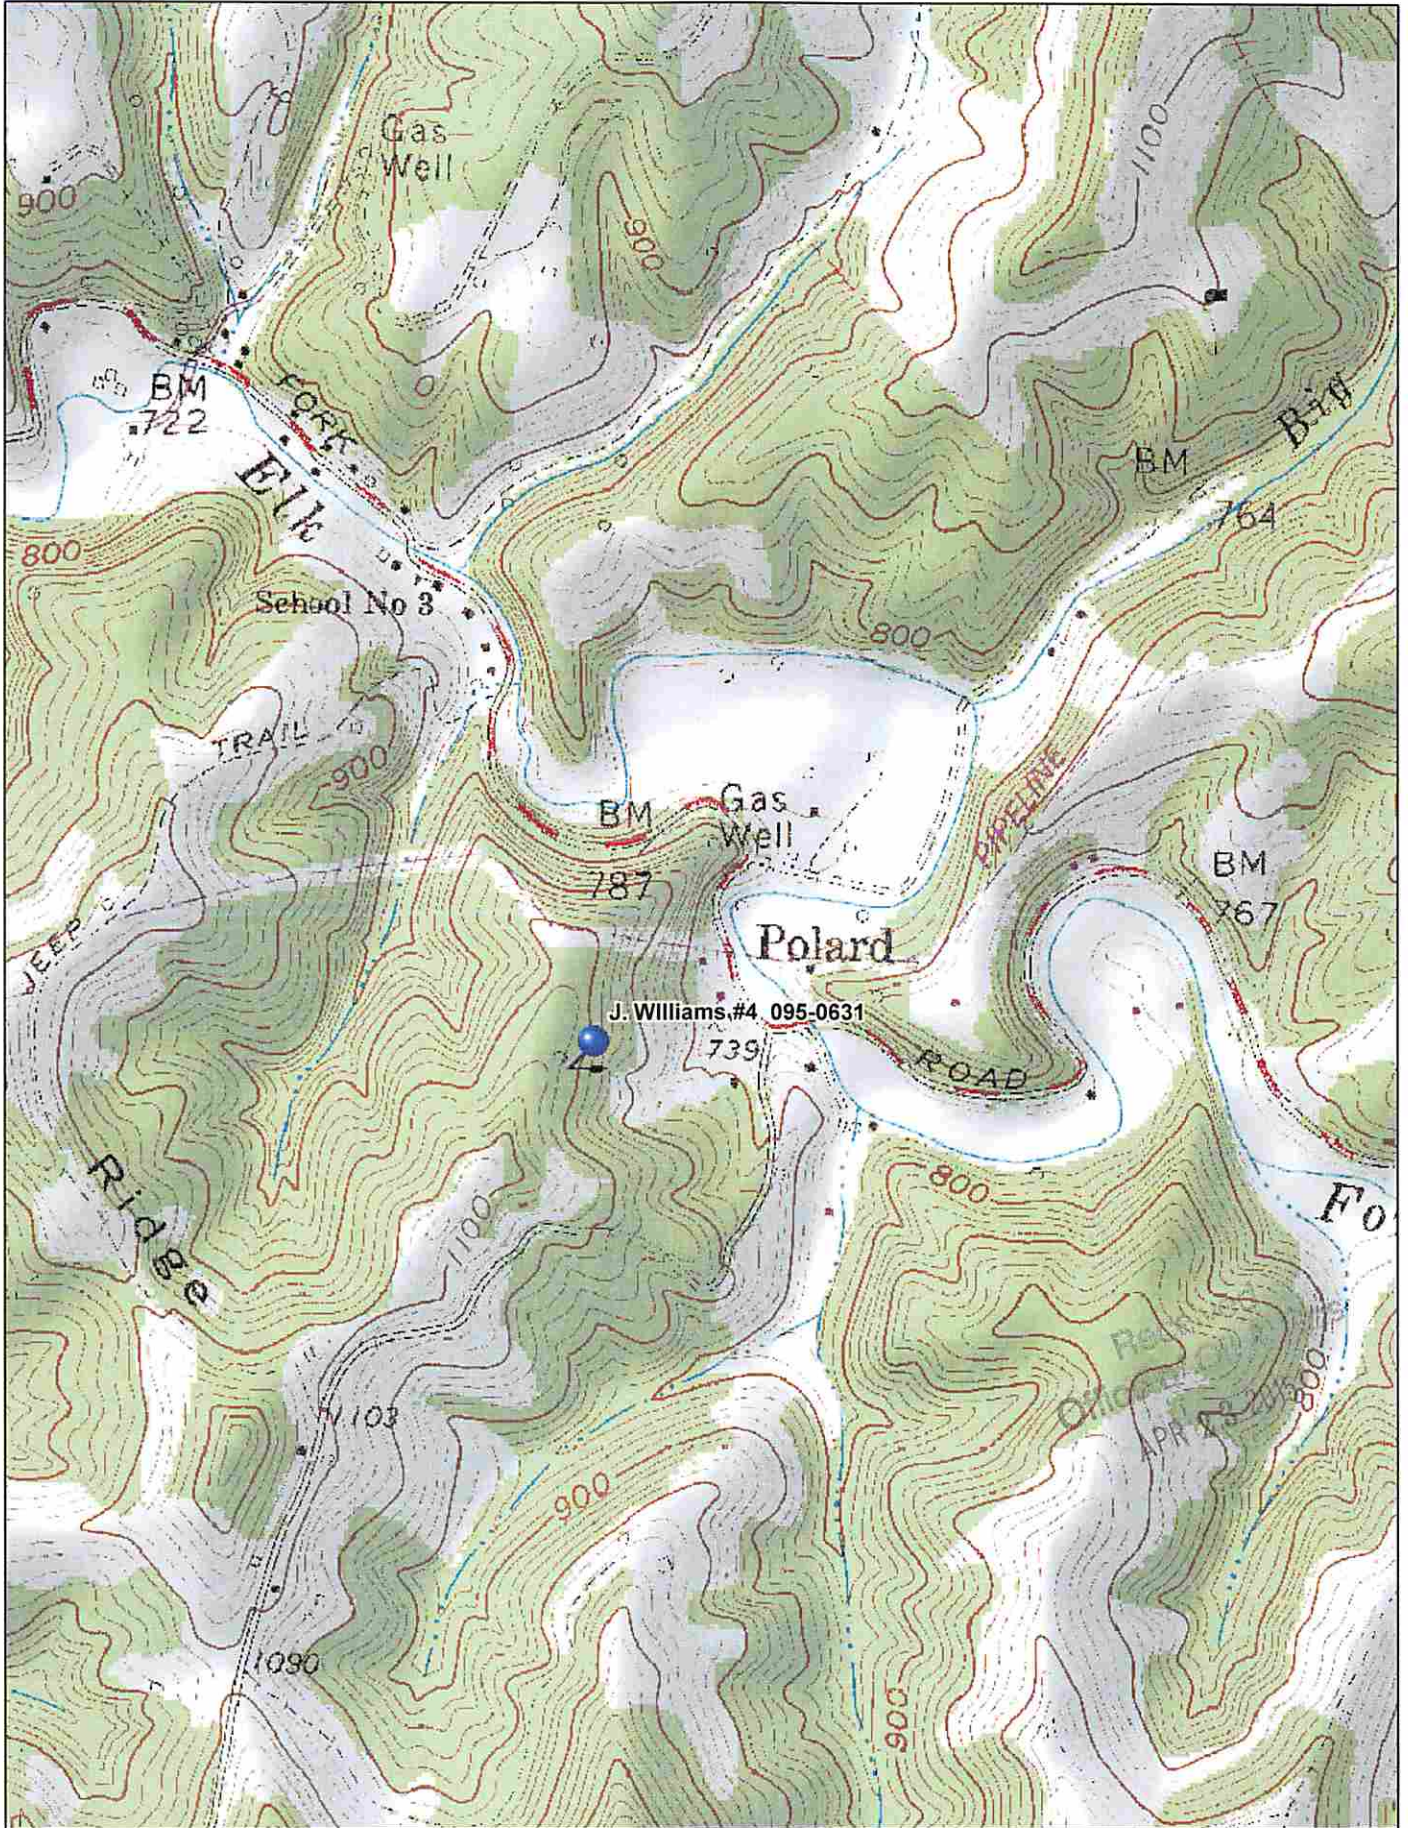

Data use subject to license.

© DeLorme. XMap® 7.

www.delorme.com

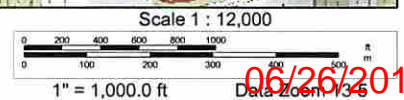

06/26/2015

Date Zoom 13.6