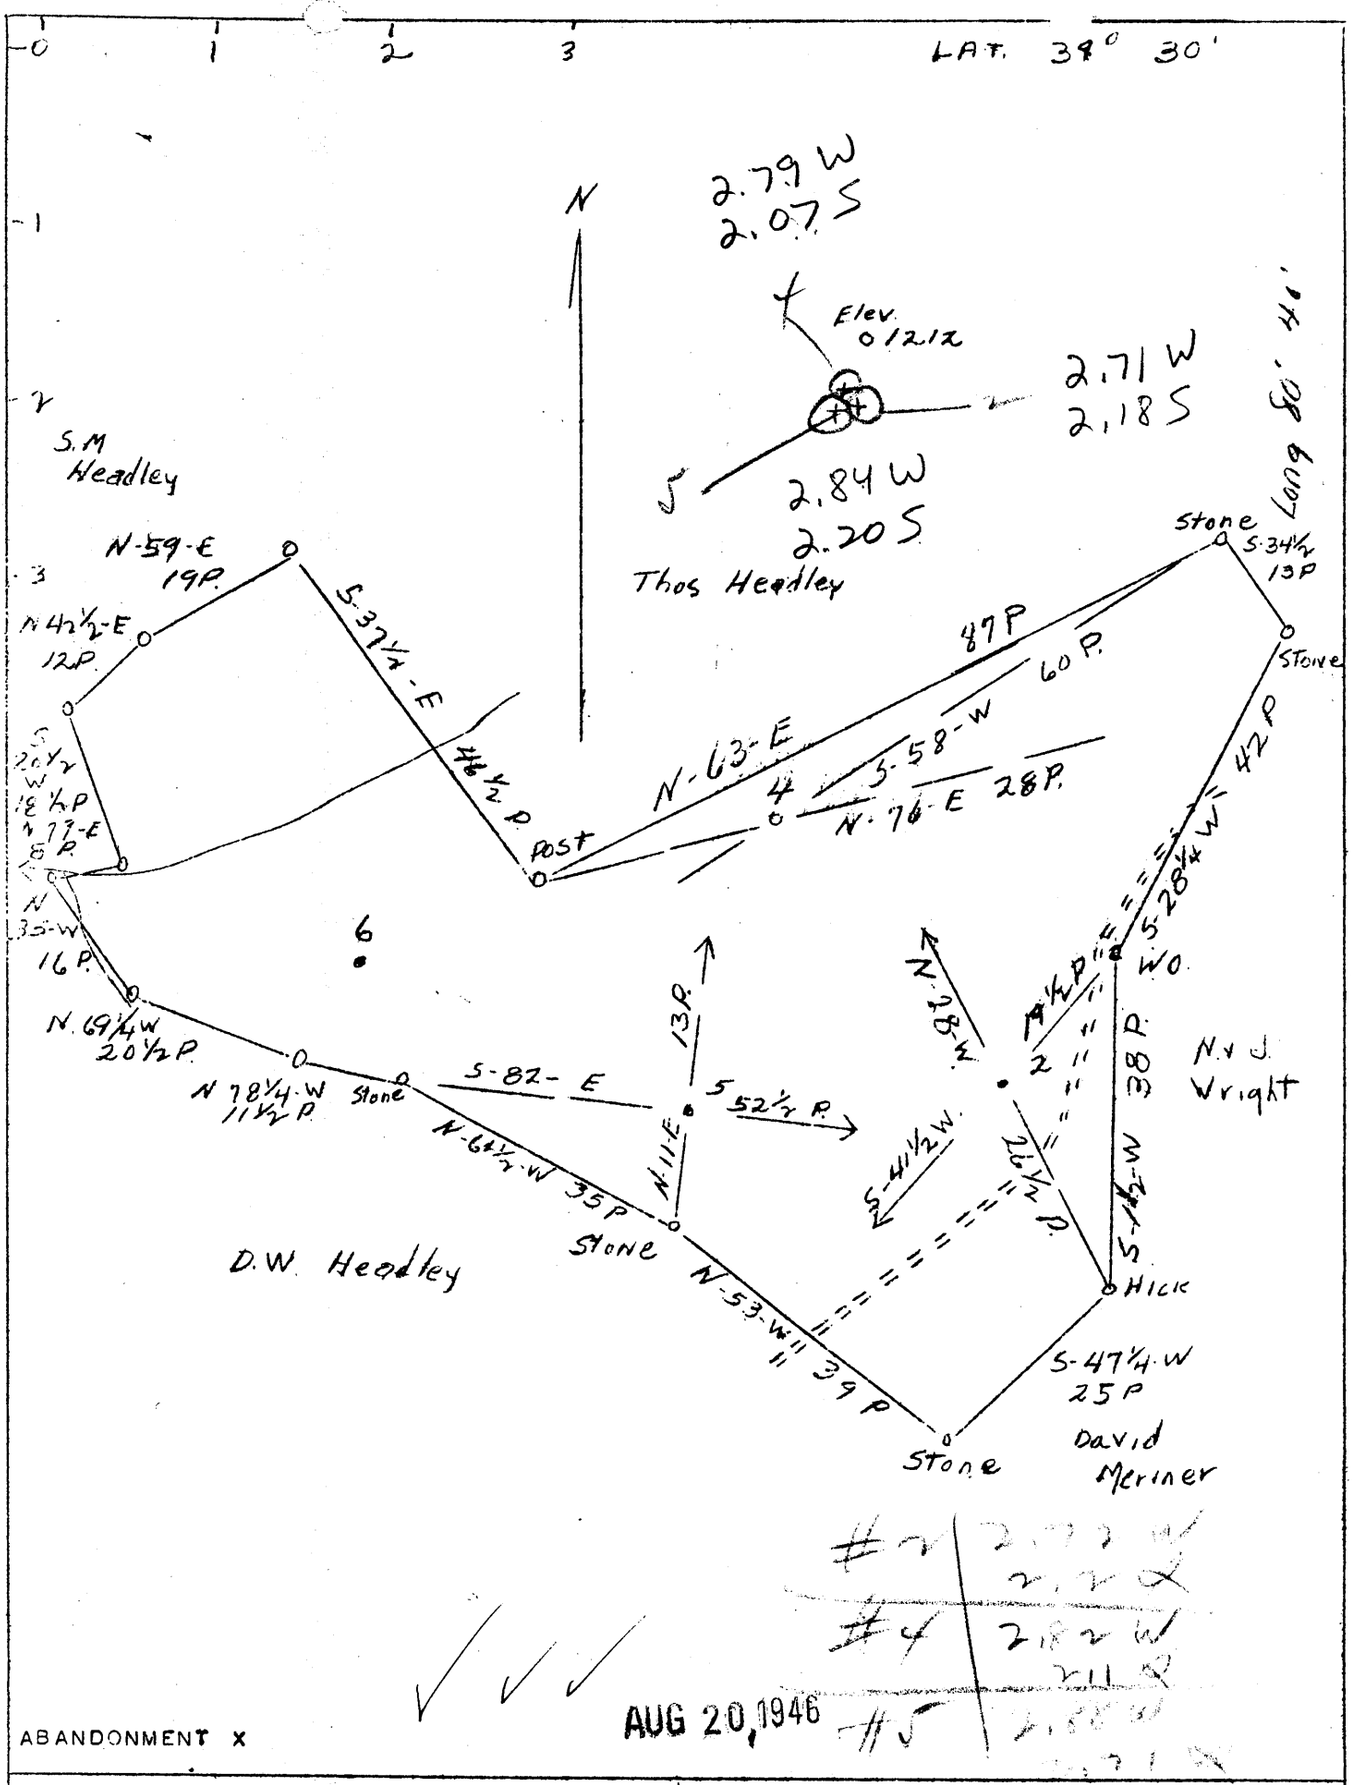

ABANDONMENT X

AUG 20, 1946

COMPANY AMERICAN OIL DEVELOPMENT CO.
ADDRESS SISTERSVILLE, W. VA.
FARM EL M. HEADLEY
TRACT ACRES 45 LEASE NO.
WELL (FARM) NO. 2, 4, & 5 SERIAL NO.
ELEVATION (SL) 2-1223.01 4-1116.68 5-1038.46
QUADRANGLE CENTERPOINT
COUNTY TYLER DISTRICT MC ELROY
ENGINEER J. S. HAUGHT
ENGINEER'S REG. NO. COUNTY SURVEYOR TYLER COUNTY
FILE NO. DRAWING NO.
DATE 7/20/46 SCALE 20 RDS-1"

STATE OF WEST VIRGINIA
DEPARTMENT OF MINES
OIL AND GAS DIVISION
CHARLESTON
WELL LOCATION MAP

NOW 663

FILE NO. TYL-397A; NO. 2;
TYL-398A, NO. 4; 399A, NO. 5

+ DENOTES LOCATION OF WELL ON U.S. TOPOGRAPHIC MAPS, SCALE 1 TO 62,500, LATITUDE AND LONGITUDE LINES BEING REPRESENTED BY BORDER LINES AS SHOWN.

- DENOTES ONE INCH SPACES ON BORDER LINE OF ORIGINAL TRACING.

EL M. HEADLEY NO. 2, 4 & 5 — AMERICAN OIL DEV. CO. — TYL-397-8-9

DRILLER'S RECORD

Previously Requested, but NOT AVAILABLE

DATE: _____

Em Headley #4 (was 30398)

095	663
COUNTY	PERMIT

WVGES O&G Data System Listing: 2/25/1991 NOTE: All well depths measured in feet from surface datum.

ID: COUNTY: 095 (TYLER) PERMIT: 663 SFX: 0 (New Location) REASSIGNED ID #: ()

COMPLETION INFO: ELEVATION: COMP REC FLAG: (not@DOE/OGIS)
ELEVATION TYPE: G RIG TYPE: 0
(Ground Lvl) (unknown)

CLASSIFICATION: DATES: MM/DD/YYYY
INITIAL: (unclassified) SPUD: / / WELL TYPE: 0
FINAL: (unclassified) COMP: / / (Unknown)
FIELD: 000 BATCH: / / CMPL METH: 0
(Unnamed) YEAR RPTD: 1978 (unknown)

OPEN FLOW: GAS-BEFORE TREATMENT: (MCFPD) OIL-BEFORE TREATMENT: (BOPD)
GAS-AFTER TREATMENT: (MCFPD) OIL-AFTER TREATMENT: (BOPD)

ROCK PRESSURE: NATURAL (PSI): 0 TIME (NATURAL, IN HOURS): 0
TREATED (PSI): 0 TIME (TREATED, IN HOURS): 0

DEPTHS: TOTAL FTG: 0 NEW FTG: 0 EXPL FTG: 0

DEEPEST FM: AT TOTAL DEPTH: TESTED:
() ()

* LOCATION INFO: TAX DST:

	DEGREES	MINUTES	MILES
7.5' LATITUDE:	00	00.0	0.00S
LONGITUDE:	00	00.0	0.00W
QUADRANGLE:			
15' LATITUDE:	00	00	0.00S
LONGITUDE:	00	00	0.00W
QUADRANGLE:			
5' SECT:			

UTM: EASTING: NORTHING:
COORDINATE DIGITIZED (Y/N):

* OWNER INFO: STATUS: C (Cmpltd) DATE: / /
SURFACE OWNER: E M Headley 4
OIL&GAS OWNER:
COMPANY NUMBER:
OPERATOR: 0721 (Quaker State)

MECHANICAL LOG INFO: STATUS: RANGE OF INTERVALS: 0- 2279 DEEPEST FM LOGGED:
LOGS AVAILABLE: GR,* MICROFILM ROLL NUMBER(S): 57,88
COMMENT: on #57 as 293A
LOG TYPES: GR-gamma ray; D-density; T-temperature; I-induction; N-neutron; S-sonic, *Other types not noted

PRODUCTION INFO:

GAS (VOLUMES IN MCF):

YEAR	REPORTING OPER	STS	JAN	FEB	MAR	APR	MAY	JUN	JUL	AUG	SEP	OCT	NOV	DEC	ANNUAL	PRESSURES: FLOW	SHUT
1981	Quaker State		0	0	0	0	0	0	0	0	0	0	0	0	0	0	0
1982	Quaker State		0	0	0	0	0	0	0	0	0	0	0	0	0	0	0
1983	Quaker State	G	0	0	0	0	0	0	0	0	0	0	0	0	0	?	0
1988	Haught	W	0	0	0	0	0	0	0	0	0	0	0	0	0	?	?

OIL (VOLUMES IN BBL):

YEAR	REPORTING OPER	STS	JAN	FEB	MAR	APR	MAY	JUN	JUL	AUG	SEP	OCT	NOV	DEC	ANNUAL
1981	Quaker State		70	57	72	76	64	105	71	58	73	83	73	56	858
1982	Quaker State		58	70	72	80	88	75	66	78	76	55	49	55	821
1983	Quaker State	G	43	43	43	7	94	13	34	61	104	0	57	3	479
1988	Haught	W	46	0	54	0	0	86	44	0	0	0	0	0	230

DAYS ON LINE:

YEAR	REPORTING OPER	STS	JAN	FEB	MAR	APR	MAY	JUN	JUL	AUG	SEP	OCT	NOV	DEC	ANNUAL
1981	Quaker State		?	?	?	?	?	?	?	?	?	?	?	?	365
1982	Quaker State		31	28	31	30	31	30	31	31	30	31	30	31	365
1983	Quaker State	G	?	?	?	?	?	?	?	?	?	?	?	?	?
1988	Haught	W	?	?	?	?	?	?	?	?	?	?	?	?	?